

(Vance Pit) #2 Well

Registration No. GR

1280

8 1962

Certificate No. GR

4132

Registration Statement

OF CLAIMANT OF RIGHT TO APPROPRIATE GROUND WATER

TO THE STATE ENGINEER OF OREGON:

I, Board of County Commissioners
of Multnomah County Courthouse County of Multnomah
(Mailing address)
State of Oregon, do hereby make application for a certificate of registration as evidence
of a right to appropriate ground water.

1. Source from which water is withdrawn is pump well
(Flowing well, pump well, infiltration trench, or tunnel)
2. Location is: two miles northwesterly from Gresham, Oregon
(Approximate distance and direction from nearest city or town)

and is more particularly described as follows:

(a) S 77° 46' E 1960' + from 1/4 corner on W Line of Section 5
(Give distance and bearing to corner of section or other legal subdivision)
being within NW 1/4, NE 1/4 of SW 1/4 of Sec. 5, Twp. 1-S, Rge. 3-E
(Smallest legal subdivision) (N. or S.) (E. or W.)

or (b) within limits of recorded platted property, town or city:
in Lot 44, Block V of Vance
(Name of plat or addition)
County of Multnomah
(If within city or town, give name)

3. Construction Work was begun on Dec, 1941; was completed on July 1942
(Date) (Date)
and the ground water claimed was first used for the purposes set out below on July 1942
(Date)

since which time the water has been used intermittently
(Continuously or intermittently)
from July 1942 to present time
(Date) (Date)

4. Quantity of water claimed and used is 400 gallons per minute; 53,333.33 acre
feet per year.

5. Purpose or Purposes for which water is used Industrial
washing crushed rock - county operations
(Domestic, irrigation, municipal, manufacturing, industrial, etc.)

6. Description of Well: Depth 200 feet. Type Drilled
(Dug or drilled)
diameter 12 inches, Elevation of ground at well site 263 feet, mean sea level.
(As near as known)
Depth to water table 44 feet.

7. Capacity of Well: 400 g.p.m. with 0 feet drawdown.
g.p.m. with feet drawdown.

Date of test July 20, 1942


If Flowing Well: Measured discharge g.p.m. on (Date)

Shut-in pressure at ground surface lbs. per sq. in. on (Date)

Water is controlled by (Cap, valve, etc.)

Section 5

Township 4-S Range 3-E W.M. North

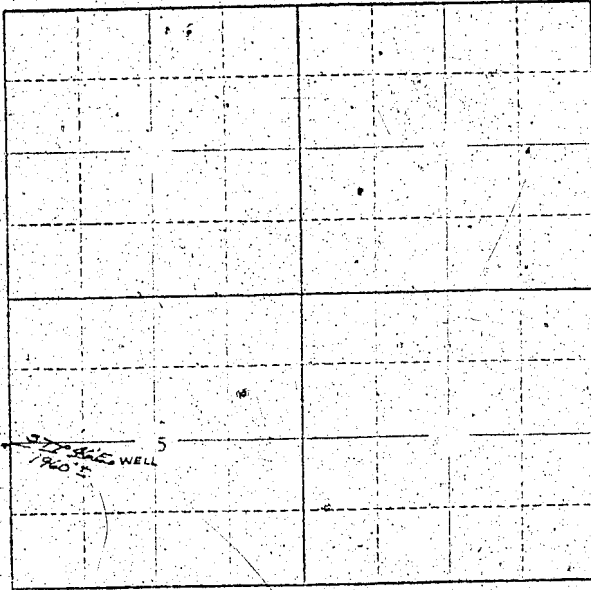

Locate well and acreage of irrigated land on plat.

Scale: 2" = 1 Mile

STATE OF OREGON

County of Multnomah

ss.






NOTARY PUBLIC FOR OREGON

(Notary Public)

(SEAL)

CERTIFICATE OF REGISTRATION

STATE OF OREGON

County of Marion

ss.

This is to certify that the foregoing Registration Statement was received in the office of the State Engineer on the 8th day of August, 1962, at 8:00 o'clock A.M. and has been duly recorded in said office in Book No. 17 of Registration Statements on page GR-4132

Witness my hand this 16th day of October, 1962

(State Engineer)

By

(Deputy)

\$20.00

GR 4132