REGISTRATION NO. GR-429

Registration Statement

CERTIFICATE NO. GR 415

OF CLAIMANT OF RIGHT TO APPROPRIATE GROUND WATER

(Under Chapter 708, Oregon Laws 1955.)

TO THE STATE ENGINEER OF OREGON:

I, Dave H. Jordan,

of Route 4, Box 159, Albany County of Benton

State of Oregon, do hereby make application for a certificate of registration as evidence of a right to appropriate ground water.

1. **Source** from which water is withdrawn is pump well (Flowing well, pump well, infiltration trench, or tunnel)

2. **Location** is: 6 miles North of Albany (Approximate distance and direction from nearest city or town);

and is more particularly described as follows:

(a) 790' - South 77° 30' west of 1½" axle shaft. Which is the SE Corner of Smiley Conn DLC (Give distance and bearing to corner of section or other legal subdivision)

being within NW¼ of NW¼ (Smallest legal subdivision) of Sec. 14, Twp. 10 S (N. or S.), Rge. 4 W (E. or W.) WM

or (b) within limits of recorded platted property, town or city:

in Lot ....., Block ..... of ..... (Name of plat or addition)

..... (If within city or town, give name) County of .....

3. **Construction Work** was begun on 1942 (Date); was completed on 1942 (Date)

and the ground water claimed was first used for the purposes set out below on 1942 (Date),

since which time the water has been used intermittently to 1947, continuously since. (Continuously or intermittently)

from 1947 (Date) to Oct. 1956 (Date)

4. **Quantity** of water claimed and used is 160 to 240 gallons per minute; 5.0 acre feet per year.

5. **Purpose or Purposes** for which water is used irrigation, ~~domestic~~

..... (Domestic, irrigation, municipal, manufacturing, industrial, etc.)

6. **Description of Well:** Depth 30 feet. Type dug to 8', drilled balance of depth (Dug or drilled)

diameter 8" inches. Elevation of ground at well site 180 (As near as known) feet, mean sea level.

Depth to water table 18 feet.

7. **Capacity of Well:** 230 g.p.m. with 10 feet drawdown. , June ave.

160 g.p.m. with 15 feet drawdown. min. capy.

Date of test .....

If Flowing Well: Measured discharge ..... g.p.m. on ..... (Date)

Shut-in pressure at ground surface ..... lbs. per sq. in. on ..... (Date)

Water is controlled by ..... (Cap, valve, etc.)

8. **Casing:** (Give diameter, commercial specifications and depth below ground surface of each casing size.)

8 ft. inch diameter Dug from Surface to 8 feet

8 inch diameter Steel from 8 to 30 feet

inch diameter from to feet

inch diameter from to feet

Describe and show depth of shoe, plug, adapter, liner or other details:

9. **Perforated Casings or Screens:**

perforated, size and depth unknown from to
(Number per foot and size of perforations, or describe screen)

from to

from to

from to

10. **Log of Well:** (Describe each stratum or formation clearly, indicate if water bearing, and give thickness and depth as indicated.)

MATERIAL	Thickness (Feet)	Depth to Bottom (Feet)
unknown, driller unknown		

GR - 415A

If log of well is not available, give name and address of driller. unknown

11. **Infiltration Trench:** Covered or open

Dimensions: Length ..... ft. Minimum depth ..... ft. Maximum depth ..... ft.

Bottom width ..... ft. Discharge ..... g.p.m. Date of test .....

12. **Tunnel:** Type of lining .....

Dimensions: .....
(Length, course, and cross sectional size)

Position of water bearing stratum with reference to portal of tunnel .....

Log of tunnel: (Preceding table for log of well may be used, if desired. Give footage from portal and character of materials, as pertinent.)

13. **Pumping Equipment:**

(a) Pump 4" x 3" Fairbanks Morse (Make, type and size) Capacity 250 g.p.m.

(b) Motor GE 3 phase 15 H.P. (Type and horsepower)

14. Location of area irrigated or to be irrigated, or place of use if for purposes other than irrigation.

Township North or South	Range E. or W. of Willamette Meridian	Section	Forty-acre Tract	Number Acres To Be Irrigated	Date of Reclamation
10 S	4 W	15	SE¼ NE¼	6 7	1942
10 S	4 W	14	SW¼ NW¼	17 8	"
10 S	4 W	14	SE¼ NW¼	15 8	"
				Total 40 ac	
Approximately 12 acres irrigated every year. Balance irrigated every second or third year depending upon rotation.					

15. If the ground water supply is supplemental to an existing water supply, identification of any application for a permit, permit, certificate or adjudicated right to appropriate water made or held by the registrant.

Township 10 S Range 4 W, W.M.

North

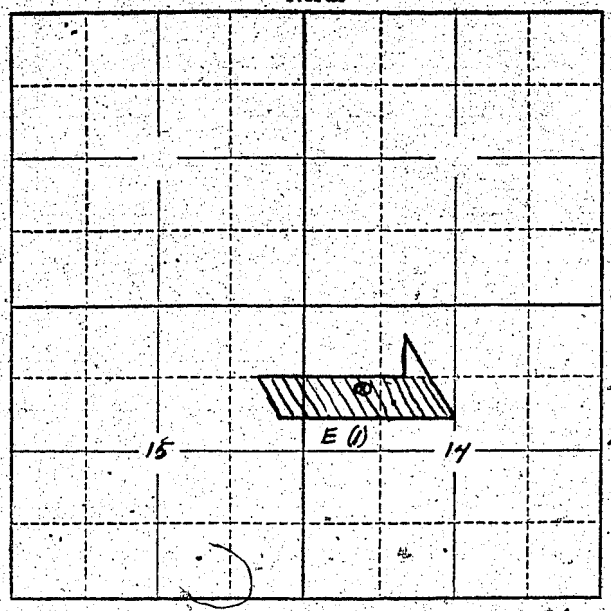

Locate well and acreage of irrigated land on plat.

Scale: 2" = 1 Mile

STATE OF OREGON
County of Marion } ss.

I, Dave H. Jordan, being first duly sworn, do hereby certify that I have read the foregoing Registration Statement and that all of the items therein contained are true to the best of my knowledge and belief.

Dave H. Jordan
(Signature of Registrant)

Subscribed and sworn to before me this 4th day of April, 19 57

My commission expires Sept 8, 1960 Shirley L. Shiels
(Notary Public)

(SEAL)

CERTIFICATE OF REGISTRATION

STATE OF OREGON
County of Marion } ss.

This is to certify that the foregoing Registration Statement was received in the office of the State Engineer on the 4th day of April, 19 57, at 9:00 o'clock A. M. and has been duly recorded in said office in Book No. 3 of Registration Statements on page GR-415 C

xx ~~Construction shall be completed by x-x-x-x-x-x-x-x-x-x-x-x-x-x and the water completely applied to beneficial use by x-x-x-x-x-x-x-x-x-x-x-x-x~~ xx

Witness my hand this 26th day of June, 19 57.

Lewis A. Stanley
(State Engineer)

$16.50

By
(Deputy)

GR - 415 C