

Registration Statement

OF CLAIMANT OF RIGHT TO APPROPRIATE GROUND WATER (Under Chapter 708, Oregon Laws 1955.)

TO THE STATE ENGINEER OF OREGON:

I, Municipal City of Amity
of Amity County of Yamhill
State of Oregon, do hereby make application for a certificate of registration as evidence of a right to appropriate ground water.

1. Source from which water is withdrawn is Pump well #1
(Flowing well, pump well, infiltration trench, or tunnel)
2. Location is: in city park - Watts addition
(Approximate distance and direction from nearest city or town)

and is more particularly described as follows:

(a) 1820 feet east and 470 feet north from SW corner of section 20
(Give distance and bearing to corner of section or other legal subdivision)
being within S 1/4 of SW 1/4 of Sec. 20, Twp. 5S, Rge. 4W
(Smallest legal subdivision) (N. or S.) (E. or W.)

or (b) within limits of recorded platted property, town or city: of Amity
in Lot Park, Block _____ of Watt Addition
(Name of plat or addition)

City of Amity County of Yamhill
(If within city or town, give name)

3. Construction Work was begun on April 1951; was completed on July 1951
(Date) (Date)
and the ground water claimed was first used for the purposes set out below on July 1951
(Date)
since which time the water has been used Intermittently
(Continuously or Intermittently)
from July 1951 to Present 1957
(Date) (Date)

4. Quantity of water claimed and used is 6.5 gallons per minute; _____ acre feet per year.

5. Purpose or Purposes for which water is used Municipal use
(Domestic, irrigation, municipal, manufacturing, industrial, etc.)

6. Description of Well: Depth 94 feet. Type drilled
(Dug or drilled)
diameter 8 inches. Elevation of ground at well site 158 feet, mean sea level.
(As near as known)
Depth to water table 30 feet.

7. Capacity of Well: 60 g.p.m. with 60 feet drawdown.
_____ g.p.m. with _____ feet drawdown.

Date of test July 1951

If Flowing Well: Measured discharge _____ g.p.m. on _____
(Date)

Shut-in pressure at ground surface _____ lbs. per sq. in. on _____
(Date)

Water is controlled by _____
(Cap. valve, etc.)

8. Casing: (Give diameter, commercial specifications and depth below ground surface of each casing size.)

8 inch diameter *steel casing* from 0 to 94 feet
 inch diameter from to feet
 inch diameter from to feet
 inch diameter from to feet

Describe and show depth of shoe, plug, adapter, liner or other details:

9. Perforated Casings or Screens:

slots from 40 to 48
 (Number per foot and size of perforations, or describe screen)
 from 62 to 86
 from 91 to 96
 from to

10. Log of Well: (Describe each stratum or formation clearly, indicate if water bearing, and give thickness and depth as indicated.)

MATERIAL	Thickness (Feet)	Depth to Bottom (Feet)
<i>Top soil</i>	<i>0</i>	<i>8</i>
<i>Clay, varied color</i>	<i>8</i>	<i>40</i>
<i>sandy, loam</i>	<i>40</i>	<i>45</i>
<i>basalt, weathered</i>	<i>45</i>	<i>62</i>
<i>silt with boulders (basalt) ^{water} bearing</i>	<i>62</i>	<i>86</i>
<i>rock (tight)</i>	<i>86</i>	<i>91</i>
<i>gravel water bearing</i>	<i>91</i>	<i>96</i>

If log of well is not available, give name and address of driller. Wilcox

11. Infiltration Trench: Covered or open

Dimensions: Length ft. Minimum depth ft. Maximum depth ft.

Bottom width ft. Discharge g.p.m. Date of test

12. Tunnel: Type of lining

Dimensions:
(Length, course, and cross sectional size)

Position of water bearing stratum with reference to portal of tunnel

Log of tunnel: (Preceding table for log of well may be used, if desired. Give footage from portal and character of materials, as pertinent.)

13. Pumping Equipment:

(a) Pump Fairbanks-Morse Capacity 150 g.p.m.
(Make, type and size)


(b) Motor 7 H.P.
(Type and horsepower)

14. Location of area irrigated or to be irrigated, or place of use if for purposes other than irrigation.

Township North or South	Range E. or W. of Willamette Meridian	Section	Forty-acre Tract	Number Acres To Be Irrigated	Date of Reclamation
T55	R4W	20	SW ¹ / ₄ of SW ¹ / ₄	Municipal Use	1951
"	"	"	SE ¹ / ₄ of SW ¹ / ₄	" "	"
"	"	"	SW ¹ / ₄ of SE ¹ / ₄	" "	"
"	"	"	SE ¹ / ₄ of SE ¹ / ₄	" "	"
"	"	"	NE ¹ / ₄ of SW ¹ / ₄	" "	"
"	"	"	NW ¹ / ₄ of SE ¹ / ₄	" "	"
"	"	29	NE ¹ / ₄ of NW ¹ / ₄	" "	"
"	"	"	NW ¹ / ₄ of NE ¹ / ₄	" "	"
"	"	"	NE ¹ / ₄ of NE ¹ / ₄	" "	"
"	"	"	SE ¹ / ₄ of NE ¹ / ₄	" "	"

15. If the ground water supply is supplemental to an existing water supply, identification of any application for a permit, permit, certificate or adjudicated right to appropriate water made or held by the registrant.

Township Range W.M.
North

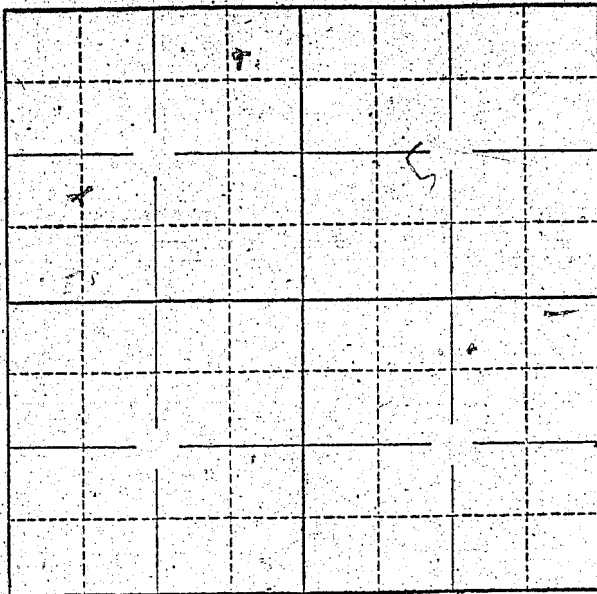

Locate well and acreage of irrigated land on plat.

Scale: 2" = 1 Mile

STATE OF OREGON

County of

} ss.

I, Iran R. Shields, being first duly sworn, do hereby certify that I have read the foregoing Registration Statement and that all of the items therein contained are true to the best of my knowledge and belief.

City of Unity, by Iran R. Shields
(Signature of Registrant)

Subscribed and sworn to before me this 8th day of April, 1957.

My commission expires

(Notary Public)

(SEAL)

See Page GR-417-G for
CERTIFICATE OF REGISTRATION

STATE OF OREGON

County of Marion

} ss.

~~This is to certify that the foregoing Registration Statement was received in the office of the State Engineer on the X-X-X day of X-X-X-X-X-X-X-X, 19-X-X-X-X-X-X-X-X o'clock X-X-X AM and has been duly recorded in said office in Book No. X-X-X-X-X-X-X-X of Registration Statements on page X-X-X-X-X.~~

~~Construction shall be completed by X-X-X-X-X-X-X-X, 19-X-X-X-X and the water completely applied to beneficiaries by X-X-X-X-X-X-X-X, 19-X-X-X-X.~~

Witness my hand this day of 19.....

(State Engineer)

By

(Deputy)

GR - 417 C

Registration Statement

OF CLAIMANT OF RIGHT TO APPROPRIATE GROUND WATER

(Under Chapter 708, Oregon Laws 1955.)

TO THE STATE ENGINEER OF OREGON:

I, City of Amity

of Amity County of Yamhill

State of Oregon, do hereby make application for a certificate of registration as evidence of a right to appropriate ground water.

1. Source from which water is withdrawn is Pump well #2
(Flowing well, pump well, infiltration trench, or tunnel)

2. Location is: across Salt Creek west of Amity
(Approximate distance and direction from nearest city or town)

and is more particularly described as follows:

(a) 380 feet east and 340 feet north from SW corner of section 20
(Give distance and bearing to corner of section or other legal subdivision)

being within SW 1/4 of SW 1/4 of Sec. 20, Twp. T5 S, Rge. 4 West
(Smallest legal subdivision) (N. or S.) (E. or W.)

or (b) within limits of recorded platted property, town or city:

in Lot _____, Block _____ of _____
(Name of plat or addition)

County of Yamhill
(If within city or town, give name)

3. Construction Work was begun on July 1953, was completed on July 1953
(Date) (Date)

and the ground water claimed was first used for the purposes set out below on Sept 1953
(Date)

since which time the water has been used Intermittently
(Continuously or intermittently)

from June to Dec each year
(Date) (Date)

4. Quantity of water claimed and used is 60 gallons per minute; _____ acre feet per year.

5. Purpose or Purposes for which water is used Municipal use
(Domestic, irrigation, municipal, manufacturing, industrial, etc.)

6. Description of Well: Depth 126 feet. Type drilled
(Dug or drilled)

diameter 10 inches. Elevation of ground at well site 158 feet, mean sea level.
(As near as known)

Depth to water table 20 feet.

7. Capacity of Well: 60 g.p.m. with 97 feet drawdown.

_____ g.p.m. with _____ feet drawdown.

Date of test _____

If Flowing Well: Measured discharge _____ g.p.m. on _____
(Date)

Shut-in pressure at ground surface _____ lbs. per sq. in. on _____
(Date)

Water is controlled by _____
(Cap, valve, etc.)


8. Casing: (Give diameter, commercial specifications and depth below ground surface of each casing size.)

10 inch diameter 12 inches above ground from 71 to 126 feet
 inch diameter from to feet
 inch diameter from to feet
 inch diameter from to feet

Describe and show depth of shoe, plug, adapter, liner or other details:

9. Perforated Casings or Screens:

$\frac{1}{8} \times 6$ " slats from 40 to 50
 (Number per foot and size of perforations, or describe screen)
 " from 62 to 75
 " from 88 to 94
 " from to

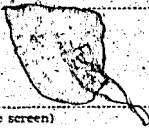

10. Log of Well: (Describe each stratum or formation clearly, indicate if water bearing, and give thickness and depth as indicated.)

MATERIAL	Thickness (Feet)	Depth to Bottom (Feet)
4 feet top soil		
36 feet Clay		
10 feet silt some seepage		
12 feet Fine sand and clay		
10 feet sand + gravel water bearing		
18 feet rock		
6 feet loose sand water bearing		
30 feet rock		

If log of well is not available, give name and address of driller. Wilcox Drilling Co.

McMinnville, Oregon-Three Mile Lane

11. Infiltration Trench: Covered or open _____

Dimensions: Length _____ ft. Minimum depth _____ ft. Maximum depth _____ ft.

Bottom width _____ ft. Discharge _____ g.p.m. Date of test _____

12. Tunnel: Type of lining _____

Dimensions: _____
(Length, course, and cross sectional size)

Position of water bearing stratum with reference to portal of tunnel _____

Log of tunnel: (Preceding table for log of well may be used, if desired. Give footage from portal and character of materials, as pertinent.)

13. Pumping Equipment:

(a) Pump Jacuzzi Model 7.5106a21 Turbine model Capacity set 60 g.p.m.
(Make, type and size)

(b) Motor 7 1/2 hp. 220 volt, 3phase Jacuzzi model
(Type and horsepower)


14. Location of area irrigated or to be irrigated, or place of use if for purposes other than irrigation.

Township North or South	Range E. or W. of Willamette Meridian	Section	Forty-acre Tract	Number Acres To Be Irrigated	Date of Reclamation
T5S	R4W	20	SW 1/4 of SW 1/4	Municipal Use	Sept. 1953
"	"	"	SE 1/4 of SW 1/4	" "	"
"	"	"	SW 1/4 of SE 1/4	" "	"
"	"	"	SE 1/4 of SE 1/4	" "	"
"	"	"	NE 1/4 of SW 1/4	" "	"
"	"	"	NW 1/4 of SE 1/4	" "	"
"	"	29	NE 1/4 of NW 1/4	" "	"
"	"	"	NW 1/4 of NE 1/4	" "	"
"	"	"	NE 1/4 of NE 1/4	" "	"
"	"	"	SE 1/4 of NE 1/4	" "	"

15. If the ground water supply is supplemental to an existing water supply, identification of any application for a permit, permit, certificate or adjudicated right to appropriate water made or held by the registrant.

Matthew Spring and Brieding Springs maine source of supply

Township 5S Range 4W, W.M.
North

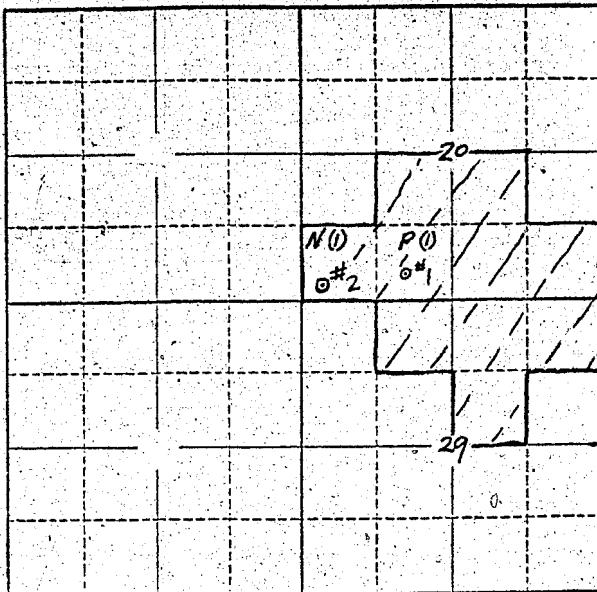

Locate well and acreage of irrigated land on plat.
Scale: 2" = 1 Mile

STATE OF OREGON

County of _____ } ss.

I, Evan R. Shields being first duly sworn, do hereby certify that I have read the foregoing Registration Statement and that all of the items therein contained are true to the best of my knowledge and belief.

(Signature of Registrant)

Subscribed and sworn to before me this 8th day of April, 1957.

My commission expires Sept. 8, 1960

(Notary Public)

(SEAL)

CERTIFICATE OF REGISTRATION

STATE OF OREGON

County of Marion } ss.

This is to certify that the foregoing Registration Statement was received in the office of the State Engineer on the 8th day of April, 1957, at 9:00 o'clock A. M. and has been duly recorded in said office in Book No. 3 of Registration Statements on page GR-417 G.

~~Construction shall be completed by X-X-X-X-X-X-X-X-X-X-X-X-X-X and the water completely applied to beneficial use by X-X-X-X-X-X-X-X-X-X-X-X-X-X~~

Witness my hand this 26th day of June, 1957.

Lewis A. Stanley
(State Engineer)

By _____ (Deputy)

20.00