RECEIVED
APR 10 1957
STATE ENGINEER
SALEM, OREGON

REGISTRATION NO. GR-437
CERTIFICATE NO. R 423

Registration Statement

OF CLAIMANT OF RIGHT TO APPROPRIATE GROUND WATER

(Under Chapter 708, Oregon Laws 1955.)

TO THE STATE ENGINEER OF OREGON:

I, Paul R. and June E. Smith,

of Rt. 2, Box 500, Albany County of Linn

State of Oregon, do hereby make application for a certificate of registration as evidence of a right to appropriate ground water.

1. **Source** from which water is withdrawn is pump well No. 1 (Flowing well, pump well, infiltration trench, or tunnel)

2. **Location** is: 9 miles NE Albany, Oregon (Approximate distance and direction from nearest city or town);

and is more particularly described as follows:

(a) N. 87° W. 35.5 chains from the SE corner S. 29, T. 10 S., R. 2 W.W.M. (Give distance and bearing to corner of section or other legal subdivision)

being within SW¼ of SE¼ (Smallest legal subdivision) of Sec. 29, Twp. 10S (N. or S.), Rge. 2 W. (E. or W.)

or (b) within limits of recorded platted property, town or city:

in Lot ....., Block ..... of ..... (Name of plat or addition)

..... (If within city or town, give name) County of Linn

3. **Construction Work** was begun on June 5, 1947 (Date); was completed on June 7, 1947 (Date)

and the ground water claimed was first used for the purposes set out below on June 12, 1947 (Date),

since which time the water has been used continuously (Continuously or intermittently)

from June 12, 1947 (Date) to present time (Date)

4. **Quantity** of water claimed and used is 260 gallons per minute; 74 acre feet per year.

5. **Purpose or Purposes** for which water is used Irrigation

..... (Domestic, irrigation, municipal, manufacturing, industrial, etc.)

6. **Description of Well:** Depth 21 feet. Type Drilled (Dug or drilled)

diameter 6 inches. Elevation of ground at well site 245 (As near as known) feet, mean sea level.

Depth to water table 10 feet.

7. **Capacity of Well:** 400 g.p.m. with 3 feet drawdown,

..... g.p.m. with ..... feet drawdown.

Date of test Estimated

If Flowing Well: Measured discharge ..... g.p.m. on ..... (Date)

Shut-in pressure at ground surface ..... lbs. per sq. in. on ..... (Date)

Water is controlled by ..... (Cap, valve, etc.)

8. **Casing:** (Give diameter, commercial specifications and depth below ground surface of each casing size.)

6 inch diameter steel casing from 0 to 21 feet

..... inch diameter ..... from ..... to ..... feet

..... inch diameter ..... from ..... to ..... feet

..... inch diameter ..... from ..... to ..... feet

Describe and show depth of shoe, plug, adapter, liner or other details: .....

9. **Perforated Casings or Screens:**

slit perforations from 13 to 21
(Number per foot and size of perforations, or describe screen)

..... from ..... to .....

..... from ..... to .....

..... from ..... to .....

10. **Log of Well:** (Describe each stratum or formation clearly, indicate if water bearing, and give thickness and depth as indicated.)

MATERIAL	Thickness (Feet)	Depth to Bottom (Feet)
Not available		

If log of well is not available, give name and address of driller. Bud Slate, Tangent, Oregon

11. **Infiltration Trench:** Covered or open .....

Dimensions: Length ..... ft. Minimum depth ..... ft. Maximum depth ..... ft.

Bottom width ..... ft. Discharge ..... g.p.m. Date of test .....

12. **Tunnel:** Type of lining .....

Dimensions: .....
(Length, course, and cross sectional size)

Position of water bearing stratum with reference to portal of tunnel .....

Log of tunnel: (Preceding table for log of well may be used, if desired. Give footage from portal and character of materials, as pertinent.)

13. **Pumping Equipment:**

(a) Pump Fairbanks Morse 4" centrifugal (Make, type and size) Capacity 400 g.p.m.

(b) Motor 15 H. P. electric (Type and horsepower)

14. Location of area irrigated or to be irrigated, or place of use if for purposes other than irrigation.

Township North or South	Range E. or W. of Willamette Meridian	Section	Forty-acre Tract	Number Acres To Be Irrigated	Date of Reclamation
10 S	2 W.	29	NW¼ of SE¼	0.1	June 12, 1947
10 S	2 W.	29	SW¼ of SE¼	14.0	" "
10 S	2 W.	29	SE¼ of SW¼	9.1	" "
10 S	2 W.	32	NE¼ of NW¼	2.5	" "
10 S	2 W.	32	NW¼ of NE¼	3.9	" "
				29.6	

15. If the ground water supply is supplemental to an existing water supply, identification of any application for a permit, permit, certificate or adjudicated right to appropriate water made or held by the registrant.

Township 10 S Range 2 W, W.M.

North

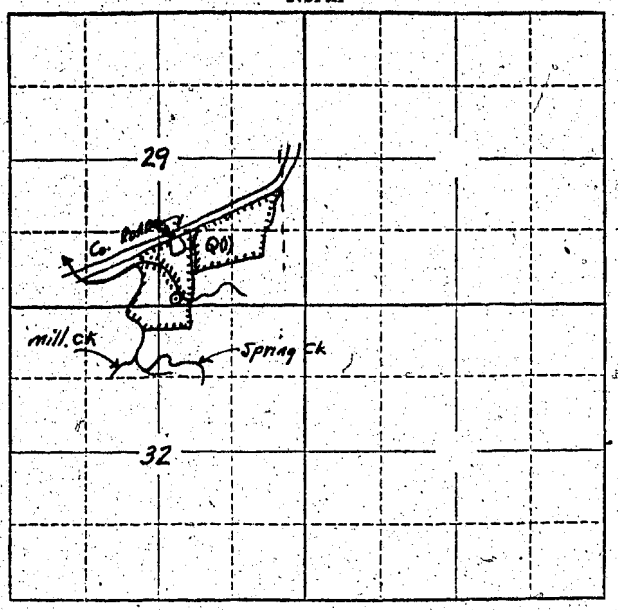

Locate well and acreage of irrigated land on plat.

Scale: 2" = 1 Mile

STATE OF OREGON
County of Linn } ss.

I, Paul R. and June E. Smith, being first duly sworn, do hereby certify that I have read the foregoing Registration Statement and that all of the items therein contained are true to the best of my knowledge and belief.

Paul R. Smith
June E. Smith
(Signature of Registrant)

Subscribed and sworn to before me this 8th day of April, 1957

~~My commission expires~~ _____ T. M. Powell
Notary Public County Clerk

(SEAL)

CERTIFICATE OF REGISTRATION

STATE OF OREGON
County of Marion } ss.

This is to certify that the foregoing Registration Statement was received in the office of the State Engineer on the 10th day of April, 1957, at 8:00 o'clock A. M. and has been duly recorded in said office in Book No. 3 of Registration Statements on page GR-423 C.

~~Construction shall be completed by _____ and the water completely applied to a beneficial use by _____.~~

Witness my hand this 24th day of July, 1957.

Lewis A. Stanley
(State Engineer)

$15.00

By _____
(Deputy)

- 423 C