

RECEIVED

APR 11 1957

STATE ENGINEER
SALEM, OREGON

Registration Statement

REGISTRATION NO. GR 438
CERTIFICATE NO. GR 424

OF CLAIMANT OF RIGHT TO APPROPRIATE GROUND WATER

(Under Chapter 703, Oregon Laws 1955.)

TO THE STATE ENGINEER OF OREGON:

I, Walter H. Herzog

of Rt. 2, Box 688, Central Point, County of Jackson

State of Oregon, do hereby make application for a certificate of registration as evidence of a right to appropriate ground water.

1. Source from which water is withdrawn is Infiltration Trench
(Flowing well, pump well, infiltration trench, or tunnel)

2. Location is: approximately 2 miles North of Central Point, Oregon
(Approximate distance and direction from nearest city or town)

and is more particularly described as follows:

(a) 652.54 feet South and 2981.91 feet west from the NE corner DIC #56
(Give distance and bearing to corner of section or other legal subdivision)

being within NW 1/4 NE 1/4 of Sec. 34, Twp. 36 S., Rge. 2 W.
(Smallest legal subdivision) (N. or S.) (E. or W.)

or (b) within limits of recorded platted property, town or city:

in Lot _____, Block _____ of _____
(Name of plat or addition)

County of _____
(If within city or town, give name)

3. Construction Work was begun on about 1944; was completed on 1944
(Date) (Date)

and the ground water claimed was first used for the purposes set out below on 1945
(Date)

since which time the water has been used intermittently
(Continuously or Intermittently)

from 1945 to 1956
(Date) (Date)

4. Quantity of water claimed and used is 140 gallons per minute; 4.5 acre feet per year, per acre.

5. Purpose or Purposes for which water is used irrigation

(Domestic, irrigation, municipal, manufacturing, industrial, etc.)

6. Description of Well: Depth _____ feet. Type _____
(Dug or drilled)

diameter _____ inches. Elevation of ground at well site 1215 feet, mean sea level.
(As near as known)

Depth to water table _____ feet.

7. Capacity of Well: _____ g.p.m. with _____ feet drawdown.

_____ g.p.m. with _____ feet drawdown.

Date of test _____


If Flowing Well: Measured discharge _____ g.p.m. on _____
(Date)

Shut-in pressure at ground surface _____ lbs. per sq. in. on _____
(Date)

Water is controlled by _____
(Cap, valve, etc.)

Township 34 S. Range 2 W. W.M.

North

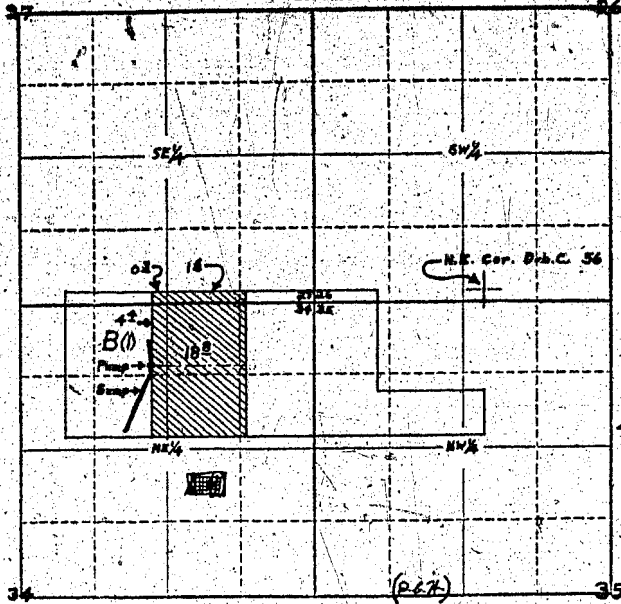

Locate well and acreage of irrigated land on plat.

Scale: 4" = 1 Mile

STATE OF OREGON

County of Jackson

ss:

I, Walter H. Herzog, being first duly sworn, do hereby certify that I have read the foregoing Registration Statement and that all of the items therein contained are true to the best of my knowledge and belief.

Walter H. Herzog (Signature of Registrant)

Subscribed and sworn to before me this 25th day of March, 1957

My commission expires Nov. 23-1960

My dau. [Signature] (Notary Public)

(SEAL)

CERTIFICATE OF REGISTRATION

STATE OF OREGON

County of Marion

ss.

This is to certify that the foregoing Registration Statement was received in the office of the State Engineer on the 11th day of April, 1957, at 1:00 o'clock P.M. and has been duly recorded in said office in Book No. 3 of Registration Statements on page GR-124 C.

Construction shall be completed by [unclear] and the water completely applied to beneficial use by [unclear]

Witness my hand this 26th day of June, 1957

Lewis J. Stanley (State Engineer)

By

(Deputy)

\$15.00