

RECEIVED
NOV 18 1955
STATE ENGINEER
SALEM, OREGON

REGISTRATION NO. GR-14

Registration Statement

CERTIFICATE NO. GR-38

OF CLAIMANT OF RIGHT TO APPROPRIATE GROUND WATER

(Under Chapter 708, Oregon Laws 1955.)

TO THE STATE ENGINEER OF OREGON:

I, Percy Hoyerly
of Rt. 1, Box 432, Albany County of Linn

State of Oregon, do hereby make application for a certificate of registration as evidence of a right to appropriate ground water.

1. Source from which water is withdrawn is Pump well
(Flowing well, pump well, infiltration trench, or tunnel)

2. Location is: 2½ miles S.E. Albany, Oregon
(Approximate distance and direction from nearest city or town)

and is more particularly described as follows:

(a) S. 50° E. 25.0 chains from the NW corner of the SW quarter of Sec. 16, T. 11 S.,
(Give distance and bearing to corner of section or other legal subdivision)
being within NW¼ of SW¼ of Sec. 16, Twp. 11 S., Rge. 3 W.
(Smallest legal subdivision) (N. or S.) (E. or W.)

or (b) within limits of recorded platted property, town or city: _____

in Lot _____ Block _____ of _____
(Name of plat or addition)
County of Linn
(If within city or town, give name)

3. Construction Work was begun on May 15, 1948; was completed on May 17, 1948
(Date) (Date)

and the ground water claimed was first used for the purposes set out below on June 15, 1948
(Date)

since which time the water has been used continuously
(Continuously or intermittently)

from June 15, 1948 to Sept. 15, 1955
(Date) (Date)

4. Quantity of water claimed and used is 180 gallons per minute; 56 acre feet per year.

5. Purpose or Purposes for which water is used Irrigation

(Domestic, irrigation, municipal, manufacturing, industrial, etc.)

6. Description of Well: Depth 138 feet. Type Drilled
(Dug or drilled)

diameter 8 inches. Elevation of ground at well site 235 feet, mean sea level.
(As near as known)

Depth to water table 24 feet.

7. Capacity of Well: 215 g.p.m. with 10 feet drawdown.

_____ g.p.m. with _____ feet drawdown.

Date of test June 15, 1948

If Flowing Well: Measured discharge _____ g.p.m. on _____
(Date)

Shut-in pressure at ground surface _____ lbs. per sq. in. on _____
(Date)

Water is controlled by _____
(Cap, valve, etc.)

If log of well is not available, give name and address of driller. T. J. Burkhart, 169 N. 1st W.,
Tremonton, Utah

11. Infiltration Trench: Covered or open

Dimensions: Length ft. Minimum depth ft. Maximum depth ft.

Bottom width ft. Discharge g.p.m. Date of test

12. Tunnel: Type of lining

Dimensions:
(Length, course, and cross sectional size)

Position of water bearing stratum with reference to portal of tunnel

Log of tunnel: (Preceding table for log of well may be used, if desired. Give footage from portal and character of materials, as pertinent.)

13. Pumping Equipment:

(a) Pump 2" centrifugal Pacific pump Capacity 200 g.p.m.
(Make, type and size)

(b) Motor 7½ H.P. electric motor
(Type and horsepower)

14. Location of area irrigated or to be irrigated, or place of use if for purposes other than irrigation.

Township North or South	Range E. or W. of Willamette Meridian	Section	Forty-acre Tract	Number Acres To Be Irrigated	Date of Reclamation
11 S	3 W	16	NW¼ of SW¼	17.0	Prior to 1900 <i>1948</i>
11 S	3 W	16	SW¼ of SW¼	5.5	Prior to 1900 <i>1948</i>
				22.5	

Beginning at a point on the South boundary line of the D.L.C. of John Burkhart D.L.C. 51 Not. No. 688 in T. 11 S., R 3 W. of the Will. Mer. in Linn County, Oregon which is 22.68 chains West from the Southeast corner ~~exterior~~ of said D.L.C.; and running thence North 49.21 chains, more or less, to the South boundary line of the D.L.C. of E. N. White and wife, Not. No. 694 Claim No. 48 in T. 11 S., R 3 W. etc. thence West 15.44 chains more or less to the Southwest corner of said Cl. No. 48; thence South 5.11 chains, more or less to the North boundary line of said Cl. No. 51; thence West 7.24 chains, to a point on the North boundary line of said Cl. No. 51, which is 45.36 chains West from the Northeast corner of said Cl. 51; thence South 44.10 chains to the South boundary line of said Cl. No. 51; thence East 22.68 chains to the place of beginning and containing 107.90 acres, more or less: ALSO


Beginning at a point 45.37 chains West and 16.38 chains North of the Southeast corner of the D.L.C. of John Burkhart and wife, No. No. 688 and Cl. #51 in T. 11 S., R 3 W. of the Will. Mer. in Linn County, Oregon; and running thence West 21.50 chains, thence North 9.31 chains; thence East 21.50 chains, thence South 9.31 chains to the place of beginning, containing 20 acres, more or less, in Linn County, Oregon

ALSO Beginning at a point 45.37 chains West of the Southeast corner of the D.L.C. of John Burkhart and wife Not. No. 688 and Cl. #51 in T. 11 S., R 3 W. of the Will. Mer. in Linn County, Oregon; and running thence West on the South line of said D.L.C. 21.50 chains to the center of a of a wagon road; thence North along the center of said road 16.38 chains, thence East 21.50 chains, thence South 16.38 chains to the place of beginning, containing 35.25 acres.

ALSO: Beginning at a point 45.37 chains West and 27.68 chains North of the Southeast corner of the D.L.C. of John Burkhart and ~~his~~ wife etc. and running thence West 12.20 chains; thence North 11 chains to the center of a county road; thence South 65° East along the center of said county road to a point due North of the place of beginning;

ALSO: Beginning at a point in the center of a county road which point is 6 chains South and 1.80 chains East of the Northeast corner of the Southeast quarter of Sec. 17 in T. 11 S., R 3 W. of the Will. Mer. etc. and running thence South 13.65 chains; thence East 5 chains, thence North 11.40 chains to the center of a county road; thence North 65° West along the center of said county road to the place of beginning, containing 6.15 acres more or less, containing in the aggregate 16.15 acres, more or less, all lying and being situated in the County of Linn, State of Oregon.

Township 11 S Range 3 W W.M.
North

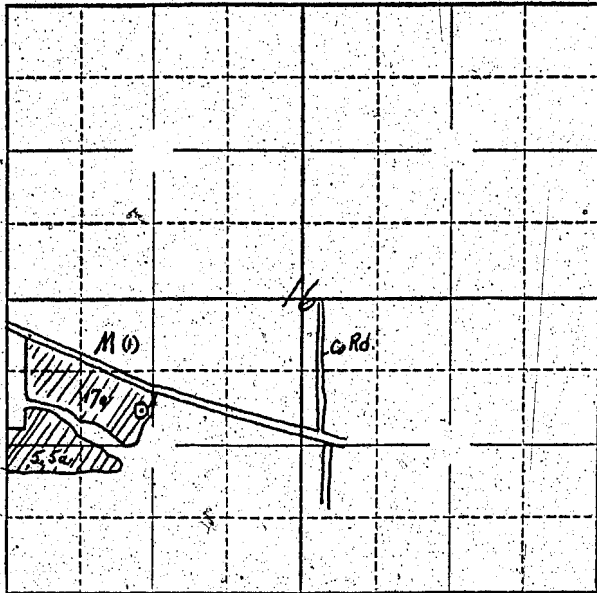

Locate well and acreage of irrigated land on plat.

Scale: $\frac{2''}{4''} = 1 \text{ Mile}$

STATE OF OREGON

County of Linn } ss.

I, Percy Heyerly, being first duly sworn, do hereby certify that I have read the foregoing Registration Statement and that all of the items thereof contained are true to the best of my knowledge and belief.

Percy Heyerly
(Signature of Registrant)

Subscribed and sworn to before me this 17th day of November, 1955

My commission expires _____

R. G. Russell, Clerk
(Notary Public)
Ed. Magart, Deputy

(SEAL)

CERTIFICATE OF REGISTRATION

STATE OF OREGON

County of Marion } ss.

This is to certify that the foregoing Registration Statement was received in the office of the State Engineer on the 18th day of November, 1955, at 8:00 o'clock A.M. and has been duly recorded in said office in Book No. 1 of Registration Statements on page 38

Construction shall ^{is} be completed by _____, 19____, and the water, ^{is} completely applied to beneficial use by _____, 19____

Witness my hand this 24th day of February, 1956

Lewis A. Stanley
(State Engineer)

By _____
(Deputy)