

# Registration Statement

## OF CLAIMANT OF RIGHT TO APPROPRIATE GROUND WATER

(Under Chapter 703, Oregon Laws 1955.)

TO THE STATE ENGINEER OF OREGON:

I, Victor Schaefer



1. Source from which water is withdrawn is  pump well   
(Flowing well, pump well, infiltration trench, or tunnel)

2. Location is:  3/4 mile west of Cannonville   
(Approximate distance and direction from nearest city or town)

and is more particularly described as follows:

(a)  1150' S to 300' E from the N.W. corner section 25   
(Give distance and bearing to corner of section or other legal subdivision)

being within  the N.W. 1/4 N.W. 1/4  of Sec.  25 , Twp.  8 9 , Rge.  2 W   
(Smallest legal subdivision) (4th or S.) (Range W.)

or (b) within limits of recorded platted property, town or city: \_\_\_\_\_

in Lot \_\_\_\_\_, Block \_\_\_\_\_ of \_\_\_\_\_  
(Name of plat or addition)

County of \_\_\_\_\_  
(If within city or town, give name)

3. Construction Work was begun on  Oct 1952 ; was completed on  Jan 1952   
(Date) (Date)

and the ground water claimed was first used for the purposes set out below on  April 1953   
(Date)

since which time the water has been used  intermittently   
(Continuously or Intermittently)

from  April 1953  to  March 1957   mainly from 20' to 2' track   
(Date) (Date) (Spec)

4. Quantity of water claimed and used is  125  gallons per minute; \_\_\_\_\_ acre-foot per year.

5. Purpose or Purposes for which water is used \_\_\_\_\_

irrigation   
(Domestic, irrigation, municipal, manufacturing, industrial, etc.)

6. Description of Well: Depth  98  feet. Type  drilled   
(Dug or drilled)

diameter  8  inches. Elevation of ground at well site \_\_\_\_\_ feet, mean sea level.  
(As near as known)

Depth to water table  9  feet.

7. Capacity of Well:  125  g.p.m. with  20  feet drawdown.  
\_\_\_\_\_ g.p.m. with \_\_\_\_\_ feet drawdown.

Date of test  Nov 52

If Flowing Well: Measured discharge \_\_\_\_\_ g.p.m. on \_\_\_\_\_

Shut-in pressure at ground surface \_\_\_\_\_ lbs. per sq. in.  
(Date)

Water is controlled by \_\_\_\_\_  
(Cap, valve, etc.)

8. Casing: (Give diameter, commercial specifications and depth below ground surface of each casing size.)

8" inch diameter *iron pipe* from *top* to *98* feet  
 inch diameter from to feet  
 inch diameter from to feet  
 inch diameter from to feet

Describe and show depth of shoe, plug, adapter, liner or other details: \_\_\_\_\_

9. Perforated Casings or Screens:

*6" long 3 1/4 perforation every 16"* from *154 top* to *98*  
 (Number per foot and size of perforations, or describe screen)  
 from to  
 from to  
 from to

10. Log of Well: (Describe each stratum or formation clearly, indicate if water bearing, and give thickness and depth as indicated.)

MATERIAL	Thickness (Feet)	Depth to Bottom (Feet)
<i>first 15' loose soil + gravel</i>		
<i>next 39' cement gravel &amp; rubble stone water bearing</i>		
<i>next 30' blue clay sand gravel</i>		
<i>last 14' sand + mud gravel + rock and some cement gravel</i>		

If log of well is not available, give name and address of driller:

11. Infiltration Trench: Covered or open \_\_\_\_\_  
 Dimensions: Length \_\_\_\_\_ ft. Minimum depth \_\_\_\_\_ ft. Maximum depth \_\_\_\_\_ ft.  
 Bottom width \_\_\_\_\_ ft. Discharge \_\_\_\_\_ g.p.m. Date of test \_\_\_\_\_

12. Tunnel: Type of lining \_\_\_\_\_  
 Dimensions: \_\_\_\_\_  
(Length, course, and cross sectional size)  
 Position of water bearing stratum with reference to portal of tunnel \_\_\_\_\_

Log of tunnel: (Preceding table for log of well may be used, if desired. Give footage from portal and character of materials, as pertinent.)


13. Pumping Equipment:  
 (a) Pump *Trunk's Jacuzz 18 stage* Capacity *125* g.p.m.  
(Make, type and size)  
 (b) Motor *7 1/2 H.P. C.S.*  
(Type and horsepower)

14. Location of area irrigated or to be irrigated, or place of use if for purposes other than irrigation.

Township North or South	Range E. or W. of Willamette Meridian	Section	Forty-acre Tract	Number Acres To Be Irrigated	Date of Reclamation
				<del>20</del>	<del>1/1/53</del>
85	2W	25	NW 1/4 NW 1/4	5	April 10/53
"	"	"	SW 1/4 NW 1/4	15	" " "
				<u>20</u>	

15. If the ground water supply is supplemental to an existing water supply, identification of any application for a permit, permit, certificate or adjudicated right to appropriate water made or held by the registrant.

Township 8 S Range 2 W, W.M. North

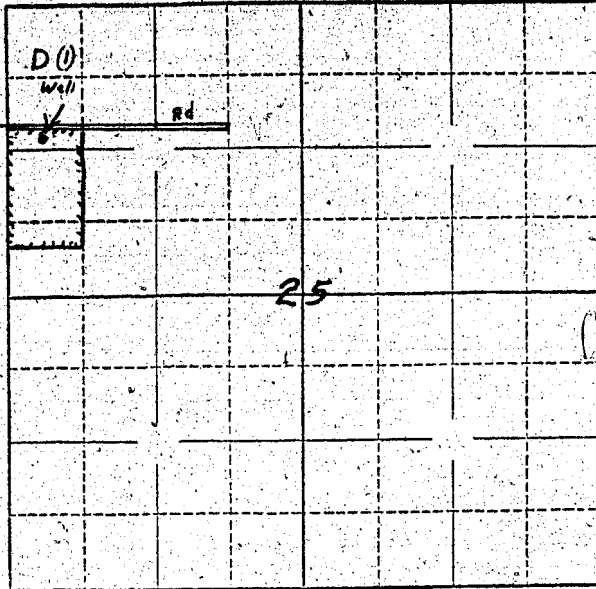

Locate well and acreage of irrigated land on plat.

Scale:  $\frac{1}{4}$ " = 1 Mile

STATE OF OREGON

County of Marion } ss.

I, Victor Schaefer, being first duly sworn, do hereby certify that I have read the foregoing Registration Statement and that all of the items therein contained are true to the best of my knowledge and belief.

Victor Schaefer  
(Signature of Registrant)

Subscribed and sworn to before me this 12 day of April, 1957.

My commission expires September 8, 1956  
Ray S. Rogers  
(Notary Public)

(SEAL)

**CERTIFICATE OF REGISTRATION**

STATE OF OREGON } ss.  
County of Marion

This is to certify that the foregoing Registration Statement was received in the office of the State Engineer on the 12th day of April, 1957, at 8:00 o'clock A.M. and has been duly recorded in said office in Book No. 3 of Registration Statements on page GR-427 C.

~~Construction shall be completed by x-x-x-x-x-x-x-x-x-x-x-x-x-x-x-x, and the water completely applied to beneficial use by x-x-x-x-x-x-x-x-x-x-x-x-x-x-x-x.~~

Witness my hand this 26th day of June, 1957.

Lewis A. Stanley  
(State Engineer)

\$15.00

By \_\_\_\_\_ (Deputy)

GR - 427 C