

Registration Statement

OF CLAIMANT OF RIGHT TO APPROPRIATE GROUND WATER

TO THE STATE ENGINEER OF OREGON:

I, Carl Franzen
 of Pt 3 Box 271 Boring Ore County of Clackamas
(Mailing address)
 State of Ore, do hereby make application for a certificate of registration as evidence of a right to appropriate ground water.

1. Source from which water is withdrawn is Pump Well
(Flowing well, pump well, infiltration trench, or tunnel)

2. Location is: 2 m. W. of Boring 1/2 mile South
(Approximate distance and direction from nearest city or town)

and is more particularly described as follows:

(a) S 2° E, 2662 feet from the NW corner of Section 11
(Give distance and bearing to corner of section or other legal subdivision)
 being within NW 1/4 NW 1/4 SW 1/4 of Sec. 11, Twp. 2 S, Rge. 3 E.
(Smallest legal subdivision) (N. or S.) (E. or W.)

or (b) within limits of recorded platted property, town or city:

in Lot _____, Block _____ of _____
(Name of plat or addition)

County of _____
(If within city or town, give name)

3. Construction Work was begun on JUNE 25, 1940, was completed on JULY 5, 1940
(Date) (Date)

and the ground water claimed was first used for the purposes set out below on MAY 15, 1941,
(Date)

since which time the water has been used CONTINUOUSLY THROUGHOUT THE SUMMER
(Continuously or Intermittently)

from MAY 15, 1941 to PRESENT
(Date) (Date)

4. Quantity of water claimed and used is 60 gallons per minute; _____ acre feet per year.

5. Purpose or Purposes for which water is used IRRIGATION DURING THE SUMMER MONTHS
(Domestic, irrigation, municipal, manufacturing, industrial, etc.)

6. Description of Well: Depth 179 feet. Type DRILLED
(Dug or drilled)

diameter 8 inches. Elevation of ground at well site 600 feet, mean sea level.
(As near as known)

Depth to water table 152 feet.

7. Capacity of Well: 40 g.p.m. with 9 feet drawdown.
 _____ g.p.m. with _____ feet drawdown.

Date of test _____

If Flowing Well: Measured discharge _____ g.p.m. on _____
(Date)

Shut-in pressure at ground surface _____ lbs. per sq. in. on _____
(Date)

Water is controlled by _____
(Cap, valve, etc.)

8. Casing: (Give diameter, commercial specifications and depth below ground surface of each casing size.)

8 inch diameter Steel from Surface to 1.79 feet
 inch diameter from to feet
 inch diameter from to feet
 inch diameter from to feet

Describe and show depth of shoe, plug, adapter, liner or other details:

9. Perforated Casings or Screens:

45 ROWS from 164 to 174
 (Number per foot and size of perforations, or describe screen)
 from to
 from to
 from to

10. Log of Well: (Describe each stratum or formation clearly, indicate if water bearing, and give thickness and depth as indicated.)

MATERIAL	Thickness (Feet)	Depth to Bottom (Feet)
Clay	35'	35
Gravel	8'	43
Cement Sand	3'	46
Cement Gravel	34'	80
Cement Sand	51	131
Yellow Clay	6	137
Blue Clay	5	142
Yellow Clay	18	160
Sand & Gravel	19	179

If log of well is not available, give name and address of driller.....

11. Infiltration Trench: Covered or open

Dimensions: Length ft. Minimum depth ft. Maximum depth ft.

Bottom width ft. Discharge g.p.m. Date of test

12. Tunnel: Type of lining

Dimensions:
(Length, course, and cross sectional size)

Position of water bearing stratum with reference to portal of tunnel

Log of tunnel: (Preceding table for log of well may be used, if desired. Give footage from portal and character of materials, as pertinent.)

13. Pumping Equipment:

(a) Pump Pomona - Turbine - 3" Intake Capacity 60 g.p.m.
(Make, type and size)


(b) Motor Electric - 10 H.P.
(Type and horsepower)

14. Location of area irrigated or to be irrigated, or place of use if for purposes other than irrigation.

Township North or South	Range E. or W. of Willamette Meridian	Section	Forty-acre Tract	Number Acres To Be Irrigated	Date of Reclamation
2S	3E	10	NE 1/4 SE 1/4	30	May - 1945

15. If the ground water supply is supplemental to an existing water supply, identification of any application for a permit, permit, certificate or adjudicated right to appropriate water made or held by the registrant.

Township 12S Range 3E, W.M.
North

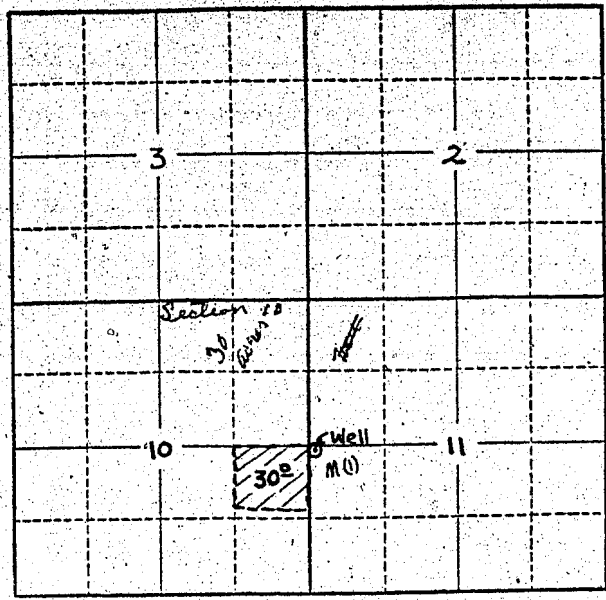

Locate well and acreage of irrigated land on plat.
Scale: 2" = 1 Mile

STATE OF OREGON }
County of Clackamas } ss.

I, Carl Franse, being first duly sworn, do hereby certify that I have read the foregoing Registration Statement and that all of the items therein contained are true to the best of my knowledge and belief.

Carl Franse
(Signature of Registrant)

Subscribed and sworn to before me this 22nd day of April, 1957

My commission expires October 26, 1959
(Notary Public)

(SEAL)

CERTIFICATE OF REGISTRATION

STATE OF OREGON }
County of Marion } ss.

This is to certify that the foregoing Registration Statement was received in the office of the State Engineer on the 15th day of April, 1957, at 8:00 o'clock A. M. and has been duly recorded in said office in Book No. 3 of Registration Statements on page GR-429 C.

Witness my hand this 26th day of June, 1957
Lewis A. Stanley
(State Engineer)

By _____ (Deputy)

GR 429 C

#15.00