RECEIVED
APR 11 1951
STATE ENGINEER
SALEM, OREGON

REGISTRATION NO. GR-444
CERTIFICATE NO. GR-430

Registration Statement

OF CLAIMANT OF RIGHT TO APPROPRIATE GROUND WATER

(Under Chapter 708, Oregon Laws 1955.)

TO THE STATE ENGINEER OF OREGON:

I, George F. McKibben,

of Rt. 2 Box 420 Eugene County of Lane

State of Oregon, do hereby make application for a certificate of registration as evidence of a right to appropriate ground water.

1. **Source from which water is withdrawn is** pump well (or infiltration hole)
(Flowing well, pump well, infiltration trench, or tunnel)

2. **Location is:** ½ mile NW from Coburg, Oregon;
(Approximate distance and direction from nearest city or town)

and is more particularly described as follows:

(a) N 58°30' W 1046 ft. from the SW corner of the Issac Van Duyn D.L.C. No. 61
(Give distance and bearing to corner of section or other legal subdivision)

being within SW ¼ of SE¼ of Sec. 29, Twp. 16 S (N. or S.), Rge. 3W (E. or W.)
(Smallest legal subdivision)

or (b) within limits of recorded platted property, town or city:

in Lot ....., Block ..... of .....
(Name of plat or addition)

..... County of .....
(If within city or town, give name)

3. **Construction Work** was begun on August 1, 1950 (Date); was completed on August 3, 1950 (Date)

and the ground water claimed was first used for the purposes set out below on May 1, 1951 (Date),

since which time the water has been used intermittantly (summer only)
(Continuously or intermittently)

from May 1, 1951 (Date) to present (Date)

4. **Quantity** of water claimed and used is 250 gallons per minute; 5.0 acre feet per year.

5. **Purpose or Purposes** for which water is used

irrigation
(Domestic, irrigation, municipal, manufacturing, industrial, etc.)

6. **Description of Well:** Depth 20 feet. Type dug with clam shell bucket uncased
(Dug or drilled)

diameter 12 ft. ~~inches~~. Elevation of ground at well site 390.0 feet, mean sea level.
(As near as known)

Depth to water table none feet.

7. **Capacity of Well:** ? g.p.m. with 3 to 4 feet drawdown. August & Sept. only

..... g.p.m. with ..... feet drawdown.

Date of test .....

If Flowing Well: Measured discharge ..... g.p.m. on .....
(Date)

Shut-in pressure at ground surface ..... lbs. per sq. in. on .....
(Date)

Water is controlled by .....
(Cap, valve, etc.)

8. **Casing:** (Give diameter, commercial specifications and depth below ground surface of each casing size.)

..... inch diameter ..... from ..... to ..... feet

..... inch diameter ..... from ..... to ..... feet

..... inch diameter ..... from ..... to ..... feet

..... inch diameter ..... from ..... to ..... feet

Describe and show depth of shoe, plug, adapter, liner or other details: .....

.....

.....

9. **Perforated Casings or Screens:**

..... from ..... to .....
(Number per foot and size of perforations, or describe screen)

..... from ..... to .....

..... from ..... to .....

..... from ..... to .....

10. **Log of Well:** (Describe each stratum or formation clearly, indicate if water bearing, and give thickness and depth as indicated.)

MATERIAL	Thickness (Feet)	Depth to Bottom (Feet)
Sawmill waste & organic debris	4.0	
sand and gravel	16.0	20

GR - 430 A

If log of well is not available, give name and address of driller. .....

11. **Infiltration Trench:** Covered or open ....open.... 12 ft diam. 20 ft. deep

Dimensions: Length ..... ft. Minimum depth ..... ft. Maximum depth ..... ft.

Bottom width ..... ft. Discharge ..... g.p.m. Date of test .....

12. **Tunnel:** Type of lining .....

Dimensions: .....
(Length, course, and cross sectional size)

Position of water bearing stratum with reference to portal of tunnel .....

Log of tunnel: (Preceding table for log of well may be used, if desired. Give footage from portal and character of materials, as pertinent.)

13. **Pumping Equipment:**

(a) Pump Fairbanks-Morse centrifugal 2½" disch Capacity 200 g.p.m.
(Make, type and size)

(b) Motor Electric 10 HP
(Type and horsepower)

14. Location of area irrigated or to be irrigated, or place of use if for purposes other than irrigation.

Township North or South	Range E. or W. of Willamette Meridian	Section	Forty-acre Tract	Number Acres To Be Irrigated	Date of Reclamation
16 S	3 W	29	SW¼ of SE¼	16.26	5-1-51
16 S	3 W	29	SE¼ of SE¼	1.13	"
16 S	3 W	32	NW¼ of NE¼	0.51	"
				17.90	

15. If the ground water supply is supplemental to an existing water supply, identification of any application for a permit, permit, certificate or adjudicated right to appropriate water made or held by the registrant.

.....

.....

Township 16 S Range 3 W, W.M.

North

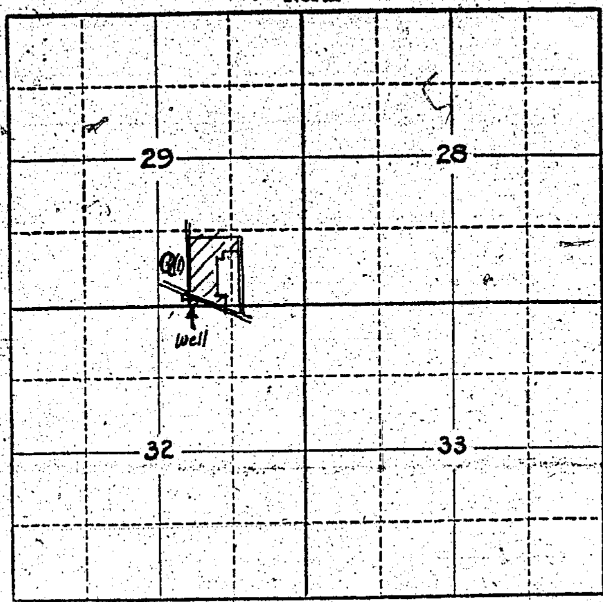

Locate well and acreage of irrigated land on plat.

Scale: 2" = 1 Mile

STATE OF OREGON } ss.
County of LANE

I, George F. McKibben, being first duly sworn, do hereby certify that I have read the foregoing Registration Statement and that all of the items therein contained are true to the best of my knowledge and belief.

George F. McKibben
(Signature of Registrant)

Subscribed and sworn to before me this 11th day of April, 1957.

My commission expires August 24, 1959 Dorothy A. Moore (Notary Public) for Oregon

(SEAL)

CERTIFICATE OF REGISTRATION

STATE OF OREGON } ss.
County of Marion

This is to certify that the foregoing Registration Statement was received in the office of the State Engineer on the 15th day of April, 1957, at 1:00 o'clock P.M. and has been duly recorded in said office in Book No. 3 of Registration Statements on page GR-430 C

~~Construction shall be completed by x-x-x-x-x-x-x-x 19-x-x and the water completely applied to beneficial use by x-x-x-x-x-x-x-x 19-x-x~~

Witness my hand this 26th day of June, 1957.

Lewis A. Stanley
(State Engineer)

$15.00

By
(Deputy)

GR - 430 C