RECEIVED
APR 17 1957
STATE ENGINEER
SALEM, OREGON

REGISTRATION NO. GR-442

CERTIFICATE NO. GR 433

Registration Statement

OF CLAIMANT OF RIGHT TO APPROPRIATE GROUND WATER

(Under Chapter 708, Oregon Laws 1955.)

TO THE STATE ENGINEER OF OREGON:

I, Richard O. Morelock,

of General Delivery, Medford, County of Jackson

State of Oregon, do hereby make application for a certificate of registration as evidence of a right to appropriate ground water.

1. **Source** from which water is withdrawn is pump well (Flowing well, pump well, infiltration trench, or tunnel)

2. **Location** is: One-half mile east of Central Point (Approximate distance and direction from nearest city or town);

and is more particularly described as follows:

(a) 1305' N. and 1705' East from the S¼ corner of Section 2 (Give distance and bearing to corner of section or other legal subdivision)

being within SE¼ SE¼ (Smallest legal subdivision) of Sec. 2, Twp. 37 S. (N. or S.), Rge. 2 W. (E. or W.)

or (b) within limits of recorded platted property, town or city:

in Lot ....., Block ..... of ..... (Name of plat or addition)

..... (If within city or town, give name) County of .....

3. **Construction Work** was begun on June 10, 1954 (Date); was completed on June 15, 1954 (Date)

and the ground water claimed was first used for the purposes set out below on June 15, 1954 (approximate) (Date)

since which time the water has been used continuously (Continuously or intermittently)

from June 15, 1954 (Date) to date (Date)

4. **Quantity** of water claimed and used is 45 gallons per minute; 18 acre feet per year.

5. **Purpose or Purposes** for which water is used irrigation

..... (Domestic, irrigation, municipal, manufacturing, industrial, etc.)

6. **Description of Well:** Depth 80 feet. Type drilled (Dug or drilled)

diameter 6 inches. Elevation of ground at well site 1250 (As near as known) feet, mean sea level.

Depth to water table 13 feet.

7. **Capacity of Well:** 50 est. g.p.m. with 0 feet drawdown.

..... g.p.m. with ..... feet drawdown.

Date of test none

If Flowing Well: Measured discharge ..... g.p.m. on ..... (Date)

Shut-in pressure at ground surface ..... lbs. per sq. in. on ..... (Date)

Water is controlled by ..... (Cap, valve, etc.)

8. **Casing:** (Give diameter, commercial specifications and depth below ground surface of each casing size.)

6 inch diameter steel casing from 0 to 50 feet

..... inch diameter ..... from ..... to ..... feet

..... inch diameter ..... from ..... to ..... feet

..... inch diameter ..... from ..... to ..... feet

Describe and show depth of shoe, plug, adapter, liner or other details: .....

9. **Perforated Casings or Screens:**

..... from ..... to .....
(Number per foot and size of perforations, or describe screen)

..... from ..... to .....

..... from ..... to .....

..... from ..... to .....

10. **Log of Well:** (Describe each stratum or formation clearly, indicate if water bearing, and give thickness and depth as indicated.)

MATERIAL	Thickness (Feet) approximate	Depth to Bottom (Feet)
Top soil and sand	20'	20'
Concrete gravel (with two strata of loose sand and gravel at approximately 30' & 50')	30'	50'
Shale rock (no casing)	30'	80'

GR - 433 A

If log of well is not available, give name and address of driller. Virgil Gribble

303 5th Street, Gold Hill, Oregon

11. **Infiltration Trench:** Covered or open .....

Dimensions: Length ..... ft. Minimum depth ..... ft. Maximum depth ..... ft.

Bottom width ..... ft. Discharge ..... g.p.m. Date of test .....

12. **Tunnel:** Type of lining .....

Dimensions: ..... (Length, course, and cross sectional size)

Position of water bearing stratum with reference to portal of tunnel .....

Log of tunnel: (Preceding table for log of well may be used, if desired. Give footage from portal and character of materials, as pertinent.)

13. **Pumping Equipment:**

(a) Pump 1.0 inch jet pump (Make, type and size) Capacity 45 est. g.p.m.

(b) Motor 1.0 H.P. electric motor. (Type and horsepower)

14. Location of area irrigated or to be irrigated, or place of use if for purposes other than irrigation.

Township North or South	Range E. or W. of Willamette Meridian	Section	Forty-acre Tract	Number Acres To Be Irrigated	Date of Reclamation
37 S.	2 W.	2	NE¼ SE¼	0.6 acres	June 15, 1954
			SE¼ SE¼	3.2 acres	June 15, 1954
				3.8	

15. If the ground water supply is supplemental to an existing water supply, identification of any application for a permit, permit, certificate or adjudicated right to appropriate water made or held by the registrant.

none

CR - 433 B

Township 37 S. Range 2 W., W.M.

North

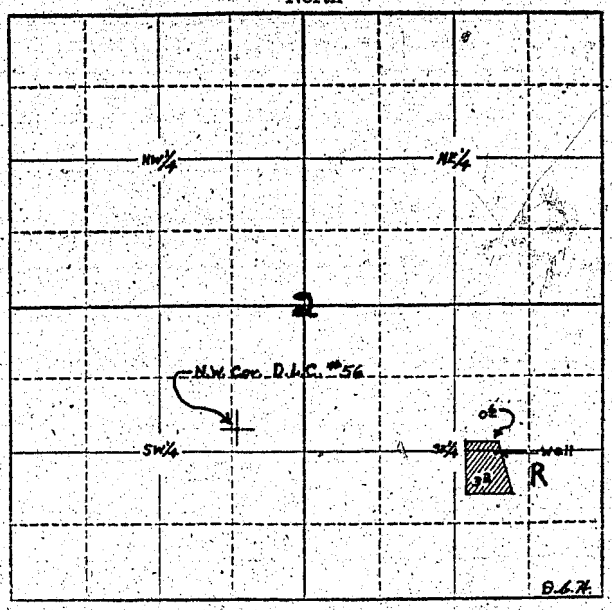

Locate well and acreage of irrigated land on plat.

Scale: 4" = 1 Mile

STATE OF OREGON
County of Jackson } ss.

I, Richard O. Morelock, being first duly sworn, do hereby certify that I have read the foregoing Registration Statement and that all of the items therein contained are true to the best of my knowledge and belief.

Richard O. Morelock
(Signature of Registrant)

Subscribed and sworn to before me this 16th day of April, 1957

My commission expires Nov. 23 - 1960 Lydah Neil for Oregon
(Notary Public)

(SEAL)

CERTIFICATE OF REGISTRATION

STATE OF OREGON
County of Marion } ss.

This is to certify that the foregoing Registration Statement was received in the office of the State Engineer on the 17th day of April, 1957, at 1:00 o'clock P.M. and has been duly recorded in said office in Book No. 3 of Registration Statements on page GR-433 C.

~~Construction shall be completed by x-x-x-