

RECEIVED
APR 30 1957
STATE ENGINEER
SALEM, OREGON

REGISTRATION NO. GR-449
NO. GR-434

Registration Statement CERTIFICATE

OF CLAIMANT OF RIGHT TO APPROPRIATE GROUND WATER

(Under Chapter 708, Oregon Laws 1953.)

TO THE STATE ENGINEER OF OREGON:

I, Elmer L. and Jennie R. Perry

of Rt 1 Box 311, Albany County of Linn

State of Oregon, do hereby make application for a certificate of registration as evidence of right to appropriate ground water.

1. Source from which water is withdrawn is pump well
(Flowing well, pump well, infiltration trench, or tunnel)

2. Location is: 5 miles north of Lebanon, Oregon
(Approximate distance and direction from nearest city or town)

and is more particularly described as follows:

(a) N. 40° 45'E. 25.5 chains from the N. E. corner of the Henry V. Clymer DLC 50
(Give distance and bearing to corner of section or other legal subdivision)

being within N. E. 1/4 of S. W. 1/4 of Sec. 15, Twp. 11S., Rge. 2 W
(Smallest legal subdivision) (N. or S.) (E. or W.)

or (b) within limits of recorded platted property, town or city:

in Lot _____, Block _____ of _____
(Name of plat or addition)

_____ County of Linn
(If within city or town, give name)

3. Construction Work was begun on October 8, 1948; was completed on October 12, 1948
(Date) (Date)

and the ground water claimed was first used for the purposes set out below on May 15, 1949
(Date)

since which time the water has been used continuously
(Continuously or Intermittently)

from May 15, 1949 to present time
(Date) (Date)

4. Quantity of water claimed and used is 198 gallons per minute; 10.25 acre feet per year.

5. Purpose or Purposes for which water is used irrigation

(Domestic, irrigation, municipal, manufacturing, industrial, etc.)

6. Description of Well: Depth 27 feet. Type drilled
(Dug or drilled)

diameter _____ inches. Elevation of ground at well site 280 feet, mean sea level.
(As near as known)

Depth to water table 9 feet.

7. Capacity of Well: 1500 g.p.m. with 8 feet drawdown.

_____ g.p.m. with _____ feet drawdown.

Date of test May 15, 1949

If Flowing Well: Measured discharge _____ g.p.m. on _____
(Date)

Shut-in pressure at ground surface _____ lbs. per sq. in. on _____
(Date)

Water is controlled by _____
(Cap, valve, etc.)

8. Casing: (Give diameter, commercial specifications and depth below ground surface of each casing size.)

.....10 inch diameter steel casing from 0 to 27 feet
..... inch diameter from to feet
..... inch diameter from to feet
..... inch diameter from to feet

Describe and show depth of shoe, plug, adapter, liner or other details:
.....
.....

9. Perforated Casings or Screens:

..... slit perforations from 22 to 27
(Number per foot and size of perforations, or describe screen)
..... from to
..... from to
..... from to

10. Log of Well: (Describe each stratum or formation clearly, indicate if water bearing, and give thickness and depth as indicated.)

MATERIAL	Thickness (Feet)	Depth to Bottom (Feet)
not available		

If log of well is not available, give name and address of driller.

11. Infiltration Trench: Covered or open

Dimensions: Length _____ ft. Minimum depth _____ ft. Maximum depth _____ ft.

Bottom width _____ ft. Discharge _____ g.p.m. Date of test _____

12. Tunnel: Type of lining

Dimensions: _____
(Length, course, and cross sectional size)

Position of water bearing stratum with reference to portal of tunnel _____

Log of tunnel: (Preceding table for log of well may be used, if desired. Give footage from portal and character of materials, as pertinent.)

13. Pumping Equipment:

(a) Pump Jacuzzi 1 1/2" centrifugal Capacity 200 g.p.m.
(Make, type and size)

(b) Motor 7 1/2 h. p. electric
(Type and horsepower)

14. Location of area irrigated or to be irrigated, or place of use if for purposes other than irrigation.

Township North or South	Range E. or W. of Willamette Meridian	Section	Forty-acre Tract	Number Acres To Be Irrigated	Date of Reclamation
11 S	2 W	15	N. W. 1/4 of S W 1/4	14.0	May 15, 1949
11S	2W	15	NE 1/4 of SW 1/4	19.0	May 15, 1949
11S	2W	15	NW 1/4 of SE 1/4	8.0	May 15, 1949
				41.0	


203-466

A part of the D. L. C. of Jeremiah Driggs and wife, Claim No. 48 in T. 11. S., R. 2 W. of the Will. Mer., Oregon, and beginning at a point that is 3.83 chains East from the Northwest corner of the D. L. C. of Jonathan Wassom and wife Claim No. 49 in said T. and running thences East 42 chains to the Southwest corner of Lot No. 5 of the land plat which is recorded on page 191, in Book K of Record of Deeds for Linn County, Oregon thence North 10.17 chains more or less, to a point 17.42 chains South of the North line of the D. L. C. of Jeremiah Driggs and wife, thence West parallel with the North line of said Driggs Claim 42 chains to a point due North of the place of beginning thence South 10.27 chains to the place of beginning containing 42.71 acres, more or less, all in Linn County, Oregon.

Also, beginning at a point on the North boundary line of the D. L. C. of Jonathan Wassom and wife, Not. No. 1186 and Claim No. 49 in T. 11 S., R. 2 W. of the Will. Mer., Oregon, which is 4 chains East of the Northwest corner of said donation land Claim, and running thence East 7.31 1/2 chains, thence South 3.02 1/2 chains, thence West 5.05 chains to the center of a creek, thence following down the center of said creek with meanderings thereof to the place of beginning, containing two acres, more or less all lying and being in Linn County, Oregon.

15. If the ground water supply is supplemental to an existing water supply, identification of any application for a permit, permit, certificate or adjudicated right to appropriate water made or held by the registrant.

Township 11 S. Range 2 W. W.M.
North

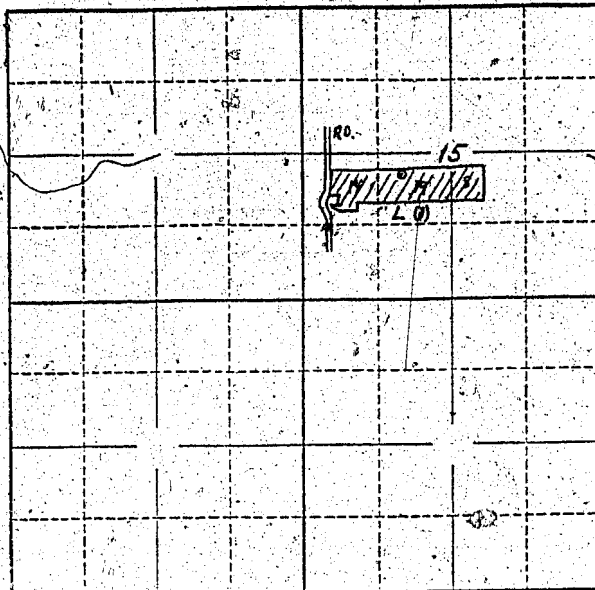

Locate well and acreage of irrigated land on plat.
Scale: 2" = 1 Mile

STATE OF OREGON }
County of Linn } ss.

I, Elmer L. and Jennie R. Perry, being first duly sworn, do hereby certify that I have read the foregoing Registration Statement and that all of the items therein contained are true to the best of my knowledge and belief.

Elmer L. Perry Jennie R. Perry
(Signature of Registrant)

Subscribed and sworn to before me this 17th day of APRIL 19 57

My commission expires JAN. 92TH, 1958.

Jessie Piper
(Notary Public)

(SEAL)

CERTIFICATE OF REGISTRATION

STATE OF OREGON }
County of Marion } ss.

This is to certify that the foregoing Registration Statement was received in the office of the State Engineer on the 22nd day of April 19 57, at 8:00 o'clock A.M. and has been duly recorded in said office in Book No. 3 of Registration Statements on page GR-434 C

Construction shall be completed by 3-19-58 and the water completely applied to beneficial use by 3-19-58

Witness my hand this 26th day of June 19 57

Lewis A. Standley
(State Engineer)

#16.65

By _____ (Deputy)