

Registration Statement CERTIFICATE NO. \_\_\_\_\_

OF CLAIMANT OF RIGHT TO APPROPRIATE GROUND WATER  
(Under Chapter 708, Oregon Laws 1955.)

TO THE STATE ENGINEER OF OREGON:

I, O. L. and Enelle Engel  
of Rt. 1, Box 335 A, Albany County of Linn

State of Oregon, do hereby make application for a certificate of registration as evidence of a right to appropriate ground water.

- 1. Source from which water is withdrawn is Pump well  
(Flowing well, pump well, infiltration trench, or tunnel)
- 2. Location is: 6 miles east of Albany, Oregon  
(Approximate distance and direction from nearest city or town)

and is more particularly described as follows:

(a) N. 63° E. 7.50 chains from the SW corner of S. 7, T. 11 S., R. 2 W.  
(Give distance and bearing to corner of section or other legal subdivision)  
being within SW $\frac{1}{4}$  of SW $\frac{1}{4}$  of Sec. 7, Twp. 11 S., Rge. 2 W.  
(Smallest legal subdivision) (N. or S.) (E. or W.)

or (b) within limits of recorded platted property, town or city: \_\_\_\_\_

in Lot \_\_\_\_\_, Block \_\_\_\_\_ of \_\_\_\_\_  
(Name of plat or addition)  
County of Linn  
(If within city or town, give name)

3. Construction Work was begun on Sept. 8, 1948; was completed on Sept. 12, 1948  
(Date) (Date)  
and the ground water claimed was first used for the purposes set out below on May 25, 1949  
(Date)

since which time the water has been used continuously  
(Continuously or intermittently)  
from May 25, 1949 to present time  
(Date) (Date)

4. Quantity of water claimed and used is 128 gallons per minute; 60 acre feet per year.

5. Purpose or Purposes for which water is used Irrigation  
(Domestic, irrigation, municipal, manufacturing, industrial, etc.)

6. Description of Well: Depth 87 feet. Type drilled  
(Dug or drilled)  
diameter 8 inches. Elevation of ground at well site 255 feet, mean sea level.  
(As near as known)  
Depth to water table 21 feet.

7. Capacity of Well: 240 g.p.m. with 40 feet drawdown.  
\_\_\_\_\_ g.p.m. with \_\_\_\_\_ feet drawdown.

Date of test Not tested

If Flowing Well: Measured discharge \_\_\_\_\_ g.p.m. on \_\_\_\_\_  
(Date)

Shut-in pressure at ground surface \_\_\_\_\_ lbs. per sq. in. on \_\_\_\_\_  
(Date)

Water is controlled by \_\_\_\_\_  
(Csp, valve, etc.)

8. **Casing:** (Give diameter, commercial specifications and depth below ground surface of each casing size.)

8 inch diameter steel casing from 0 to 87 feet  
inch diameter from to feet  
inch diameter from to feet  
inch diameter from to feet

Describe and show depth of shoe, plug, adapter, liner or other details: \_\_\_\_\_  
\_\_\_\_\_  
\_\_\_\_\_

9. **Perforated Casings or Screens:**

Slit perforations from 21 to 30  
(Number per foot and size of perforations, or describe screen)  
" from 70 to 87  
" from to  
" from to

10. **Log of Well:** (Describe each stratum or formation clearly, indicate if water bearing, and give thickness and depth as indicated.)

MATERIAL	Thickness (Feet)	Depth to Bottom (Feet)
Not available		

If log of well is not available, give name and address of driller: Sloper, Independence, Ore.

11. Infiltration Trench: Covered or open .....

Dimensions: Length ..... ft. Minimum depth ..... ft. Maximum depth ..... ft.  
 Bottom width ..... ft. Discharge ..... g.p.m. Date of test .....

12. Tunnel: Type of lining .....

Dimensions: .....  
(Length, course, and cross sectional size)

Position of water bearing stratum with reference to portal of tunnel .....

Log of tunnel: (Preceding table for log of well may be used, if desired. Give footage from portal and character of materials, as pertinent.)

13. Pumping Equipment:

(a) Pump Berkelley Deep well turbine ..... Capacity 250 ..... g.p.m.  
(Make, type and size)

(b) Motor 7½ H. P. electric .....  
(Type and horsepower)

14. Location of area irrigated or to be irrigated, or place of use if for purposes other than irrigation.


Township North or South	Range E. or W. of Willamette Meridian	Section	Forty-acre Tract	Number Acres To Be Irrigated	Date of Reclamation
11 S	2 W	7	SW¼ of SW¼	11.0	May 25, 1949
11 S	2 W	12	NW¼ of NW¼	10.0	May 25, 1949
				21.0	

117-247

Beginning 30 feet West of the intersection of the Township line between T. 11 S., R. 2 & 3 West with the South boundary line of Heshbon Farrish's D.L.C. Not. 1183, and Claims 44 & 57 in said T. and Ranges, running thence East 35.61 chains to the Southeast corner of said Not. 1183, thence North 29.86 chains, thence West 35.01 chains, thence South 29.86 chains to the place of beginning, containing 106.34 acres, all in Linn County, State of Oregon.


15. If the ground water supply is supplemental to an existing water supply, identification of any application for a permit, permit, certificate or adjudicated right to appropriate water made or held by the registrant.

Township 11 S Range 2 W, W.M.  
North

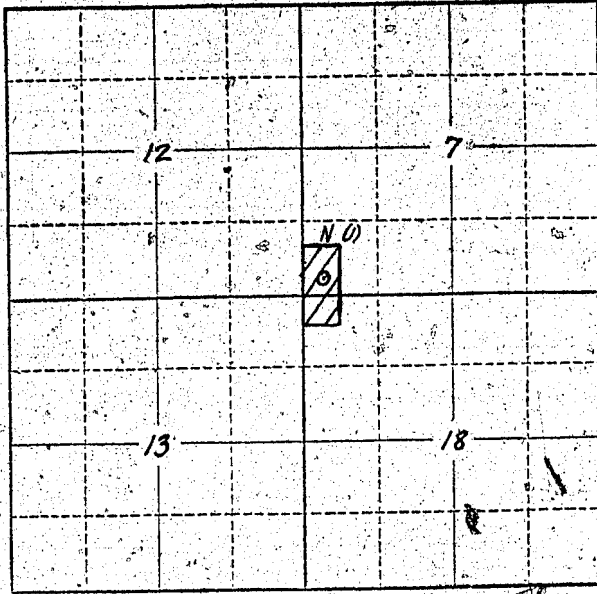

Locate well and acreage of irrigated land on plat.

Scale: 2" = 1 Mile

STATE OF OREGON

County of Linn

ss.

I, O. L. and Emelie Engel, being first duly sworn, do hereby certify that I have read the foregoing Registration Statement and that all of the items therein contained are true to the best of my knowledge and belief.

Otto G. Engel

Emelie Engel  
(Signature of Registrant)

Subscribed and sworn to before me this 17<sup>th</sup> day of April, 1957

My commission expires Oct 2-1957

J. M. Pifer  
(Notary Public)

(SEAL)

**CERTIFICATE OF REGISTRATION**

STATE OF OREGON

County of Marion

ss.

This is to certify that the foregoing Registration Statement was received in the office of the State Engineer on the 22nd day of April, 1957, at 8:00 o'clock A. M. and has been duly recorded in said office in Book No. 3 of Registration Statements on page GR-136 C.

~~Construction shall be completed by x-x-x-x-x-x-x-x-x-x-19-x-x and the water completely applied for beneficial use by x-x-x-x-x-x-x-x-x-x-19-x-x~~

Witness my hand this 26th day of June, 1957.

Lawrence A. Stanley  
(State Engineer)

\$15.00

By \_\_\_\_\_  
(Deputy)