

RECEIVED

APR 20 1957

STATE ENGINEER
OREGON

REGISTRATION NO. GR-452

CERTIFICATE NO. GR 437

Registration Statement

OF CLAIMANT OF RIGHT TO APPROPRIATE GROUND WATER

(Under Chapter 703, Oregon Laws 1955.)

TO THE STATE ENGINEER OF OREGON:

I, Carl D. Kendall Box 306
of Central Point County of Jackson

State of Oregon do hereby make application for a certificate of registration as evidence of a right to appropriate ground water.

1. Source from which water is withdrawn is Infiltration Trench
(Flowing well, pump well, infiltration trench, or tunnel)

2. Location is: 5 MI North Central Point
(Approximate distance and direction from nearest city or town)

and is more particularly described as follows:

(a) South 660 feet and West 65 feet from the NW corner of sec 21
(Give distance and bearing to corner of section or other legal subdivision)

being within NE & NW 1/4 of Sec. 21, Twp. 36S, Rge. 2W
(Smallest legal subdivision) (N. or S.) (E. or W.)

or (b) within limits of recorded platted property, town or city:

in Lot _____, Block _____ of _____
(Name of plat or addition)

County of _____
(If within city or town, give name)

3. Construction work was begun on May 21, 1949; was completed on May 15, 1949
(Date) (Date)

and the ground water claimed was first used for the purposes set out below on May 17, 1949
(Date)

since which time the water has been used Continuously
(Continuously or intermittently)

from May 17, 1949 to Aug. 31, 1956
(Date) (Date)

4. Quantity of water claimed and used is 80 gallons per minute; 9.6 acre feet per year.

5. Purpose or Purposes for which water is used

Irrigation
(Domestic, irrigation, municipal, manufacturing, industrial, etc.)

6. Description of Well: Depth _____ feet. Type _____
(Dug or drilled)

diameter _____ inches. Elevation of ground at well site 1170 feet, mean sea level.
(As near as known)

Depth to water table _____ feet.

7. Capacity of Well: _____ g.p.m. with _____ feet drawdown.

_____ g.p.m. with _____ feet drawdown.

Date of test _____

If Flowing Well: Measured discharge _____ g.p.m. on _____
(Date)

Shut-in pressure at ground surface _____ lbs. per sq. in. on _____
(Date)

Water is controlled by _____
(Cap, valve, etc.)

8. Casing: (Give diameter, commercial specifications and depth below ground surface of each casing size.)

..... inch diameter from to feet

..... inch diameter from to feet

..... inch diameter from to feet

..... inch diameter from to feet

Describe and show depth of shoe, plug, adapter, liner or other details:

.....

.....

9. Perforated Casings or Screens:

..... from to

(Number per foot and size of perforations, or describe screen)

..... from to

..... from to

..... from to

10. Log of Well: (Describe each stratum or formation clearly, indicate if water bearing, and give thickness and depth as indicated.)

MATERIAL	Thickness (Feet)	Depth to Bottom (Feet)

If log of well is not available, give name and address of driller.

11. Infiltration Trench: Covered or open Open

Dimensions: Length 80 ft. Minimum depth 20 ft. Maximum depth 25 ft.

Bottom width 40 ft. Discharge 7 g.p.m. Date of test

12. Tunnel: Type of lining

Dimensions:
(Length, course, and cross sectional size)

Position of water bearing stratum with reference to portal of tunnel

Log of tunnel: (Preceding table for log of well may be used, if desired. Give footage from portal and character of materials, as pertinent.)

13. Pumping Equipment:

(a) Pump Cornell 4" Capacity 100 g.p.m.
(Make, type and size)


(b) Motor Hercules 25 HP
(Type and horsepower)

14. Location of area irrigated or to be irrigated, or place of use if for purposes other than irrigation.

Township North or South	Range E. or W. of Willamette Meridian	Section	Forty-acre Tract	Number Acres To Be Irrigated	Date of Reclamation
<u>365</u>	<u>24</u>	<u>21</u>	<u>NE 1/4 NW 1/4</u>	<u>7.0 acres</u>	<u>May 1949</u>

15. If the ground water supply is supplemental to an existing water supply, identification of any application for a permit, permit, certificate or adjudicated right to appropriate water made or held by the registrant.

Township 36S Range 2W W.M.

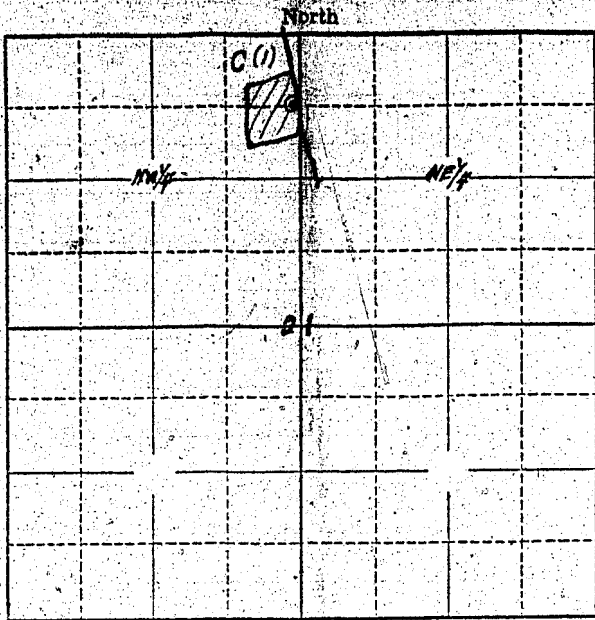

Locate well and acreage of irrigated land on plat.

Scale: $\frac{1}{4}$ " = 1 Mile

STATE OF OREGON

County of _____

C. D. Kendall, being first duly sworn, do hereby certify that I have read the foregoing Registration Statement and that all of the items therein contained are true to the best of my knowledge and belief.

C. D. Kendall
(Signature of Registrant)

Subscribed and sworn to before me this 31st day of August, 1951

My commission expires June 16, 1959

Pauline Lewis
(Notary Public)

(SEAL)

CERTIFICATE OF REGISTRATION

STATE OF OREGON

County of Marion

} ss.

This is to certify that the foregoing Registration Statement was received in the office of the State Engineer on the 22nd day of April, 1957, at 8:00 o'clock A. M. and has been duly recorded in said office in Book No. 3 of Registration Statements on page GR-437 C

~~Construction shall be completed by _____ and the water completely applied to beneficial use by _____~~

Witness my hand this 26th day of June, 1957

Lewis A. Stanley
(State Engineer)

By _____

(Deputy)

GR - 437 C

\$15.00