

RECEIVED

APR 27 1957

STATE ENGINEER
SALEM, OREGON

Registration No. GR 435
Certificate No. GR 514

Registration Statement

OF CLAIMANT OF RIGHT TO APPROPRIATE GROUND WATER

TO THE STATE ENGINEER OF OREGON:

I, PRODUCERS COOPERATIVE PACKING CO.

of P. O. Box 47 County of Marion
(Mailing address)

State of Oregon, do hereby make application for a certificate of registration as evidence of a right to appropriate ground water.

1. Source from which water is withdrawn is Pump Well
(Flowing well, pump well, infiltration trench, or tunnel)

2. Location is: 1695 N. Commercial St., Salem, Oregon
(Approximate distance and direction from nearest city or town)

and is more particularly described as follows: 800' East from N. W. corner of J. B. McLain DIC and Southerly along center line Commercial St. 60', thence westerly 70' - 6"

(a) Sketch attached
(Give distance and bearing to corner of section or other legal subdivision)

being within SE 1/4 SE 1/4 of Sec. 15, Twp. 7 S, Rge. 3 W
(Smallest legal subdivision) (N. or S.) (E. or W.)

or (b) within limits of recorded platted property, town or city: Salem

in Lot 19 of North Salem
(Name of plat or addition)

Salem County of Marion
(If within city or town, give name)

3. Construction Work was begun on April 10, 1933; was completed on May 15, 1933
(Date) (Date)

and the ground water claimed was first used for the purposes set out below on June 1933
(Date)

since which time the water has been used intermittently
(Continuously or intermittently)

from June 1933 to April 1957
(Date) (Date)

4. Quantity of water claimed and used is 250 at 40# pressure gallons per minute; acre feet per year.

5. Purpose or Purposes for which water is used Industrial

(Domestic, irrigation, municipal, manufacturing, industrial, etc.)

6. Description of Well: Depth 225 feet. Type drilled
(Dug or drilled)

diameter 8" inches. Elevation of ground at well site 179' feet, mean sea level.
(As near as known)

Depth to water table 20' feet.

7. Capacity of Well: 250 g.p.m. with 20 feet drawdown.

350 g.p.m. with 80 feet drawdown.


Date of test May 20, 1933

If Flowing Well: Measured discharge g.p.m. on (Date)

Shut-in pressure at ground surface lbs. per sq. in. on (Date)

Water is controlled by (Cap, valve, etc.)

Township 7 S Range 3 W, W.M.
North

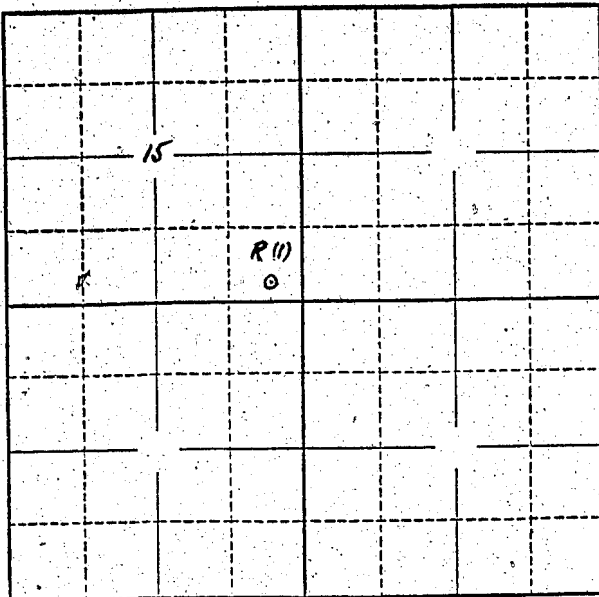

Locate well and acreage of irrigated land on plat.
Scale: 2" = 1 Mile

STATE OF OREGON

County of Marion

} ss.

I, E. P. Brown, Supt., being first duly sworn, do hereby certify that I have read the foregoing Registration Statement and that all of the items therein contained are true to the best of my knowledge and belief.

Producers Co-op. Packing Co.
(Signature of Registrant) E. P. Brown, Supt.

Subscribed and sworn to before me this 11th day of April, 1957.

My commission expires 7-22-60

Luck Skinner
(Notary Public)

(SEAL)

CERTIFICATE OF REGISTRATION

STATE OF OREGON

County of Marion

} ss.

This is to certify that the foregoing Registration Statement was received in the office of the State Engineer on the 23rd day of April, 1957, at 8:00 o'clock A. M. and has been duly recorded in said office in Book No. 3 of Registration Statements on page GR-514 C

Witness my hand this 24th day of July, 1957

Lewis A. Stanley
(State Engineer)

By _____
(Deputy)

#20

GR - 514 C