

RECEIVED  
APR 23 1957  
STATE ENGINEER  
SALEM OREGON

Registration No. GR 456

Certificate No. GR 440

# Registration Statement

## OF CLAIMANT OF RIGHT TO APPROPRIATE GROUND WATER

TO THE STATE ENGINEER OF OREGON:

I, J. D. Hight  
of 2810 Table Rock Road, Madford County of Jackson  
(Mailing address)  
State of Oregon, do hereby make application for a certificate of registration as evidence of a right to appropriate ground water.

1. Source from which water is withdrawn is pump well  
(Flowing well, pump well, infiltration trench, or tunnel)

2. Location is: 2 miles North of Madford, Oregon  
(Approximate distance and direction from nearest city or town)

and is more particularly described as follows:

(a) 1041 feet South and 180 feet East from the N<sup>1</sup> corner Section 13  
(Give distance and bearing to corner of section or other legal subdivision)

being within NW<sup>1</sup> NE<sup>1</sup> of Sec. 13, Twp. 37 S., Rge. 2 W.  
(Smallest legal subdivision) (N. or S.) (E. or W.)

or (b) within limits of recorded platted property, town or city:

in Lot \_\_\_\_\_, Block \_\_\_\_\_ of \_\_\_\_\_  
(Name of plat or addition)

County of \_\_\_\_\_  
(If within city or town, give name)

3. Construction Work was begun on April, 1947; was completed on May, 1947  
(Date) (Date)

and the ground water claimed was first used for the purposes set out below on June, 1947  
(Date)

since which time the water has been used continuously  
(Continuously or intermittently)

from June, 1947 to \_\_\_\_\_  
(Date) (Date)

4. Quantity of water claimed and used is 20 gallons per minute; 4.5 acre feet per year.

5. Purpose or Purposes for which water is used irrigation

(Domestic, irrigation, municipal, manufacturing, industrial, etc.)

6. Description of Well: Depth 10 feet. Type dug  
(Dug or drilled)

diameter 5 1/2 x 5 1/2 inches. Elevation of ground at well site 1280 feet, mean sea level.  
(As near as known)

Depth to water table 4.0 feet.

7. Capacity of Well: 20 g.p.m. with 4.0 feet drawdown.

\_\_\_\_\_ g.p.m. with \_\_\_\_\_ feet drawdown.

Date of test 1947

If Flowing Well: Measured discharge \_\_\_\_\_ g.p.m. on \_\_\_\_\_  
(Date)

Shut-in pressure at ground surface \_\_\_\_\_ lbs. per sq. in. on \_\_\_\_\_  
(Date)

Water is controlled by \_\_\_\_\_  
(Cap, valve, etc.)

8. Casing: (Give diameter, commercial specifications and depth below ground surface of each casing size.)

5.5' x 5.5' inch diameter Red wood cased from 0 to 7 feet  
 same inch diameter concrete from 7 to 10 feet  
 inch diameter from to feet  
 inch diameter from to feet

Describe and show depth of shoe, plug, adapter, liner or other details:

9. Perforated Casings or Screens:

(Number per foot and size of perforations, or describe screen)



from to  
 from to  
 from to  
 from to

10. Log of Well: (Describe each stratum or formation clearly, indicate if water-bearing, and give thickness and depth as indicated.)

MATERIAL	Thickness (Feet)	Depth to Bottom (Feet)

If log of well is not available, give name and address of driller. \_\_\_\_\_

11. Infiltration Trench: Covered or open \_\_\_\_\_

Dimensions: Length \_\_\_\_\_ ft. Minimum depth \_\_\_\_\_ ft. Maximum depth \_\_\_\_\_ ft.

Bottom width \_\_\_\_\_ ft. Discharge \_\_\_\_\_ g.p.m. Date of test \_\_\_\_\_

12. Tunnel: Type of lining \_\_\_\_\_

Dimensions: \_\_\_\_\_  
(Length, course, and cross sectional size)

Position of water bearing stratum with reference to portal of tunnel \_\_\_\_\_

Log of tunnel: (Preceding table for log of well may be used, if desired. Give footage from portal and character of materials, as pertinent.)

13. Pumping Equipment:

(a) Pump 1.0 inch centrifugal pump Capacity 20 g.p.m.  
(Make, type and size)


(b) Motor 1.0 H.P. electric motor.  
(Type and horsepower)

14. Location of area irrigated or to be irrigated, or place of use if for purposes other than irrigation.

Township North or South	Range E. or W. of Williamsite Meridian	Section	Forty-acre Tract	Number Acres To Be Irrigated	Date of Reclamation
37 S.	2 W.	13	NW $\frac{1}{4}$ NE $\frac{1}{4}$	1.0 acre	June, 1947

15. If the ground water supply is supplemental to an existing water supply, identification of any application for a permit, permit, certificate or adjudicated right to appropriate water made or held by the registrant.  
 none

Township 37.5 Range 2W W.M.  
North

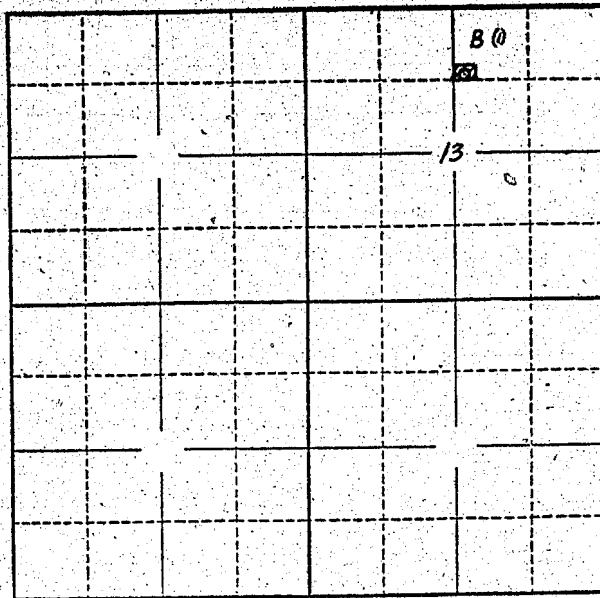

Locate well and acreage of irrigated land on plat.  
Scale: 2" = 1/2 Mile

STATE OF OREGON

County of Jackson

ss.

I, J.D. Hight, being first duly sworn, do hereby certify that I have read the foregoing Registration Statement and that all of the items therein contained are true to the best of my knowledge and belief.

J. D. Hight  
(Signature of Registrant)

Subscribed and sworn to before me this 22nd day of April, 1957.

My commission expires May 12th. 1957

[Signature]  
(Notary Public)

(SEAL)

### CERTIFICATE OF REGISTRATION

STATE OF OREGON

County of Marion

ss.

This is to certify that the foregoing Registration Statement was received in the office of the State Engineer on the 23rd day of April, 1957, at 8:00 o'clock A. M. and has been duly recorded in said office in Book No. 3 of Registration Statements on page GR-440 C.

Witness my hand this 26th day of June, 1957.

\$15.00

Lewis A. Stanley  
(State Engineer)

By \_\_\_\_\_ (Deputy)

GR - 440 C

GR 440