

Map #3

REGISTRATION NO. GR-459
CERTIFICATE NO. 443

Registration Statement

OF CLAIMANT OF RIGHT TO APPROPRIATE GROUND WATER

443

(Under Chapter 708, Oregon Laws 1955.)

TO THE STATE ENGINEER OF OREGON:

I, Fred Viesko
of Route 1, Box 105 Gervais County of Marion
State of Oregon, do hereby make application for a certificate of registration as evidence of a right to appropriate ground water.

1. Source from which water is withdrawn is Pump Well #1
(Flowing well, pump well, infiltration trench, or tunnel)
2. Location is: 6 ~~mi~~ miles ± S.W. from Gervais
(Approximate distance and direction from nearest city or town)

and is more particularly described as follows:

(a) S45°20'W 2084.8' from angle point in S line in
(Give distance and bearing to corner of section or other legal subdivision)
being within SE 1/4 of SW 1/4 of Sec. 3 Twp. 6S Rge. 3W
(Smallest legal subdivision) (N. or S.) (E. or W.)

or (b) within limits of recorded platted property, town or city:
in Lot _____, Block _____ of _____
(Name of plat or addition)
County of _____
(If within city or town, give name)

3. Construction Work was begun on April 15, 1947, was completed on April 15, 1948
(Date) (Date)
and the ground water claimed was first used for the purposes set out below on April 15, 1947
(Date)

since which time the water has been used Continuously
(Continuously or Intermittently)
from April 15, 1947 to April 15, 1957
(Date) (Date)

4. Quantity of water claimed and used is 211 gallons per minute; _____ acre feet per year.

5. Purpose or Purposes for which water is used Irrigation
(Domestic, irrigation, municipal, manufacturing, industrial, etc.)

6. Description of Well: Depth 40± feet. Type Drilled
(Dug or drilled)
diameter 10 inches. Elevation of ground at well site 105± feet, mean sea level.
(As near as known)
Depth to water table 12± feet.

7. Capacity of Well: UNKNOWN g.p.m. with _____ feet drawdown.
_____ g.p.m. with _____ feet drawdown.

Date of test _____

If Flowing Well: Measured discharge _____ g.p.m. on _____
(Date)

Shut-in pressure at ground surface _____ lbs. per sq. in. on _____
(Date)

Water is controlled by _____
(Cap, valve, etc.)

8. Casing: (Give diameter, commercial specifications and depth below ground surface of each casing size.)

10" inch diameter Steel Casing from to feet
..... inch diameter from to feet
..... inch diameter from to feet
..... inch diameter from to feet

Describe and show depth of shoe, plug, adapter, liner or other details:
.....
.....

9. Perforated Casings or Screens:

UNKNOWN from to
(Number per foot and size of perforations, or describe screen)
..... from to
..... from to
..... from to

10. Log of Well: (Describe each stratum or formation clearly, indicate if water bearing, and give thickness and depth as indicated.)

MATERIAL	Thickness (Feet)	Depth to Bottom (Feet)
<u>Sandy loam</u>	<u>10'</u>	<u>0-10</u>
<u>Sand & Gravel</u>	<u>20'</u>	<u>10-30</u>
<u>Gravel</u>	<u>20</u>	<u>30-40</u>

If log of well is not available, give name and address of driller. _____

11. Infiltration Trench: Covered or open _____

Dimensions: Length _____ ft. Minimum depth _____ ft. Maximum depth _____ ft.

Bottom width _____ ft. Discharge _____ g.p.m. Date of test _____

12. Tunnel: Type of lining _____

Dimensions: _____
(Length, course, and cross sectional size)

Position of water bearing stratum with reference to portal of tunnel _____

Log of tunnel: (Preceding table for log of well may be used, if desired. Give footage from portal and character of materials, as pertinent.)

13. Pumping Equipment:

(a) Pump centrifugal _____ Capacity 600 g.p.m.
(Make, type and size)


(b) Motor 90 electric _____
(Type and horsepower)

14. Location of area irrigated or to be irrigated, or place of use if for purposes other than irrigation.

Township North or South	Range E. or W. of Willamette Meridian	Section	Forty-acre Tract	Number Acres To Be Irrigated	Date of Reclamation
6S	3W	3	NE 1/4 of SW 1/4	9.2	July 30, 1997
6S	3W	3	SE 1/4 of SW 1/4	2.0	" " "
6S	3W	3	SW 1/4 of SE 1/4	6.7	" " "
6S	3W	3	NN 1/4 of SE 1/4	19.7	" " "
Total				37.60	

15. If the ground water supply is supplemental to an existing water supply, identification of any application for a permit, permit, certificate or adjudicated right to appropriate water made or held by the registrant.

Township 6S Range 3W, W.M.
North

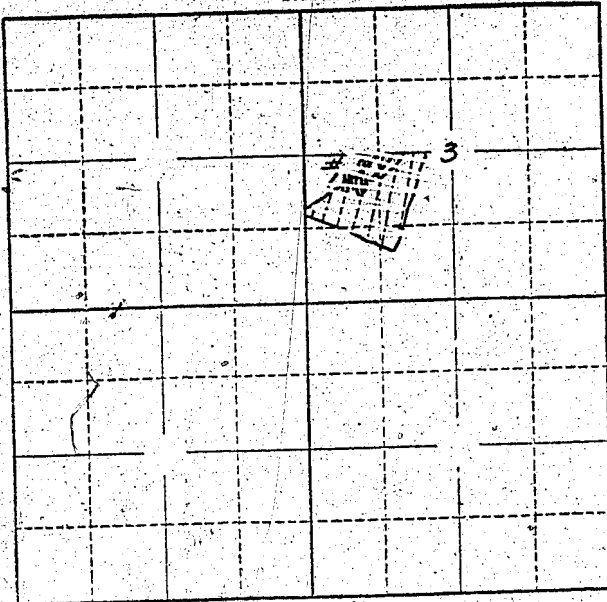

Locate well and acreage of irrigated land on plat.

Scale: 1 Mile

STATE OF OREGON

County of _____

} ss.

I, _____, being first duly sworn, do hereby certify that I have read the foregoing Registration Statement and that all of the items therein contained are true to the best of my knowledge and belief.

Fred Wishe
(Signature of Registrant)

Subscribed and sworn to before me this _____ day of _____, 19_____

My commission expires _____

(Notary Public)

(SEAL)

See Page GR-113-G for
CERTIFICATE OF REGISTRATION

STATE OF OREGON

County of Marion

} ss.

~~This is to certify that the foregoing Registration Statement was received in the office of the State Engineer on the X-X-X-X day of X-X-X-X 19-X-X-X-X and has been duly recorded in my office in Book No. X-X-X-X of Registration Statements, page X-X-X-X. Construction shall be completed by X-X-X-X 19-X-X and the water completely applied to beneficial use by X-X-X-X 19-X-X.~~

Witness my hand this _____ day of _____, 19_____

(State Engineer)

By _____

(Deputy)

Registration Statement CERTIFICATE NO. 443

OF CLAIMANT OF RIGHT TO APPROPRIATE GROUND WATER

443

(Under Chapter 708, Oregon Laws 1955.)

TO THE STATE ENGINEER OF OREGON:

I, Fred Viesko

of Rt. 1 Box 105 Gervais County of Marion

State of Oregon do hereby make application for a certificate of registration as evidence of a right to appropriate ground water.

1. Source from which water is withdrawn Pump Well #2

(Flowing well, pump well, infiltration trench, or tunnel)

2. Location is: 6 Miles ± SW from Gervais

(Approximate distance and direction from nearest city or town)

and is more particularly described as follows:

(a) 535°0'W 76' from angle point in S line W. Mathewcy # 2

(Give distance and bearing to corner of section or other legal subdivision)

being within NW 1/4 of SE 1/4 of Sec. 3, Twp. 6 S, Rge. 3 W

(Smallest legal subdivision)

(N. or S.)

(E. or W.)

or (b) within limits of recorded platted property, town or city:

in Lot Block of

(Name of plat or addition)

County of

(If within city or town, give name)

3. Construction Work was begun on April 30, 1947 was completed on May 15, 1947

(Date)

(Date)

and the ground water claimed was first used for the purposes set out below on August 15, 1947

(Date)

since which time the water has been used continuously

(Continuously or Intermittently)

from August 15, 1947 April 15, 1957

(Date)

(Date)

4. Quantity of water claimed and used is 220 gallons per minute; acre feet per year.

5. Purpose or Purposes for which water is used Irrigation

(Domestic, irrigation, municipal, manufacturing, industrial, etc.)

6. Description of Well: Depth 40 feet. Type Drilled

(Dug or drilled)

diameter 10 inches. Elevation of ground at well site 105 feet, mean sea level.

(As near as known)

Depth to water table 15 feet.

7. Capacity of Well: Unknown g.p.m. with feet drawdown.

g.p.m. with feet drawdown.

Date of test

If Flowing Well: Measured discharge g.p.m. on

(Date)

Shut-in pressure at ground surface lbs. per sq. in. on

(Date)

Water is controlled by

(Cap, valve, etc.)

8. Casing: (Give diameter, commercial specifications and depth below ground surface of each casing size.)

10 inch diameter Steel casing from Top to 40± feet
inch diameter from to feet
inch diameter from to feet
inch diameter from to feet

Describe and show depth of shoe, plug, adapter, liner or other details:

9. Perforated Casings or Screens:

Unknown from to
(Number per foot and size of perforations, or describe screen)
from to
from to
from to

10. Log of Well: (Describe each stratum or formation clearly, indicate if water bearing, and give thickness and depth as indicated.)

MATERIAL	Thickness (Feet)	Depth to Bottom (Feet)
Sandy Loam	10'	0-10
Sand + Gravel	25'	10-35
Gravel	5	35-40

If log of well is not available, give name and address of driller.

11. Infiltration Trench: Covered or open

Dimensions: Length ft. Minimum depth ft. Maximum depth ft.

Bottom width ft. Discharge g.p.m. Date of test

12. Tunnel: Type of lining

Dimensions:
(Length, course, and cross sectional size)

Position of water bearing stratum with reference to portal of tunnel

Log of tunnel: (Preceding table for log of well may be used, if desired. Give footage from portal and character of materials, as pertinent.)

13. Pumping Equipment:

(a) Pump Centrifugal Capacity 600 g.p.m.
(Make, type and size)


(b) Motor 40 horse power electric
(Type and horsepower)

14. Location of area irrigated or to be irrigated, or place of use if for purposes other than irrigation.

Township North or South	Range E. or W. of Willamette Meridian	Section	Forty-acre Tract	Number Acres To Be Irrigated	Date of Reclamation
6S	3W	3	SW 1/4 NE 1/4	1.17	August 30, 1991
6S	3W	3	NW 1/4 SE 1/4	18.90	" " "
6S	3W	3	NE 1/4 SE 1/4	16.00	" " "
6S	3W	3	SE 1/4 NE 1/4	5.40	" " "
			<u>Total</u>	<u>39.47</u>	

15. If the ground water supply is supplemental to an existing water supply, identification of any application for a permit, permit, certificate or adjudicated right to appropriate water made or held by the registrant.

Township 6S Range 3W W.M.
North

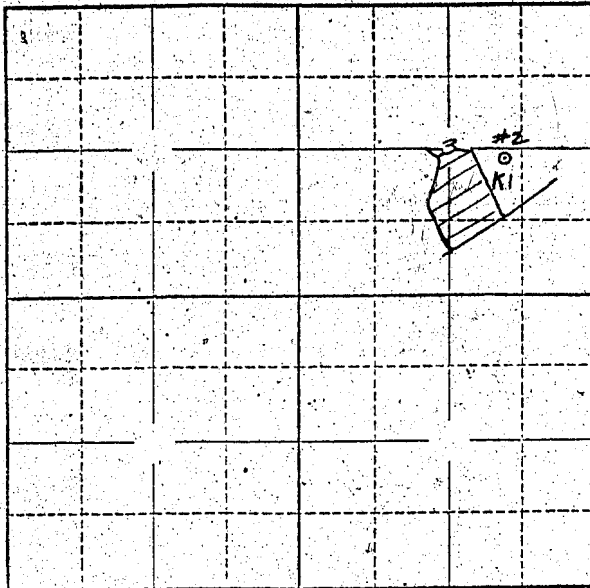

Locate well and acreage of irrigated land on plat.
Scale: 2" = 1 Mile

STATE OF OREGON

County of Marion } ss.

I, Fred Veeho, being first duly sworn, do hereby certify that I have read the foregoing Registration Statement and that all of the items therein contained are true to the best of my knowledge and belief.

Fred Veeho
(Signature of Registrant)

Subscribed and sworn to before me this 22 day of April, 1957

My commission expires March 16, 1958

James B. Hatfield
(Notary Public)

(SEAL)

CERTIFICATE OF REGISTRATION

STATE OF OREGON

County of Marion } ss.

This is to certify that the foregoing Registration Statement was received in the office of the State Engineer on the 26th day of April, 1957, at 10:00 o'clock A. M. and has been duly recorded in said office in Book No. 3 of Registration Statements on page GR-443 G.

~~Construction shall be completed by X-X-X-X-X-X-X-X-X-X-X-X-X-X-X-X and the water completely applied to beneficial use by X-X-X-X-X-X-X-X-X-X-X-X-X-X-X-X //~~

Witness my hand this 26th day of June, 1957

Lewis A. Stanley
(State Engineer)

By _____ (Deputy)