

RECEIVED  
APR 20 1957  
STATE ENGINEER  
SALEM, OREGON

### Registration Statement

#### OF CLAIMANT OF RIGHT TO APPROPRIATE GROUND WATER

(Under Chapter 708, Oregon Laws 1955.)

RECEIVED  
NOV 18 1957  
STATE ENGINEER  
SALEM, OREGON

TO THE STATE ENGINEER OF OREGON:

I, Bernard A. Massey  
of Junction City County of Wasco

State of Oregon, do hereby make application for a certificate of registration as evidence of a right to appropriate ground water.

1. Source from which water is withdrawn is \_\_\_\_\_  
(Flowing well, pump well, infiltration trench, or tunnel)

2. Location is: \_\_\_\_\_  
(Approximate distance and direction from nearest city or town)

and is more particularly described as follows:

(a) 16 3/4' of NW 1/4 (Give distance and bearing to corner of section or other legal subdivision)

being within \_\_\_\_\_ of Sec. \_\_\_\_\_ Twp. \_\_\_\_\_ Rge. \_\_\_\_\_  
(Smallest legal subdivision) (N. or S.) (E. or W.)

or (b) within limits of recorded platted property, town or city: \_\_\_\_\_

in Lot \_\_\_\_\_, Block \_\_\_\_\_ of \_\_\_\_\_  
(Name of plat or addition)

County of \_\_\_\_\_  
(If within city or town, give name)

3. Construction Work was begun on \_\_\_\_\_; was completed on \_\_\_\_\_  
(Date) (Date)

and the ground water claimed was first used for the purposes set out below on \_\_\_\_\_  
(Date)

since which time the water has been used \_\_\_\_\_  
(Continuously or Intermittently)

from July 1953 to present  
(Date) (Date)

4. Quantity of water claimed and used is 120 gallons per minute; \_\_\_\_\_ acre feet per year.

5. Purpose or Purposes for which water is used irrigation  
(Domestic, irrigation, municipal, manufacturing, industrial, etc.)

6. Description of Well: Depth 31 feet. Type \_\_\_\_\_  
(Dug or drilled)

diameter 4 inches. Elevation of ground at well site 355 feet, mean sea level.  
(As near as known)

Depth to water table 7 feet.

7. Capacity of Well: 150 g.p.m. with 8 feet drawdown.

175 g.p.m. with 8 feet drawdown.

Date of test JULY 1953

If Flowing Well: Measured discharge \_\_\_\_\_ g.p.m. on \_\_\_\_\_  
(Date)

Shut-in pressure at ground surface \_\_\_\_\_ lbs. per sq. in. on \_\_\_\_\_  
(Date)

Water is controlled by \_\_\_\_\_  
(Cap, valve, etc.)

8. Casing: (Give diameter, commercial specifications and depth below ground surface of each casing size.)

4 inch diameter Steel from 0 to 21 feet  
inch diameter from to feet  
inch diameter from to feet  
inch diameter from to feet

Describe and show depth of shoe, plug, adapter, liner or other details:

9. Perforated Casings or Screens:

from to  
(Number per foot and size of perforations, or describe screen)  
from to  
from to  
from to

10. Log of Well: (Describe each stratum or formation clearly, indicate if water bearing, and give thickness and depth as indicated.)

MATERIAL	Thickness (Feet)	Depth to Bottom (Feet)
<u>Sandy loam</u>	<u>7</u>	<u>7</u>
<u>Sandy Gravel</u>	<u>14</u>	<u>21</u>

If log of well is not available, give name and address of driller: .....

11. Infiltration Trench: Covered or open .....

Dimensions: Length ..... ft. Minimum depth ..... ft. Maximum depth ..... ft.

Bottom width ..... ft. Discharge ..... g.p.m. Date of test .....

12. Tunnel: Type of lining .....

Dimensions: .....  
(Length, course, and cross sectional size)

Position of water bearing stratum with reference to portal of tunnel .....

Log of tunnel: (Preceding table for log of well may be used, if desired. Give footage from portal and character of materials, as pertinent.)

13. Pumping Equipment:

(a) Pump ..... Capacity ..... g.p.m.  
(Make, type and size)


(b) Motor .....  
(Type and horsepower)

14. Location of area irrigated or to be irrigated, or place of use if for purposes other than irrigation.

Township North or South	Range E. or W. of Willamette Meridian	Section	Forty-acre Tract	Number Acres To Be Irrigated	Date of Reclamation
10	9	27	SE 1/4 of NW 1/4	14	July 1953

15. If the ground-water supply is supplemental to an existing water supply, identification of any application for a permit, permit, certificate or adjudicated right to appropriate water made or held by the registrant.

Township 11.5 Range 3 W.M.  
North

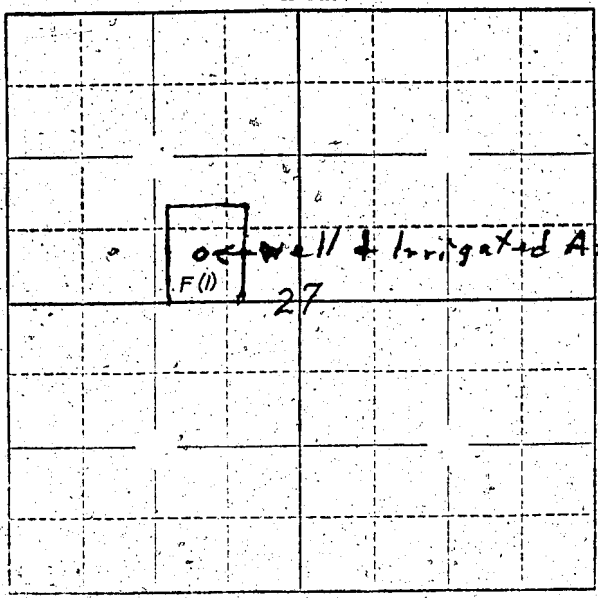

Locate well and acreage of irrigated land on plat.

Scale: 2" = 1 Mile  
4 = 1 "

STATE OF OREGON

County of Marion } ss.

I, Benjamin A. Mangel, being first duly sworn, do hereby certify that I have read the foregoing Registration Statement and that all of the items therein contained are true to the best of my knowledge and belief.

Benjamin A. Mangel  
(Signature of Registrant)

Subscribed and sworn to before me this 22<sup>nd</sup> day of Nov, 1957.

My commission expires April 11, 1966 William S. Stewart  
(Notary Public)

(SEAL)

**CERTIFICATE OF REGISTRATION**

STATE OF OREGON }  
County of Marion } ss.

This is to certify that the foregoing Registration Statement was received in the office of the State Engineer on the 29th day of April, 1957, at 8:00 o'clock A. and has been duly recorded in said office in Book No. 4 of Registration Statements on page GR-650 C.

~~Construction shall be completed by X-X-X-X-X-X-X-X, 1958, and the water completely applied to the fields by X-X-X-X-X-X-X-X, 1958.~~

Witness my hand this 2nd day of January, 1958.

Lewis A. Stanley  
(State Engineer)

By \_\_\_\_\_  
(Deputy)

GR-650 C.