

RECEIVED
APR 30 1957
STATE ENGINEER
SALES OFFICE

REGISTRATION NO. G.R. 464
CERTIFICATE NO. OR 446

Registration Statement

OF CLAIMANT OF RIGHT TO APPROPRIATE GROUND WATER

(Under Chapter 708, Oregon Laws 1955.)

TO THE STATE ENGINEER OF OREGON:

I, Mrs. Kate S. Nelson
of 3378 Bellinger Lane, Medford County of Jackson
State of Oregon, do hereby make application for a certificate of registration as evidence
of a right to appropriate ground water.

1. Source from which water is withdrawn is Pump Well #1
(Flowing well, pump well, infiltration trench, or tunnel)

2. Location is: 5 1/2 miles Southwest of Medford, Oregon
(Approximate distance and direction from nearest city or town)

and is more particularly described as follows:

(a) 885 feet North and 2815 feet East from the SW corner DLC. #78
(Give distance and bearing to corner of section or other legal subdivision)

being within SW 1/4 NE 1/4 of Sec. 34 Twp. 37 S. Rge. 2 W.
(Smallest legal subdivision) (N. or S.) (E. or W.)

or (b) within limits of recorded platted property, town or city:

in Lot _____, Block _____ of _____
(Name of plat or addition)
County of _____
(If within city or town, give name)

3. Construction Work was begun on 1895 (est.); was completed on 1905 (est.)
(Date) (Date)

and the ground water claimed was first used for the purposes set out below on 1895 (est.)
(Date)

since which time the water has been used continuously
(Continuously or intermittently)

from 1895 (est.) to date
(Date) (Date)

4. Quantity of water claimed and used is 255 gallons per minute; 190 acre
feet per year.

5. Purpose or Purposes for which water is used irrigation

(Domestic, irrigation, municipal, manufacturing, industrial, etc.)

6. Description of Well: Depth 26 feet. Type drug (covered)
(Dug or drilled)

diameter 10 feet inches. Elevation of ground at well site 1150 feet, mean sea level.
(As near as known)

Depth to water table 5.0 feet.

7. Capacity of Well: not known g.p.m. with _____ feet drawdown.

_____ g.p.m. with _____ feet drawdown.

Date of test _____

If Flowing Well: Measured discharge _____ g.p.m. on _____
(Date)

Shut-in pressure at ground surface _____ lbs. per sq. in. on _____
(Date)

Water is controlled by _____
(Cap, valve, etc.)

8. **Casing:** (Give diameter, commercial specifications and depth below ground surface of each casing size.)

Note: this hand dug well is lined
 inch diameter from to feet
 inch diameter with brick from top to bottom to feet
 inch diameter from to feet
 inch diameter from to feet

Describe and show depth of shoe, plug, adapter, liner or other details:

9. **Perforated Casings or Screens:**

..... from to
 (Number per foot and size of perforations, or describe screen)
 from to
 from to
 from to

10. **Log of Well:** (Describe each stratum or formation clearly, indicate if water bearing, and give thickness and depth as indicated.)

MATERIAL	Thickness (Feet)	Depth to Bottom (Feet)
not known		

If log of well is not available, give name and address of driller. not known

11. Infiltration Trench; Covered or open

Dimensions: Length ft. Minimum depth ft. Maximum depth ft.

Bottom width ft. Discharge g.p.m. Date of test

12. Tunnel: Type of lining

Dimensions:
(Length, course, and cross sectional size)

Position of water bearing stratum with reference to portal of tunnel

Log of tunnel: (Preceding table for log of well may be used, if desired. Give footage from portal and character of materials, as pertinent.)

13. Pumping Equipment:

(a) Pump 2.5 inch centrifugal pump Capacity 255 g.p.m.
(Make, type and size)

(b) Motor 27 H.P. Ford Industrial Gasoline Engine
(Type and horsepower)

14. Location of area irrigated or to be irrigated, or place of use if for purposes other than irrigation.

Township/ North or South	Range E. or W. of Willamette Meridian	Section	Forty-acre Tract	Number Acres To Be Irrigated	Date of Reclamation
37 S.	2 W.	34	SW $\frac{1}{4}$ NE $\frac{1}{4}$	33.8 acres	1895 (est.)
"	"	"	SE $\frac{1}{4}$ NW $\frac{1}{4}$	5.2 acres	1895 (est.)
"	"	"	NE $\frac{1}{4}$ SW $\frac{1}{4}$	0.5 acre	1895 (est.)
"	"	"	NW $\frac{1}{4}$ SE $\frac{1}{4}$	3.0 acres	1895 (est.)
"	"	"	Total	42.5 acres	

15. If the ground water supply is supplemental to an existing water supply, identification of any application for a permit, permit, certificate or adjudicated right to appropriate water made or held by the registrant.

None

RECEIVED
APR 30 1957

REGISTRATION NO. C-R-464
446

Registration Statement

CERTIFICATE NO. _____

OF CLAIMANT OF RIGHT TO APPROPRIATE GROUND WATER

(Under Chapter 708, Oregon Laws 1955.)

TO THE STATE ENGINEER OF OREGON:

I, Mrs. Kate S. Nelson

of 337d Ballinger Lane, Medford, County of Jackson

State of Oregon, do hereby make application for a certificate of registration as evidence of a right to appropriate ground water.

1. Source from which water is withdrawn is Pump Well #2
(Flowing well, pump well, infiltration trench, or tunnel)

2. Location is: 3 1/2 miles southwest of Medford, Oregon
(Approximate distance and direction from nearest city or town)

and is more particularly described as follows:

(a) 735 feet N. & 2570 feet E. from the SW corner DLC #78
(Give distance and bearing to corner of section or other legal subdivision)

being within SW 1/4 NE 1/4 of Sec. 34, Twp. 27 S., Rge. 2 W.
(Smallest legal subdivision) (N. or S.) (E. or W.)

or (b) within limits of recorded platted property, town or city:

in Lot _____, Block _____ of _____
(Name of plat or addition)

County of _____
(If within city or town, give name)

3. Construction Work was begun on Dec. 1949; was completed on Dec. 1949
(Date) (Date)

and the ground water claimed was first used for the purposes set out below on April 1950
(Date)

since which time the water has been used continuously
(Continuously or intermittently)

from Apr. 1950 to _____ date
(Date) (Date)

4. Quantity of water claimed and used is 10 gallons per minute; 4.5 acre feet per year.

5. Purpose or Purposes for which water is used irrigation

(Domestic, irrigation, municipal, manufacturing, industrial, etc.)

6. Description of Well: Depth 98 feet. Type drilled well
(Dug or drilled)

diameter 6.0 inches. Elevation of ground at well site 1450 feet, mean sea level.
(As near as known)

Depth to water table 10 (a.s.t.) feet.

7. Capacity of Well: not known g.p.m. with _____ feet drawdown.

_____ g.p.m. with _____ feet drawdown.

Date of test _____

If Flowing Well: Measured discharge _____ g.p.m. on _____
(Date)

Shut-in pressure at ground surface _____ lbs. per sq. in. on _____
(Date)

Water is controlled by _____
(Cap, valve, etc.)

8. **Casing:** (Give diameter, commercial specifications and depth below ground surface of each casing size.)

..... inch diameter not known..... from..... to..... feet
..... inch diameter..... from..... to..... feet
..... inch diameter..... from..... to..... feet
..... inch diameter..... from..... to..... feet

Describe and show depth of shoe, plug, adapter, liner or other details: not known

9. **Perforated Casings or Screens:**

not known from..... to.....
(Number per foot and size of perforations, or describe screen)
..... from..... to.....
..... from..... to.....
..... from..... to.....

10. **Log of Well:** (Describe each stratum or formation clearly, indicate if water bearing, and give thickness and depth as indicated.)

MATERIAL	Thickness (Feet)	Depth to Bottom (Feet)
<u>not known</u>		

If log of well is not available, give name and address of driller, Myron D. Andrews

1800 Stratford Avenue, Medford, Oregon

11. Infiltration Trench: Covered or open _____

Dimensions: Length _____ ft. Minimum depth _____ ft. Maximum depth _____ ft.

Bottom width _____ ft. Discharge _____ g.p.m. Date of test _____

12. Tunnel: Type of lining _____

Dimensions: _____
(Length, course, and cross sectional size)

Position of water bearing stratum with reference to portal of tunnel _____

Log of tunnel: (Preceding table for log of well may be used, if desired. Give footage from portal and character of materials, as pertinent.)

13. Pumping Equipment:

(a) Pump 1.0 inch submersible pump Capacity 10 (est.) g.p.m.
(Make, type and size)

(b) Motor 1/2 H.P. electric motor.
(Type and horsepower)


14. Location of area irrigated or to be irrigated, or place of use if for purposes other than irrigation.

Township North or South	Range E. or W. of Willamette Meridian	Section	Forty-acre Tract	Number Acres To Be Irrigated	Date of Reclamation
37 S.	2 W.	34	SW $\frac{1}{4}$ NE $\frac{1}{4}$	1.0 acres	April, 1950

15. If the ground water supply is supplemental to an existing water supply, identification of any application for a permit, permit, certificate or adjudicated right to appropriate water made or held by the registrant.

none

Township 37.5 Range 24, W.M.
North

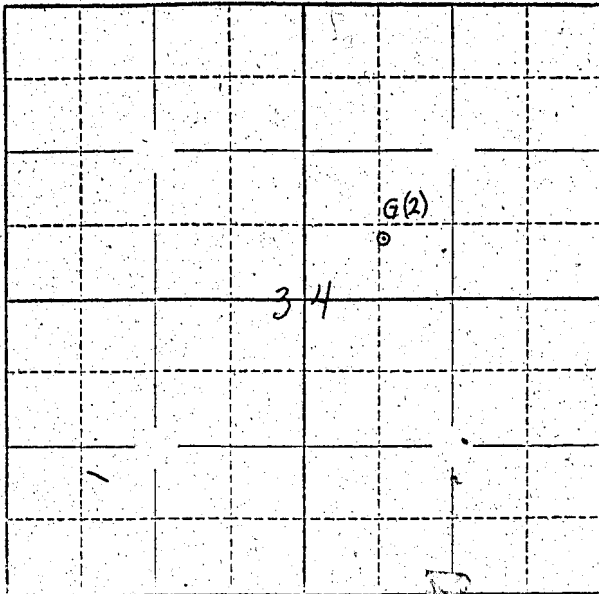

Locate well and acreage of irrigated land on plat.

Scale: 1" = 1 Mile
4" = 1 "

STATE OF OREGON

County of Jackson

} ss.

I, Mrs. Kate S. Nelson, being first duly sworn, do hereby certify that I have read the foregoing Registration Statement and that all of the items therein contained are true to the best of my knowledge and belief.

X Kate S. Nelson
(Signature of Registrant)

Subscribed and sworn to before me this 29th day of April, 1957.

My commission expires Nov. 23 - 1960

Gaydah Weis
(Notary Public)

(SEAL)

See Page GR-446 K for
CERTIFICATE OF REGISTRATION

STATE OF OREGON

County of Marion

} ss.

~~I hereby certify that the foregoing Registration Statement was received in the office of the State Engineer on this day of at o'clock and has been recorded in said office in Book No. of Registration Statements on page. Good faith shall be maintained by and the correct copy shall be kept by the State Engineer.~~

~~Witness my hand this day of 1957.~~

(State Engineer)

By _____
(Deputy)

RECEIVED
APR 30 1957
STATE ENGINEER
SALMON DIVISION

Registration No. GR G.R. 464
Certificate No. GR 446

Registration Statement

OF CLAIMANT OF RIGHT TO APPROPRIATE GROUND WATER

TO THE STATE ENGINEER OF OREGON:

I, Mrs. Kate S. Nelson

of 3378 Bellinger Lane, Medford, County of Jackson
(Mailing address)

State of Oregon, do hereby make application for a certificate of registration as evidence of a right to appropriate ground water.

1. Source from which water is withdrawn is Infiltration trench
(Flowing well, pump well, infiltration trench, or tunnel)

2. Location is: approximately 3 1/2 miles southwest of Medford, Oregon
(Approximate distance and direction from nearest city or town)

and is more particularly described as follows:

(a) 800 feet North and 1330 feet East from the SW corner D.L.C. #78
(Give distance and bearing to corner of section or other legal subdivision)

being within SE 1/4 NW 1/4 of Sec. 34, Twp. 37 S., Rge. 2 W.
(Smallest legal subdivision) (N. or S.) (E. or W.)

or (b) within limits of recorded platted property, town or city:

in Lot _____, Block _____ of _____
(Name of plat or addition)

County of _____
(If within city or town, give name)

3. Construction Work was begun on 1950; was completed on 1950
(Date) (Date)

and the ground water claimed was first used for the purposes set out below on 1950
(Date)

since which time the water has been used continuously
(Continuously or intermittently)

from 1950 to date
(Date) (Date)

4. Quantity of water claimed and used is 255 gallons per minute; 202 acre feet per year.

5. Purpose or Purposes for which water is used irrigation.

(Domestic, irrigation, municipal, manufacturing, industrial, etc.)

See Item 11 Description of Well: Depth 20 feet. Type dug
(Dug or drilled)

diameter 30" x 60" inches. Elevation of ground at well site 1150 feet, mean sea level.
(As near as known)

Depth to water table 2.0 feet.

7. Capacity of Well: _____ g.p.m. with _____ feet drawdown.

_____ g.p.m. with _____ feet drawdown.

Date of test _____

If Flowing Well: Measured discharge _____ g.p.m. on _____
(Date)

Shut-in pressure at ground surface _____ lbs. per sq. in. on _____
(Date)

Water is controlled by _____
(Cap, valve, etc.)

- 446 H

8. Casing: (Give diameter, commercial specifications and depth below ground surface of each casing size.)

..... inch diameter from to feet
..... inch diameter from to feet
..... inch diameter from to feet
..... inch diameter from to feet

Describe and show depth of shoe, plug, adapter, liner or other details:
.....
.....

9. Perforated Casings or Screens:

..... from to
(Number per foot and size of perforations, or describe screen)
..... from to
..... from to
..... from to

10. Log of Well: (Describe each stratum or formation clearly, indicate if water bearing, and give thickness and depth as indicated.)

MATERIAL	Thickness (Feet)	Depth to Bottom (Feet)

If log of well is not available, give name and address of driller:

11. Infiltration Trench: Covered or open open

Dimensions: Length 60 ft. Minimum depth 12 ft. Maximum depth 20 ft.

Bottom width 30 ft. Discharge -- g.p.m. Date of test none

12. Tunnel: Type of lining

Dimensions:
(Length, course, and cross sectional size)

Position of water bearing stratum with reference to portal of tunnel

Log of tunnel: (Preceding table for log of well may be used, if desired. Give footage from portal and character of materials, as pertinent.)

13. Pumping Equipment:

(a) Pump 2.5 inch centrifugal pump Capacity 255 g.p.m.
(Make, type and size)

(b) Motor 27 H.P. Ford Industrial Gasoline engine.
(Type and horsepower)


14. Location of area irrigated or to be irrigated, or place of use if for purposes other than irrigation.

Township North or South	Range E. or W. of Willamette Meridian	Section	Forty-acre Tract	Number Acres To Be Irrigated	Date of Reclamation
37 S.	2 W.	34	SW $\frac{1}{4}$ NE $\frac{1}{4}$	17.4 acres	1950
			SE $\frac{1}{4}$ NW $\frac{1}{4}$	23.0 acres	1950
			NE $\frac{1}{4}$ SW $\frac{1}{4}$	2.2 acres	1950
			NW $\frac{1}{4}$ SE $\frac{1}{4}$	2.4 acres	1950
			Total	45.0 acres	

15. If the ground water supply is supplemental to an existing water supply, identification of any application for a permit, permit, certificate or adjudicated right to appropriate water made or held by the registrant.

None

Township 37 S. Range 2 W. W.M.
North

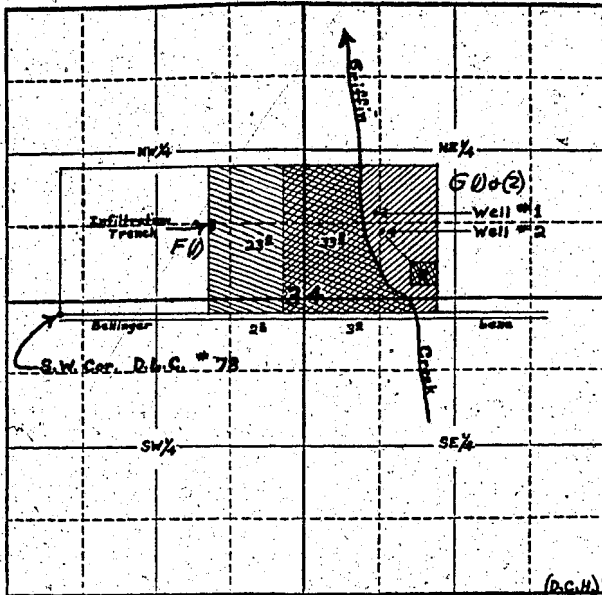

Locate well and acreage of irrigated land on plat.
Scale: 4" = 1 Mile

STATE OF OREGON

County of Jackson } ss.

I, Mrs. Kate S. Nelson, being first duly sworn, do hereby certify that I have read the foregoing Registration Statement and that all of the items therein contained are true to the best of my knowledge and belief.

X Kate S. Nelson
(Signature of Registrant)

Subscribed and sworn to before me this 29th day of April, 1957

My commission expires Nov. 23-1960
(Notary Public) Myrtle Neil

(SEAL)

CERTIFICATE OF REGISTRATION

STATE OF OREGON

County of Marion } ss.

This is to certify that the foregoing Registration Statement was received in the office of the State Engineer on the 30th day of April, 1957, at 8:00 o'clock A. M. and has been duly recorded in Book No. 3 of Registration Statements on page GR-446 K.

Witness my hand this 24th day of July, 1957.

Lewis A. Stanley
(State Engineer)

By _____ (Deputy)

GR - 446 K

#19.80