

RECEIVED
MAY 3 1946
STATE ENGINEER
SALVAGE SECTION

Otto Nelson Well No. 1

Registration Statement

REGISTRATION NO. GR-472
RR 454
CERTIFICATE NO. _____

OF CLAIMANT OF RIGHT TO APPROPRIATE GROUND WATER

(Under Chapter 708, Oregon Laws 1955.)

TO THE STATE ENGINEER OF OREGON:

I, Otto or Madge M. Nelson

of Route 1, Box 114, Sunnyside County of Marion

State of Oregon, do hereby make application for a certificate of registration as evidence of a right to appropriate ground water.

1. Source from which water is withdrawn is pump well #1
(Flowing well, pump well, infiltration trench, or tunnel)

2. Location is: 1/4 miles Southwest of Stayton, Oregon
(Approximate distance and direction from nearest city or town)

and is more particularly described as follows:

(a) North 84° 10' E 670 to the NE Cor. of Sec. 25 T. 9 S.R.2 W.W.M.
(Give distance and bearing to corner of section or other legal subdivision)

being within NE 1/4 of NE 1/4 of Sec. 25, Twp. 9 S, Rge. 2 W
(Smallest legal subdivision) (N. or S.) (E. or W.)

or (b) within limits of recorded platted property, town or city: _____

in Lot _____, Block _____ of _____
(Name of plat or addition)

(If within city or town, give name) _____
County of _____

3. Construction Work was begun on January 19, 1946; was completed on January 19, 1946
(Date) (Date)

and the ground water claimed was first used for the purposes set out below on 1946
(Date)

since which time the water has been used continuously
(Continuously or Intermittently)

from May 15 to October 1
(Date) (Date)

4. Quantity of water claimed and used is 225 gallons per minute; 40 acre feet per year.

5. Purpose or Purposes for which water is used irrigation
(Domestic, irrigation, municipal, manufacturing, industrial, etc.)

6. Description of Well: Depth 20 feet. Type drilled
(Dug or drilled)
diameter 8 inches. Elevation of ground at well site 365 feet, mean sea level.
(As near as known)
Depth to water table 10 feet.

7. Capacity of Well: 225 g.p.m. with 70 feet drawdown.
_____ g.p.m. with _____ feet drawdown.

Date of test anytime during heavy irrigation

If Flowing Well: Measured discharge _____ g.p.m. on _____
(Date)

Shut-in pressure at ground surface _____ lbs. per sq. in. on _____
(Date)

Water is controlled by _____
(Cap, valve, etc.)

8. **Casing:** (Give diameter, commercial specifications and depth below ground surface of each casing size.)

8 inch diameter from 00 to 20 feet

inch diameter from to feet

inch diameter from to feet

inch diameter from to feet

Describe and show depth of shoe, plug, adapter, liner or other details:

9. Perforated Casings or Screens:

6" slots x $\frac{1}{2}$ "

(Number per foot and size of perforations, or describe screen)

from 14 to 20

from to

from to

from to

10. **Log of Well:** (Describe each stratum or formation clearly, indicate if water bearing, and give thickness and depth as indicated.)

[illegible]

If log of well is not available, give name and address of driller.

11. Infiltration Trench: Covered or open

Dimensions: Length ft. Minimum depth ft. Maximum depth ft.

Bottom width ft. Discharge g.p.m. Date of test

12. Tunnel: Type of lining

Dimensions:

(Length, course, and cross sectional size)

Position of water bearing stratum with reference to portal of tunnel

Log of tunnel: (Preceding table for log of well may be used, if desired. Give footage from portal and character of materials, as pertinent.)

13. Pumping Equipment:

(a) Pump Centrifugal 4" suction 3" discharge Capacity _____ g.p.m.
(Make, type and size)

(Make, type and size)

(b) Motor 15 H. P. Electric Motor 3 phase

(Type and horsepower)

14. Location of area irrigated or to be irrigated, or place of use if for purposes other than irrigation.

[illegible]


15. If the ground water supply is supplemental to an existing water supply, identification of any application for a permit, permit, certificate or adjudicated right to appropriate water made or held by the registrant.

Part of this indicated area may be supplemental to areas pertinent to permit #18130.....

your file No. 22977.

GR - 454 B

North

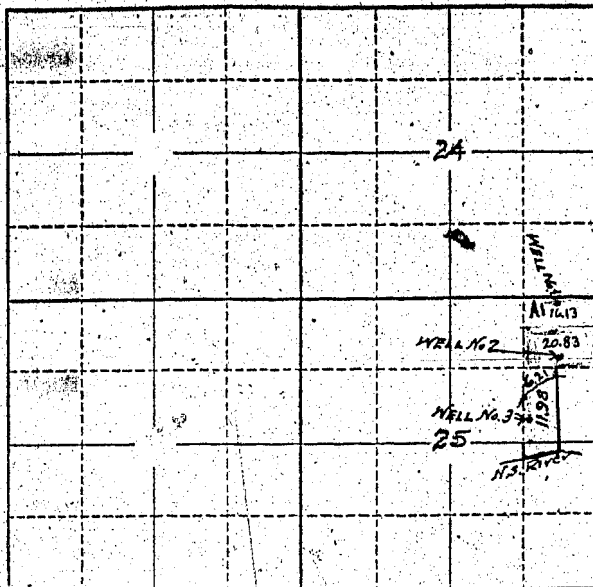

Scale: 2" = 1 Mile

County of _____

ss.

Otto Nelson
(Signature of Registrant)

My commission expires

(Notary Public)

(SEAL)

STATE OF OREGON

County of Marion

SS.

Construction shall be completed by ~~XXXXXX~~ and the water completely applied to beneficial use by ~~XXXXXX~~

Witness my hand this day of, 19.....

(State Engineer)

By

(Deputy)

GR - 454 C

RECEIVED
MAY 3 1957
STATE ENGINEER

Registration Statement

REGISTRATION NO. GR-472
CERTIFICATE NO. GR-454

OF CLAIMANT OF RIGHT TO APPROPRIATE GROUND WATER

(Under Chapter 708, Oregon Laws 1955.)

Otto Nelson Well #2

TO THE STATE ENGINEER OF OREGON:

I, Otto or Madge M. Nelson

of Route 1, Box 114, Sunnysville County of Marion

State of Oregon, do hereby make application for a certificate of registration as evidence of a right to appropriate ground water.

1. Source from which water is withdrawn is Pump Well #2
(Flowing well, pump well, infiltration trench, or tunnel)

2. Location is: 4 miles South west of Stayton, Oregon
(Approximate distance and direction from nearest city or town)

and is more particularly described as follows:

(a) North 27° 23' East of the NE. Cor. of Sec. 25, T. 9S, R. 2W, W. 4M
(Give distance and bearing to corner of section or other legal subdivision)

being within NE 1/4 of NE 1/4 of Sec. 25, Twp. 9S, Rge. 2W
(Smallest legal subdivision) (N. or S.) (E. or W.)

or (b) within limits of recorded platted property, town or city:

in Lot _____, Block _____ of _____
(Name of plat or addition)

(If within city or town, give name)

County of _____

3. Construction Work was begun on Mar. 10, 1941; was completed on Mar. 14, 1941
(Date) (Date)

and the ground water claimed was first used for the purposes set out below on 1941
(Date)

since which time the water has been used continuously
(Continuously or intermittently)

from May 15 to October 1
(Date) (Date)

4. Quantity of water claimed and used is 384 gallons per minute; 60 acre feet per year.

5. Purpose or Purposes for which water is used irrigation

(Domestic, irrigation, municipal, manufacturing, industrial, etc.)

6. Description of Well: Depth 26 feet. Type drilled
(Dug or drilled)
diameter 8 inches. Elevation of ground at well site 363 feet, mean sea level.
(As near as known)

Depth to water table 6 feet.

7. Capacity of Well: 540+ g.p.m. with very light feet drawdown.

_____ g.p.m. with _____ feet drawdown.

Date of test May 1943

If Flowing Well: Measured discharge _____ g.p.m. on _____
(Date)

Shut-in pressure at ground surface _____ lbs. per sq. in. on _____
(Date)

Water is controlled by _____
(Cap, valve, etc.)

GR - 454 D











If log of well is not available, give name and address of driller,

11. Infiltration Trench: Covered or open

Dimensions: Length ft. Minimum depth ft. Maximum depth ft.

Bottom width ft. Discharge g.p.m. Date of test

12. Tunnel: Type of lining

Dimensions: _____
(Length, course, and cross sectional size)

Position of water bearing stratum with reference to portal of tunnel

Log of tunnel: (Preceding table for log of well may be used, if desired. Give footage from portal and character of materials, as pertinent.)

13. Pumping Equipment:

(a) Pump Centrifugal 3 x 4 suction pipe 5" Capacity _____ g.p.m.
(Make, type and size)

(b) Motor 15 H. P. Motor 3 phase Electric
(Type and horsepower)

14. Location of area irrigated or to be irrigated, or place of use if for purposes other than irrigation.

[illegible]


15. If the ground water supply is supplemental to an existing water supply, identification of any application for a permit, permit, certificate or adjudicated right to appropriate water made or held by the registrant.

Part or all of this may be supplemental to areas pertinent to Permit 18130 (your

file No. 22977.)

6R - 454 F

Township 25 Range 2 W W.M.
North

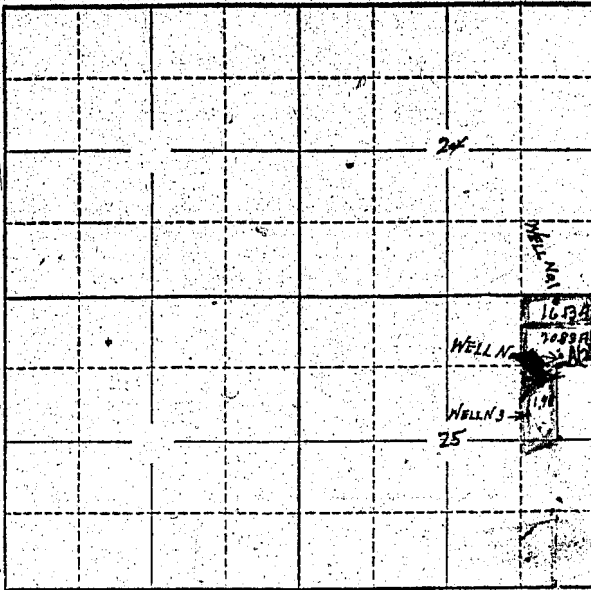

Locate well and acreage of irrigated land on plat.
Scale: 2" = 1 Mile

STATE OF OREGON

County of Marion } ss.

I, Otto Nelson, being first duly sworn, do hereby certify that I have read the foregoing Registration Statement and that all of the items therein contained are true to the best of my knowledge and belief.

Otto Nelson
(Signature of Registrant)

Subscribed and sworn to before me this 1st day of May, 1957

My commission expires 8/21/58 Walter H. Beale
(Notary Public)

(SEAL)

See Page GR-454 K for
CERTIFICATE OF REGISTRATION

STATE OF OREGON

County of Marion } ss.

~~This is to certify that the foregoing Registration Statement was received in the office of the State Engineer on the X-X-X-X day of X-X-X-X, 19-X-X, at X-X-X-X o'clock X-X-XM and has been X-X-X-X recorded in said office in Book No. X-X-X-X of Registration Statements on page X-X-X-X-X.~~

~~Construction shall be completed by X-X-X-X-X-X-X-X, 19-X-X, and the water completely applied to beneficial use by X-X-X-X-X-X-X-X, 19-X-X.~~

Witness my hand this _____ day of _____, 19____

(State Engineer)

By _____
(Deputy)

Registration Statement

OF CLAIMANT OF RIGHT TO APPROPRIATE GROUND WATER

(Under Chapter 703, Oregon Laws 1955.)

Otto Nelson Well # 3

TO THE STATE ENGINEER OF OREGON:

I, Otto Nelson or Madge M. Nelson

of Route 1, Box 114, Aumsville County of Marion

State of Oregon do hereby make application for a certificate of registration as evidence of a right to appropriate ground water.

1. Source from which water is withdrawn is Pump well #3
(Flowing well, pump well, infiltration trench, or tunnel)

2. Location is: 4 miles SW of Stayton, Oregon
(Approximate distance and direction from nearest city or town)

and is more particularly described as follows:

(a) South 15° 53' West 421 feet to the SW Cor. of SE $\frac{1}{4}$ of NE $\frac{1}{4}$ of Sec. 25 T 9 S
(Give distance and bearing to corner of section or other legal subdivision)

being within SE $\frac{1}{4}$ of NE $\frac{1}{4}$ of Sec. 25, Twp. 9 S, Rge. 2 W
(Smallest legal subdivision) (N. or S.) (E. or W.)

or (b) within limits of recorded platted property, town or city: _____

in Lot _____, Block _____ of _____
(Name of plat or addition)

(If within city or town, give name)

County of _____

3. Construction Work was begun on April 1, 1955; was completed on April
(Date) (Date)

and the ground water claimed was first used for the purposes set out below on 1955
(Date)

since which time the water has been used continuously
(Continuously or Intermittently)

from May 15 to October 15
(Date) (Date)

4. Quantity of water claimed and used is 384 gallons per minute; 35 acre feet per year.

5. Purpose or Purposes for which water is used irrigation

(Domestic, irrigation, municipal, manufacturing, industrial, etc.)

6. Description of Well: Depth 26 feet. Type drilled
(Dug or drilled)

diameter 8 inches. Elevation of ground at well site 335 feet, mean sea level.
(As near as known)

Depth to water table 60 feet.

7. Capacity of Well: 384 g.p.m. with 3 feet drawdown.

0 g.p.m. with _____ feet drawdown.

Date of test any time we irrigate

If Flowing Well: Measured discharge _____ g.p.m. on _____
(Date)

Shut-in pressure at ground surface _____ lbs. per sq. in. on _____
(Date)

Water is controlled by _____
(Cap, valve, etc.)

8. **Casing:** (Give diameter, commercial specifications and depth below ground surface of each casing size.)

8 inch diameter from 00 to 26 feet

inch diameter from to feet

inch diameter from to feet

inch diameter from to feet

Describe and show depth of shoe, plug, adapter, liner or other details: _____

9. Perforated Casings or Screens:

1/2" x 6" slots from 20 to 26
(Number per foot and size of perforations, or describe screen)

(Number per foot and size of perforations, or describe screen)

from to

from to

from to

10. Log of Well: (Describe each stratum or formation clearly, indicate if water bearing, and give thickness and depth as indicated.)

[illegible]

If log of well is not available, give name and address of driller.

11. Infiltration Trench: Covered or open

Dimensions: Length ft. Minimum depth ft. Maximum depth ft.

Bottom width ft. Discharge g.p.m. Date of test

12. Tunnel: Type of lining

Dimensions: _____
(Length, course, and cross sectional size)

Position of water bearing stratum with reference to portal of tunnel

Log of tunnel: (Preceding table for log of well may be used, if desired. Give footage from portal and character of materials, as pertinent.)

13. Pumping Equipment:

(a) Pump 3 x 4 Centrifugal Capacity _____ g.p.m.
(Make, type and size)

(b) Motor 10 H. P. Electric 3 phase
(Type and horsepower)

14. Location of area irrigated or to be irrigated, or place of use if for purposes other than irrigation.


[illegible]

15. If the ground water supply is supplemental to an existing water supply, identification of any application for a permit, permit, certificate or adjudicated right to appropriate water made or held by the registrant.

Part of this may be supplemental to area pertinent to permit No. 18130 (Your file No.

22977.)

North

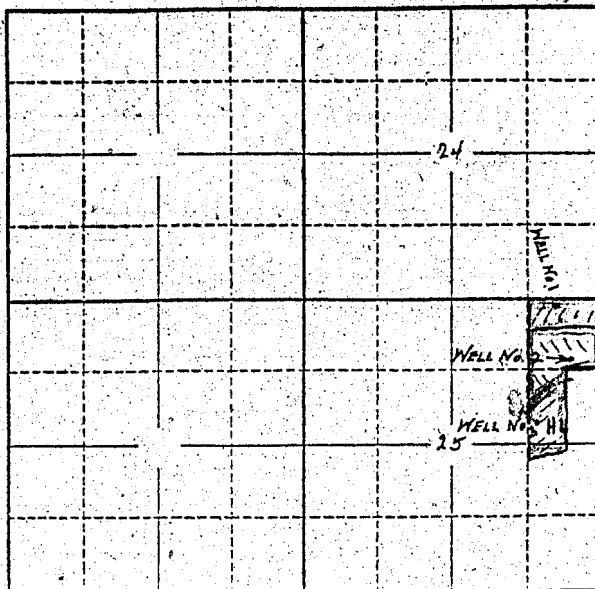

Scale: 2" = 1 Mile

County of _____

SS

Chas Nelson
(Signature of Registrant)

My commission expires

(Notary Public)

(SEAL)

STATE OF OREGON

SS.

~~Construction shall be completed by X-X-X-X-X-X-X-X-10-X-X and the water completely applied to X
hereafter per by X-X-X-X-X-X-X-X-10-X-X //~~

Witness my hand this 26th day of June 1957.

(State Engineer)

By

(Deputy)

$$T_2 = 454 \text{ K}$$