RECEIVED
MAY 3 1957
STATE ENGINEER
SALEM, OREGON

REGISTRATION NO. G-2473
CERTIFICATE NO. GR 455

Registration Statement

OF CLAIMANT OF RIGHT TO APPROPRIATE GROUND WATER

(Under Chapter 708, Oregon Laws 1955.)

TO THE STATE ENGINEER OF OREGON:

I, Laurence and Frances Killinger, husband and wife,

of Route 1, Box 116, Aumsville County of Marion

State of Oregon, do hereby make application for a certificate of registration as evidence of a right to appropriate ground water.

1. **Source** from which water is withdrawn is Pump well
(Flowing well, pump well, infiltration trench, or tunnel)

2. **Location** is: 4 miles South west of Stayton;
(Approximate distance and direction from nearest city or town)

and is more particularly described as follows:

(a) S. 65° 54' E. 37.30 chains from the N. W. cor. of Sec. 30 T. 9 S. R. 1 W. W. M.
(Give distance and bearing to corner of section or other legal subdivision)

being within NE¼ of NW¼ of Sec. 30, Twp. 9 S, Rge. 2 W.
(Smallest legal subdivision) (N. or S.) (E. or W.)

or (b) within limits of recorded platted property, town or city:

in Lot ....., Block ..... of .....
(Name of plat or addition)

..... County of .....
(If within city or town, give name)

3. **Construction Work** was begun on January, 1949 (Date); was completed on January, 1949 (Date)

and the ground water claimed was first used for the purposes set out below on 1949 (Date),

since which time the water has been used continously (Continuously or intermittently)

from May 15 (Date) to October 1 (Date)

4. **Quantity** of water claimed and used is 375 gallons per minute; 66 acre feet per year.

5. **Purpose or Purposes** for which water is used irrigation
(Domestic, irrigation, municipal, manufacturing, industrial, etc.)

6. **Description of Well:** Depth 21 feet. Type Centrifugal (Dug or drilled)

diameter 8 inches. Elevation of ground at well site 320 (As near as known) feet, mean sea level.

Depth to water table ..... feet.

7. **Capacity of Well:** 375 g.p.m. with 3 feet drawdown.

..... g.p.m. with ..... feet drawdown.

Date of test any time

If Flowing Well: Measured discharge ..... g.p.m. on ..... (Date)

Shut-in pressure at ground surface ..... lbs. per sq. in. on ..... (Date)

Water is controlled by ..... (Cap, valve, etc.)

8. **Casing:** (Give diameter, commercial specifications and depth below ground surface of each casing size.)

8 inch diameter from 6 to 20 feet

inch diameter from to feet

inch diameter from to feet

inch diameter from to feet

Describe and show depth of shoe, plug, adapter, liner or other details:

9. **Perforated Casings or Screens:**

(Number per foot and size of perforations, or describe screen) from to

from to

from to

from to

10. **Log of Well:** (Describe each stratum or formation clearly, indicate if water bearing, and give thickness and depth as indicated.)

MATERIAL	Thickness (Feet)	Depth to Bottom (Feet)
River gravel	21	21

If log of well is not available, give name and address of driller: .....

.....

11. **Infiltration Trench:** Covered or open .....

Dimensions: Length ..... ft. Minimum depth ..... ft. Maximum depth ..... ft.

Bottom width ..... ft. Discharge ..... g.p.m. Date of test .....

12. **Tunnel:** Type of lining .....

Dimensions: .....
(Length, course, and cross sectional size)

Position of water bearing stratum with reference to portal of tunnel .....

.....

Log of tunnel: (Preceding table for log of well may be used, if desired. Give footage from portal and character of materials, as pertinent.)

13. **Pumping Equipment:**

(a) Pump Cornell Centrifugal (Make, type and size) Capacity 400 g.p.m.

(b) Motor 15 H. P. Electric 3 phase (Type and horsepower)

14. Location of area irrigated or to be irrigated, or place of use if for purposes other than irrigation.

Township North or South	Range E. or W. of Willamette Meridian	Section	Forty-acre Tract	Number Acres To Be Irrigated	Date of Reclamation
9 S	1 W	30	NW¼ of NE¼	14.12	1949
9 S	1 W	30	NE¼ of NW¼	18.00	1949
				32.12	

15. If the ground water supply is supplemental to an existing water supply, identification of any application for a permit, permit, certificate or adjudicated right to appropriate water made or held by the registrant.

.....

.....

Township 9S Range 2W, W.M.

North

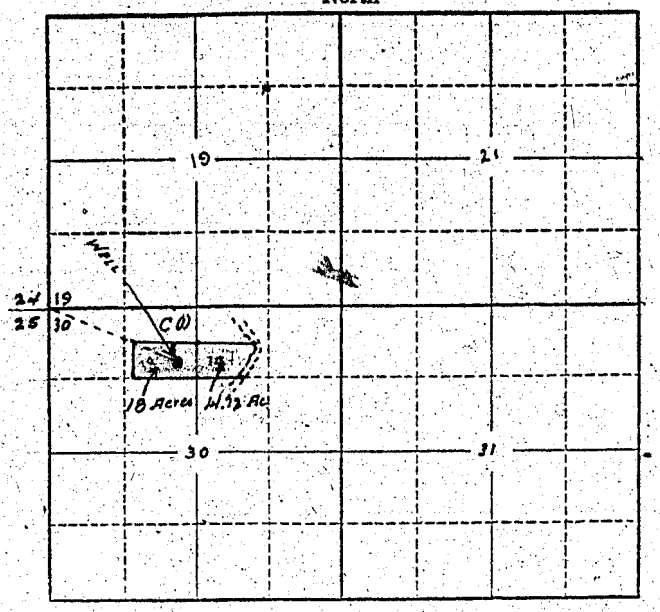

Locate well and acreage of irrigated land on plat.

Scale: 2" = 1 Mile

STATE OF OREGON
County of Marion } ss.

I, Lawrence Killinger, being first duly sworn, do hereby certify that I have read the foregoing Registration Statement and that all of the items therein contained are true to the best of my knowledge and belief.

Lawrence M Killinger
(Signature of Registrant)

Subscribed and sworn to before me this 1st day of May, 1957.

My commission expires 1/21/59

Opal H Beec
(Notary Public)

(SEAL)

CERTIFICATE OF REGISTRATION

STATE OF OREGON
County of Marion } ss.

This is to certify that the foregoing Registration Statement was received in the office of the State Engineer on the 3rd day of May, 19 57, at 8:00 o'clock A. M. and has been duly recorded in said office in Book No. 3 of Registration Statements on page GR-455 C.

~~Construction shall be completed by x-x-x-x-x-x-x-x-x-x, 19x-x, and the water completely applied to beneficial use by x-x-x-x-x-x-x-x-x-x, 19x-x-x~~

Witness my hand this 26th day of June, 19 57

Lewis A. Stanley
(State Engineer)

By
(Deputy)

GR - 455 C