

RECEIVED
MAY 6 1957
STATE ENGINEER
SALEM, OREGON

REGISTRATION NO. C.R. 475
CERTIFICATE NO. 457

Registration Statement

OF CLAIMANT OF RIGHT TO APPROPRIATE GROUND WATER

(Under Chapter 708, Oregon Laws 1955.)

TO THE STATE ENGINEER OF OREGON:

I, Charles W. and Patricia Chambers

of Rt. 2, Box 329, Albany County of Linn

State of Oregon do hereby make application for a certificate of registration as evidence of a right to appropriate ground water.

1. Source from which water is withdrawn is Pump Well No. 1

(Flowing well, pump well, infiltration trench, or tunnel)

2. Location is: 12 miles north of Albany, Oregon

(Approximate distance and direction from nearest city or town)

and is more particularly described as follows:

(a) S. 44° 20' E. 25.7 chains from NW corner of NE¹/₄, S. 11, T. 10 S., R. 4 W.
(Give distance and bearing to corner of section or other legal subdivision)

being within NW¹/₄ of NE¹/₄ of Sec. 11 Twp. 10 S., Rge. 4 W.
(Smallest legal subdivision)

or (b) within limits of recorded platted property, town or city:

in Lot _____, Block _____ of _____
(Name of plat or addition)

County of Linn

(If within city or town, give name)

3. Construction Work was begun on April 4, 1951; was completed on April 5, 1951
(Date) (Date)

and the ground water claimed was first used for the purposes set out below on May 17, 1951
(Date)

since which time the water has been used continuously

(Continuously or intermittently)

from May 17, 1951 to present time
(Date) (Date)

4. Quantity of water claimed and used is 500 gallons per minute; 88.75 acre feet per year.

5. Purpose or Purposes for which water is used Irrigation

(Domestic, irrigation, municipal, manufacturing, industrial, etc.)

6. Description of Well: Depth 34 feet. Type Drilled

(Dug or drilled)

diameter 8 inches. Elevation of ground at well site 175 feet, mean sea level.
(As near as known)

Depth to water table 13 feet.

7. Capacity of Well: 700 g.p.m. with 2½ feet drawdown.

g.p.m. with feet drawdown.

Date of test Estimated

If Flowing Well: Measured discharge g.p.m. on

(Date)

Shut-in pressure at ground surface lbs. per sq. in. on


(Date)

Water is controlled by (Cap, valve, etc.)

8. Casing: (Give diameter, commercial specifications and depth below ground surface of each casing size.)

8 inch diameter Steel casing from 0 to 34 feet
inch diameter from to feet
inch diameter from to feet
inch diameter from to feet

Describe and show depth of shoe, plug, adapter, liner or other details:

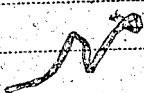

9. Perforated Casings or Screens:

Slot perforations

(Number per foot and size of perforations, or describe screen)

from 24 to 34

from to

from to

from to

10. Log of Well: (Describe each stratum or formation clearly, indicate if water bearing, and give thickness and depth as indicated.)

MATERIAL	Thickness (Feet)	Depth to Bottom (Feet)
Not available		

218-264. W.W. #1

Beginning at an iron bar on the right bank of the Willamette River, which is North 21.48 chains and 13.10 chains West from the Southwest corner of the D.L.C. of John McCoy, No. 160, and Claim 38, T. 10 S., R. 4 W. of the Will. Mer. in Linn County, Oregon, and running thence East 6.27 chains to an iron bar; thence North 12.52 chains; thence East 1.72 chains; thence North 3.68 chains; thence East 13.78 chains to an iron plow share, which is on the West line of the Southeast quarter of the Northeast quarter of Section 11, in said T. and R.; thence North 36.76 chains to an iron rod 1"x 4", which is at the Northwest corner of the Northeast quarter of the Northeast quarter of said Section 11; thence West along the north line of said Section 18.10 chains to an iron pipe 3/4" x 24", thence South 49.75 chains to an iron pipe 3/4" x 36"; thence West 4.44 chains to an iron pipe 2" x 36"; thence S.66 3/4 W. 1.06 chains to the right bank of the Will. River; thence Southerly up the right bank of said River to the beginning, containing 72.33 acres, more or less, saving and excepting the refrom a right of way for the joint use of Emma J. Jones and John Wills, their heirs and assigns for road purposes, 30 feet road, being 15 feet in width on each side of the following described line; beginning 15 feet E. of the Southwest corner of the above described tract of land, thence N.9 3/4 W. 2.25 chains to an iron rod; thence N.22 1/2 S. 0.95 chains to an iron pipe. Also a right of way for the joint use of Emma J. Jones and John Wills, their heirs and assigns, for road purposes and described as follows: A. a rip of land 48 feet wide along the right bank of the Will. River beginning at the Southwest corner of the above described tract of land and extending up said River in a Southerly direction to the Southwest corner of the D.L.C. of John McCoy, all lying and being in Linn County, Oregon.

11. Infiltration Trench: Covered or open

Dimensions: Length ft. Minimum depth ft. Maximum depth ft.

Bottom width ft. Discharge g.p.m. Date of test

12. Tunnel: Type of lining

Dimensions:
(Length, course, and cross sectional size)

Position of water bearing stratum with reference to portal of tunnel

Log of tunnel: (Preceding table for log of well may be used, if desired. Give footage from portal and character of materials, as pertinent.)

13. Pumping Equipment:

(a) Pump Pacific 4" centrifugal Capacity 500 g.p.m.
(Make, type and size)

(b) Motor 20 H.P. electric
(Type and horsepower)

14. Location of area irrigated or to be irrigated, or place of use if for purposes other than irrigation.

Township North or South	Range E. or W. of Willamette Meridian	Section	Forty-acre Tract	Number Acres To Be Irrigated	Date of Reclamation
10 S	4 W.	11	NW ¹ / ₄ of NE ¹ / ₄	20.0	May 17, 1951
10 S	4 W.	11	SW ¹ / ₄ of NE ¹ / ₄	15.5	" "
				35.5	

Ex. 241-31

Beginning at an iron bar on the right bank of the Will. River, which is North 21.48 chains and 13.10 chains West from the Southwest corner of the D.L.C. of John McCoy, Not No. 1680 and Claim 38, T. 10 S., R. 4 W. of the Will. Mer. in Linn County, Oregon, and running thence East 3.27 chains to an iron bar; thence North 16.20 chains to an iron plow share; thence East 5.032 chains; thence North 36.650 to a point on the North line of section 11 and East 7.452 chains from the Northwest corner of the Northeast quarter of said section; thence West along the North line of said section a distance of 5.682 chains to a 3/4" iron pipe; thence South 49.75 chains to an iron pipe 3/4" x 36"; thence West 4.44 chains to an iron pipe 2" x 36"; thence S.00 3/4 E. 1.06 chains to the right bank of the Will. River; thence Southerly up the right bank of said river to the beginning; containing 35.5 acres, more or less, all being located in the County of Linn, State of Oregon.

1. Right of way, including the terms and provisions thereof, for road purposes 30 feet wide for joint use of grantors and grantees, their heirs and assigns, being set forth in that certain deed from Emma J. Jones et vir to John Wills recorded 6-24-21 in Linn County, Oregon, Deed Records, Vol. 123, page 263, and also being set forth in Deed to Aimai F. Wills recorded Vol. 139, page 577;

2. Right of way, including the terms and provisions thereof, for road or gateway, 16¹/₂ feet in width, as set forth in Vol. 16, page 579, Linn County Court Journal and being recorded in Vol. 7 in road records of Linn County, Oregon at page 55 thereof;


3. Right of the public in and to any portion of the herein described property, lying within public roads and highways and;

4. Rights of governmental bodies in and to that portion of the herein described property, lying below the high-water mark of the Will. River.

15. If the ground water supply is supplemental to an existing water supply, identification of any application for a permit, permit, certificate or adjudicated right to appropriate water made or held by the registrant.

Township 10 S. Range 4 W., W.M.

North

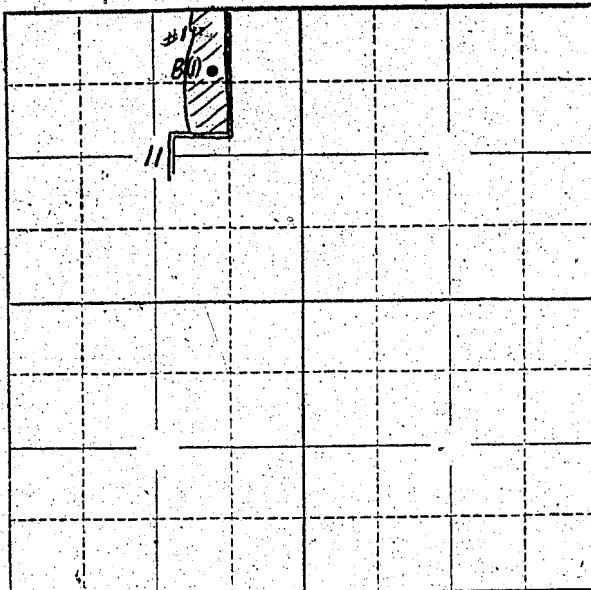

Locate well and acreage of irrigated land on plat.

Scale: 2" = 1 Mile

STATE OF OREGON

County of Linn

{ ss.

I, Charles W. and Patricia Chambers, being first duly sworn, do hereby certify that I have read the foregoing Registration Statement and that all of the items therein contained are true to the best of my knowledge and belief.

Charles W. Chambers, Patricia Chambers
(Signature of Registrant)

Subscribed and sworn to before me this 25th day of April

My commission expires May 11, 1960

Edmund D. Markins
(Notary Public) TOF Oregon

(SEAL)

See Page GR-457 G for
CERTIFICATE OF REGISTRATION

STATE OF OREGON

{ ss.

County of Marion

This is to certify that the foregoing Registration Statement was received in the office of the State Engineer on the day of April 19, 1957 at 12 o'clock noon and has been duly recorded in the office in Book No. 5 Registration Statements on page 19. Construction shall be completed by April 19, 1958 and the water completely applied to beneficial use by April 19, 1958.

Witness my hand this day of April, 1957.

(State Engineer)

By

(Deputy)

GR - 457 C

RECEIVED
MAY 6 1957
STATE ENGINEER
SALEM, OREGON

Registration Statement

REGISTRATION NO. G.R. 425
CERTIFICATE NO. G.R. 457

OF CLAIMANT OF RIGHT TO APPROPRIATE GROUND WATER

(Under Chapter 708, Oregon Laws 1955.)

TO THE STATE ENGINEER OF OREGON:

I, Charles W. and Patricia Chambers,
of R.R. 2, Box 329, Albany, County of Linn,

State of Oregon, do hereby make application for a certificate of registration as evidence of a right to appropriate ground water.

1. Source from which water is withdrawn is Pump Well No. 2
(Flowing well, pump well, infiltration trench, or tunnel)

2. Location is: 12 miles North of Albany, Oregon
(Approximate distance and direction from nearest city or town)

and is more particularly described as follows:

(a) S. 68° E. 25.2 chains from the NW corner Elias A. Johnson DLC 74
(Give distance and bearing to corner of section or other legal subdivision)

being within NE $\frac{1}{4}$ of NE $\frac{1}{4}$ of Sec. 14, Twp. 10 S., Rge. 4 W.
(smallest legal subdivision) (N. or S.) (E. or W.)

or (b) within limits of recorded platted property, town or city:

in Lot _____, Block _____ of _____
(Name of plat or addition)

County of Linn
(If within city or town, give name)

3. Construction Work was begun on April 10, 1943
(Date) was completed on April 11, 1943
(Date)

and the ground water claimed was first used for the purposes set out below on May 10, 1951
(Date)

since which time the water has been used continuously
(Continuously or Intermittently)

from May 10, 1951 to present time
(Date) (Date)

4. Quantity of water claimed and used is 500 gallons per minute; 131.5 acre feet per year.

5. Purpose or Purposes for which water is used Irrigation

(Domestic, irrigation, municipal, manufacturing, industrial, etc.)

6. Description of Well: Depth 29 feet. Type Drilled
(Dug or drilled)

diameter 8 inches. Elevation of ground at well site 175 feet, mean sea level.
(As near as known)

Depth to water table 8 feet.

7. Capacity of Well: 700 g.p.m. with 2 $\frac{1}{2}$ feet drawdown.

g.p.m. with feet drawdown.

Date of test Estimated

If Flowing Well: Measured discharge g.p.m. on
(Date)

Shut-in pressure at ground surface lbs. per sq. in. on
(Date)

Water is controlled by
(Cap, valve, etc.)

G.R. - 457 D

8. Casing: (Give diameter, commercial specifications and depth below ground surface of each casing size.)

8 inch diameter steel casing from 0 to 29 feet
 inch diameter from to feet
 inch diameter from to feet
 inch diameter from to feet

Describe and show depth of shoe, plug, adapter, liner or other details: _____

9. Perforated Casings or Screens:

Slot perforations from 19 to 29

(Number per foot and size of perforations, or describe screen.)

from 19 to 29

from to ..

from to ..

from to

10. Log of Well: (Describe each stratum or formation clearly, indicate if water bearing, and give thickness and depth as indicated.)

GR - 457 E

If log of well is not available, give name and address of driller.

11. Infiltration Trench: Covered or open

Dimensions: Length ft. Minimum depth ft. Maximum depth ft.

Bottom width ft. Discharge g.p.m. Date of test

12. Tunnel: Type of lining

Dimensions:
(Length, course, and cross sectional size)

Position of water bearing stratum with reference to portal of tunnel

Log of tunnel: (Preceding table for log of well may be used, if desired. Give footage from portal and character of materials, as pertinent.)

13. Pumping Equipment:

(a) Pump Pacific 4" centrifugal Capacity 500 g.p.m.

(b) Motor 20 H. P. electric
(Type and horsepower)

14. Location of area irrigated or to be irrigated, or place of use if for purposes other than irrigation.

Township North or South	Range E. or W. of Willamette Meridian	Section	Forty-acre Tract	Number Acres To Be Irrigated	Date of Reclamation
10 S	4 W.	11	SW $\frac{1}{4}$ of SE $\frac{1}{4}$	1.3	May 10, 1951
10 S	4 W.	11	SE $\frac{1}{4}$ of SE $\frac{1}{4}$	11.0	"
10 S	4 W.	12	SW $\frac{1}{4}$ of SW $\frac{1}{4}$	3.5	"
10 S	4 W.	13	NW $\frac{1}{4}$ of NW $\frac{1}{4}$	11.3	"
10 S	4 W.	14	NW $\frac{1}{4}$ of NE $\frac{1}{4}$	1.0	"
				52.6	


187-89 1111 #2

Beginning at the Northwest corner of the D.L.C. of the heirs of Elias A. Johnson, deceased, Not. No. 1717, Claim No. 74, T. 10 S., R. 4 W. of the Will. Mer. in Linn County, Oregon, thence N. 9° E. along the North line of said D.L.C. 37.07 chains, thence South 4 chains to a 3/4" x 24" iron bolt; thence S. 59° W. 97 links to an iron pipe 1 $\frac{1}{2}$ " x 24"; thence South 17.11 chains to an iron bar 4" x 1 $\frac{1}{2}$ " x 30" which is North 10.51 chains distant from the South line of said D.L.C.; thence West 22.10 chains, more or less, to the Willamette River; thence down said Will. River with the meanderings thereof to the place of beginning, containing 59.65 acres, more or less, all situated in Linn County, State of Oregon.

15. If the ground water supply is supplemental to an existing water supply, identification of any application for a permit, permit, certificate or adjudicated right to appropriate water made or held by the registrant.

Township 10 S Range 4 E., W.M.

North

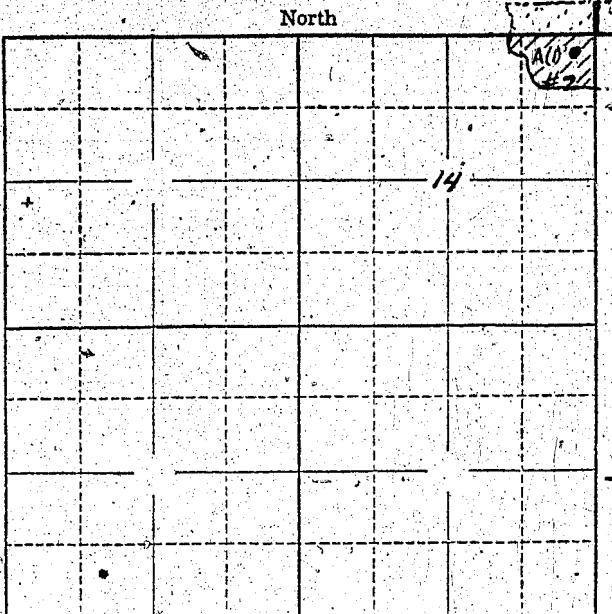

Locate well and acreage of irrigated land on plat.

Scale: 2" -- 1 Mile

STATE OF OREGON

County of LINN.

CHARLES W. CHAMBERS

I, PATRICIA CHAMBERS, being first duly sworn, do hereby certify that I have read the foregoing Registration Statement and that all of the items therein contained are true to the best of my knowledge and belief.

~~(Signature of Postmaster)~~

Subscribed and sworn to before me this 25th day of April,

My commission expires May 11, 1960.

D. M. Jones

(SEAL)

CERTIFICATE OF REGISTRATION

STATE OF OREGON

1

County of Marion

This is to certify that the foregoing Registration Statement was received in the office of the State
Engineer on the 6th day of May, 1957 at 8:00 o'clock A.M. and has been
duly recorded in said office in Book No. 3 of Registration Statements on page GR-157 G.


Witness my hand this 26th day of June.

, 1957
John

(State Engineer)

73.85

CS-4526