

Registration Statement

OF CLAIMANT OF RIGHT TO APPROPRIATE GROUND WATER

TO THE STATE ENGINEER OF OREGON:

I, Albert and Ilene Gurgurich

of Route 1, Box 187, Jefferson, Oregon County of Marion

(Mailing address)

State of Oregon, do hereby make application for a certificate of registration as evidence of a right to appropriate ground water.

1. Source from which water is withdrawn is pump well
(Flowing well, pump well, infiltration trench, or tunnel)

2. Location is: one mile N. W. of Jefferson
(Approximate distance and direction from nearest city or town)

and is more particularly described as follows:

(a) 448' East & 2563' North to the N. E. cor. Sec. 3, T. 10 S., R. 3 W.
(Give distance and bearing to corner of section or other legal subdivision)

being within S. E. 1/4 N. E. 1/4 of Sec. 108 Twp. 10S Rge. 3 W.
(Smallest legal subdivision) (N. or S.) (E. or W.)

or (b) within limits of recorded platted property, town or city:

in Lot _____, Block _____ of _____
(Name of plat or addition)

County of Marion
(If within city or town, give name)

3. Construction Work was begun on July 14, 1945; was completed on July 16, 1945
(Date) (Date)

and the ground water claimed was first used for the purposes set out below on July 18, 1945
(Date)

since which time the water has been used continuously
(Continuously or intermittently)

from July 18, 1945 to Oct. 1956
(Date) (Date)

4. Quantity of water claimed and used is 399.6 gallons per minute; 141.92 acre feet per year.

5. Purpose or Purposes for which water is used irrigation of farm crops

(Domestic, irrigation, municipal, manufacturing, industrial, etc.)

6. Description of Well: Depth 32 feet. Type drilled
(Dug or drilled)

diameter 10 inches. Elevation of ground at well site 275 feet, mean sea level.
(As near as known)

Depth to water table 13 feet.

7. Capacity of Well: 500 g.p.m. with none feet drawdown.

_____ g.p.m. with _____ feet drawdown.

Date of test _____

If Flowing Well: Measured discharge _____ g.p.m. on _____
(Date)

Shut-in pressure at ground surface _____ lbs. per sq. in. on _____
(Date)

Water is controlled by _____
(Cap, valve, etc.)

8. Casing: (Give diameter, commercial specifications and depth below ground surface of each casing size.)

10 inch diameter steel casing from 0 to 32 feet
inch diameter from to feet
inch diameter from to feet
inch diameter from to feet

Describe and show depth of shoe, plug, adapter, liner or other details:

9. Perforated Casings or Screens:

1/2" x 3' 10 per ft. from 20 to 32
(Number per foot and size of perforations, or describe screen).
from to
from to
from to

10. Log of Well: (Describe each stratum or formation clearly, indicate if water bearing, and give thickness and depth as indicated.)

MATERIAL	Thickness (Feet)	Depth to Bottom (Feet)
Sandy loam	15	15
Gravel (water bearing)	17	0

If log of well is not available, give name and address of driller.

11. Infiltration Trench: Covered or open

Dimensions: Length ft. Minimum depth ft. Maximum depth ft.

Bottom width ft. Discharge g.p.m. Date of test

12. Tunnel: Type of lining

Dimensions:
(Length, course, and cross sectional size)

Position of water bearing stratum with reference to portal of tunnel

Log of tunnel: (Preceding table for log of well may be used, if desired. Give footage from portal and character of materials, as pertinent.)

13. Pumping Equipment:

(a) Pump Pacific centrifugal 3" x 4" Capacity 500 g.p.m.
(Make, type and size)

(b) Motor electric 20 H. P.
(Type and horsepower)


14. Location of area irrigated or to be irrigated, or place of use if for purposes other than irrigation.

Township North or South	Range E. or W. of Willamette Meridian	Section	Forty-acre Tract	Number Acres To Be Irrigated	Date of Reclamation
10. S.	3 W.	3	S. W. $\frac{1}{4}$ N. E. $\frac{1}{4}$	3.8	July 18, 1945
10 S.	3 W.	3	S. E. $\frac{1}{4}$ N. E. $\frac{1}{4}$	25.7	" "
10 S.	3 W.	3	N. E. $\frac{1}{4}$ S. E. $\frac{1}{4}$	22.1	" "
10 S.	3 W.	2	S. W. $\frac{1}{4}$ N. W. $\frac{1}{4}$	0.7	" "
10 S.	3 W.	2	N. W. $\frac{1}{4}$ S. W. $\frac{1}{4}$	0.6	" "
				<u>52.9</u>	

15. If the ground water supply is supplemental to an existing water supply, identification of any application for a permit, permit, certificate or adjudicated right to appropriate water made or held by the registrant.

Township T10S Range R3W W.M.

North

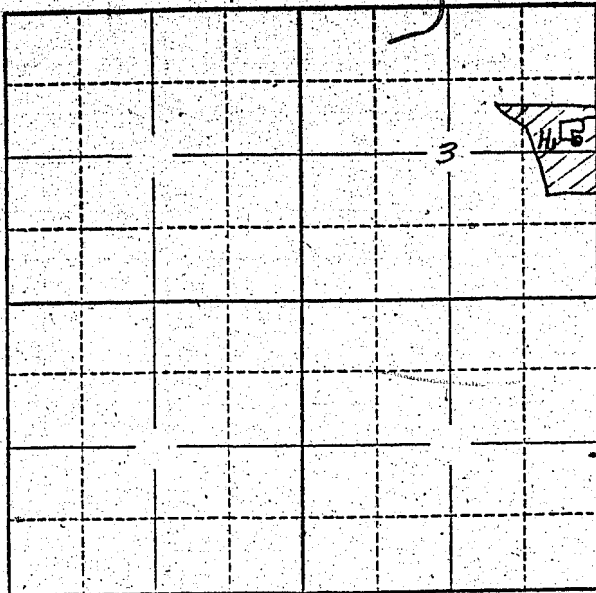

Locate well and acreage of irrigated land on plat.

Scale: 2" = 1 Mile

STATE OF OREGON

County of _____ } ss.

I, Albert Gurgurich, being first duly sworn, do hereby certify that I have read the foregoing Registration Statement and that all of the items therein contained are true to the best of my knowledge and belief.

Albert Gurgurich
(Signature of Registrant)

Subscribed and sworn to before me this 8th day of May, 1957.

My commission expires Sept. 2, 1960
Albert [Signature]
(Notary Public)

(SEAL)

CERTIFICATE OF REGISTRATION

STATE OF OREGON

County of Marion } ss.

This is to certify that the foregoing Registration Statement was received in the office of the State Engineer on the 8th day of May, 1957, at 10:00 o'clock A. M. and has been duly recorded in said office in Book No. 3 of Registration Statements on page GR-465 C.

Witness my hand this 26th day of June, 1957.

Lewis A. Stanley
(State Engineer)

By _____
(Deputy)

\$18.45

GR - 465 C