RECEIVED
MAY 14 1957
STATE ENGINEER

REGISTRATION NO. G-488
CERTIFICATE NO. 515

Registration Statement

OF CLAIMANT OF RIGHT TO APPROPRIATE GROUND WATER

(Under Chapter 708, Oregon Laws 1955.)

TO THE STATE ENGINEER OF OREGON:

I, We, George S. Fick & Mary Ellen Fick,

of Portland County of Multnomah

State of Oregon, do hereby make application for a certificate of registration as evidence of a right to appropriate ground water.

1. **Source** from which water is withdrawn is Pump well. (Flowing well, pump well, infiltration trench, or tunnel)

2. **Location** is: 2 1/2 miles East of St Paul Oregon. (Approximate distance and direction from nearest city or town)

and is more particularly described as follows:

(a) North West 1/4 of Section 22 (Give distance and bearing to corner of section or other legal subdivision)

being within (Smallest legal subdivision) of Sec. 22, Twp. S (N. or S.) 4, Rge. 2W (E. or W.)

or (b) within limits of recorded platted property, town or city:

in Lot ....., Block ..... of ..... (Name of plat or addition)

..... (If within city or town, give name) County of Marion

3. **Construction Work** was begun on July 1948 (Date); was completed on Sept. 1948 (Date)

and the ground water claimed was first used for the purposes set out below on Oct. 1, 1948 (Date),

since which time the water has been used Spring or Summer Continuously (Continuously or intermittently)

from April 1 (Date) to Oct 1 (Date)

4. **Quantity** of water claimed and used is 300 gallons per minute; ..... acre feet per year.

5. **Purpose or Purposes** for which water is used Irrigation

Irrigation (Domestic, irrigation, municipal, manufacturing, industrial, etc.)

6. **Description of Well:** Depth 214 feet. Type Drilled (Dug or drilled)

diameter 10 inches. Elevation of ground at well site 152 (As near as known) feet, mean sea level.

Depth to water table 40 feet.

7. **Capacity of Well:** 250 g.p.m. with 65 feet drawdown.

350 g.p.m. with 70 feet drawdown.

Date of test Sept 1948

If Flowing Well: Measured discharge ..... g.p.m. on ..... (Date)

Shut-in pressure at ground surface ..... lbs. per sq. in. on ..... (Date)

Water is controlled by ..... (Cap, valve, etc.)

8. **Casing:** (Give diameter, commercial specifications and depth below ground surface of each casing size.)

10 inch diameter from 0 to 214 feet

inch diameter from to feet

inch diameter from to feet

inch diameter from to feet

Describe and show depth of shoe, plug, adapter, liner or other details: Base of 10 inch Pipe Rest in 2 ft. of Blue Clay & Gravel.

9. **Perforated Casings or Screens:**

Perforated (Number per foot and size of perforations, or describe screen) from 25 to 127

11 from 202 to 212

from to

from to

10. **Log of Well:** (Describe each stratum or formation clearly, indicate if water bearing, and give thickness and depth as indicated.)

MATERIAL	Thickness (Feet)	Depth to Bottom (Feet)
Surface to 14 ft, Top Soil & Clay	14	
14 to 35 Silt & Sand	21	
35 to 66 Sand with Red Clay	31	
66 to 129 Sand Packer with Silt	63	
129 to 155 Sand & Clay	26	
155 to 201 Blue Clay	46	
201 to 212 - Dark Color Sand	11	
212 to 214 Blue Shale	2	214

– 515 A

If log of well is not available, give name and address of driller. R. J. Stanley
8110 S.E. Sunset Lane Portland, Oregon

11. **Infiltration Trench:** Covered or open .....

Dimensions: Length ..... ft. Minimum depth ..... ft. Maximum depth ..... ft.

Bottom width ..... ft. Discharge ..... g.p.m. Date of test .....

12. **Tunnel:** Type of lining .....

Dimensions: .....
(Length, course, and cross sectional size)

Position of water bearing stratum with reference to portal of tunnel .....

Log of tunnel: (Preceding table for log of well may be used, if desired. Give footage from portal and character of materials, as pertinent.)

13. **Pumping Equipment:**

(a) Pump Peerless Turbine (Make, type and size) Capacity 250 & 20 g.p.m.

(b) Motor 15 H.P. 1750 R.P.M. Hollow Shaft Turbine (Type and horsepower)

14. **Location of area irrigated or to be irrigated, or place of use if for purposes other than irrigation.**

Township North or South	Range E. or W. of Willamette Meridian	Section	Forty-acre Tract	Number Acres To Be Irrigated	Date of Reclamation
S 4	2 W	22	N.W.	~~80~~	Oct 1, 19??
T 4 S	R 2 W	22	SW¼ of NW¼	40	" "
"	"	"	SE¼ of NW¼	30	" "
				70 Total	" "

15. If the ground water supply is supplemental to an existing water supply, identification of any application for a permit, permit, certificate or adjudicated right to appropriate water made or held by the registrant.

.....

.....

Sec 22 Township 4 S Range 2 W, W.M.

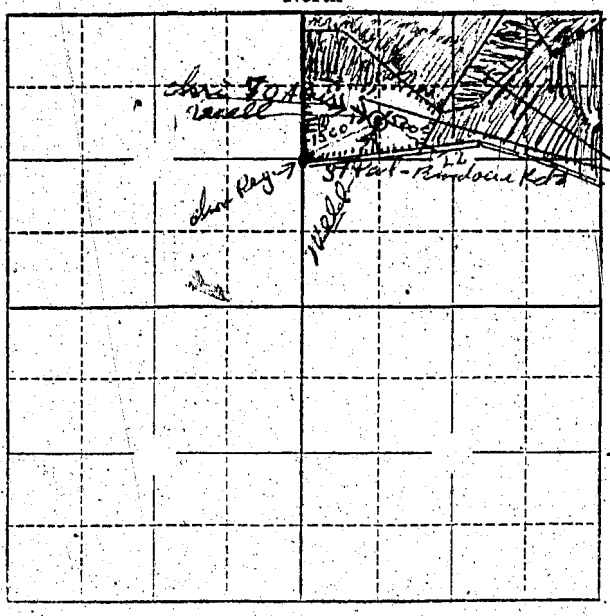

Locate well and acreage of irrigated land on plat.

Scale: 2" = 1 Mile

STATE OF OREGON
County of Multnomah } ss.

I, George A Fick and Mary Ellen Fick, being first duly sworn, do hereby certify that I have read the foregoing Registration Statement and that all of the items therein contained are true to the best of my knowledge and belief.

George A Fick
Mary Ellen Fick
(Signature of Registrant)

Subscribed and sworn to before me this 7 day of May, 1957

My commission expires NOTARY PUBLIC FOR OREGON My Commission Expires Oct. 4, 1960
NOTARY PUBLIC FOR OREGON
My Commission Expires Oct. 4, 1960
(Notary Public)

(SEAL)

CERTIFICATE OF REGISTRATION

STATE OF OREGON
County of Marion } ss.

This is to certify that the foregoing Registration Statement was received in the office of the State Engineer on the 14th day of May, 19 57, at 8:00 o'clock A. M. and has been duly recorded in said office in Book No. 3 of Registration Statements on page GR-515 C

~~Construction work was completed by X-X-X-X-X-X-X-X-X-X, 19X-X-X, and the water was completely applied to beneficial use by X-X-X-X-X-X-X-X-X-X 19-X-X-X~~

Witness my hand this 24th day of July, 19 57

Lewis A. Stanley
(State Engineer)

$21.00

By
(Deputy)

GR-515 C