

# Registration Statement

REGISTRATION NO. GR-489  
CERTIFICATE NO. GR 470

## OF CLAIMANT OF RIGHT TO APPROPRIATE GROUND WATER

(Under Chapter 708, Oregon Laws 1955.)

For Map -  
See G-650

TO THE STATE ENGINEER OF OREGON:

I, B E Stratton  
of Route 2 Box 55 County of MARION  
State of OREGON, do hereby make application for a certificate of registration as evidence of a right to appropriate ground water.

1. Source from which water is withdrawn is Pump wells #1  
(Flowing well, pump well, infiltration trench, or tunnel)
2. Location is: 7 Miles N.W. of Salem  
(Approximate distance and direction from nearest city or town)

and is more particularly described as follows:

- (a) 1150.0 feet North and 957.5 Feet East of SW corner of Sec 28  
(Give distance and bearing to corner of section or other legal subdivision)  
being within SW 1/4 at NW 1/4 of Sec. 28, Twp. 6S, Rge. 3W  
(Smallest legal subdivision) (N. or S.) (E. or W.)
- or (b) within limits of recorded platted property, town or city:  
in Lot \_\_\_\_\_, Block \_\_\_\_\_ of \_\_\_\_\_  
(Name of plat or addition)

County of \_\_\_\_\_  
(If within city or town, give name)

3. Construction Work was begun on 6-1-47; was completed on 6-10-47  
(Date) (Date)  
and the ground water claimed was first used for the purposes set out below on 6-15-47  
(Date)  
since which time the water has been used Continuously during season  
(Continuously or intermittently)  
from 6-15-47 to \_\_\_\_\_  
(Date) (Date)

4. Quantity of water claimed and used is 350 gallons per minute; \_\_\_\_\_ acre feet per year.

5. Purpose or Purposes for which water is used irrigation.

(Domestic, irrigation, municipal, manufacturing, industrial, etc.)

6. Description of Well: Depth 42 feet. Type drilled  
(Dug or drilled)  
diameter 8 inches. Elevation of ground at well site \_\_\_\_\_ feet, mean sea level.  
(As near as known)  
Depth to water table 17 feet.

7. Capacity of Well: 350 g.p.m. with 10 feet drawdown.  
\_\_\_\_\_ g.p.m. with \_\_\_\_\_ feet drawdown.

Date of test Fall 1956

If Flowing Well: Measured discharge \_\_\_\_\_ g.p.m. on \_\_\_\_\_  
(Date)


Shut-in pressure at ground surface \_\_\_\_\_ lbs. per sq. in. on \_\_\_\_\_  
(Date)

Water is controlled by \_\_\_\_\_  
(Cap, valve, etc.)





Township 76 S Range R. 34 W, W.M.  
North

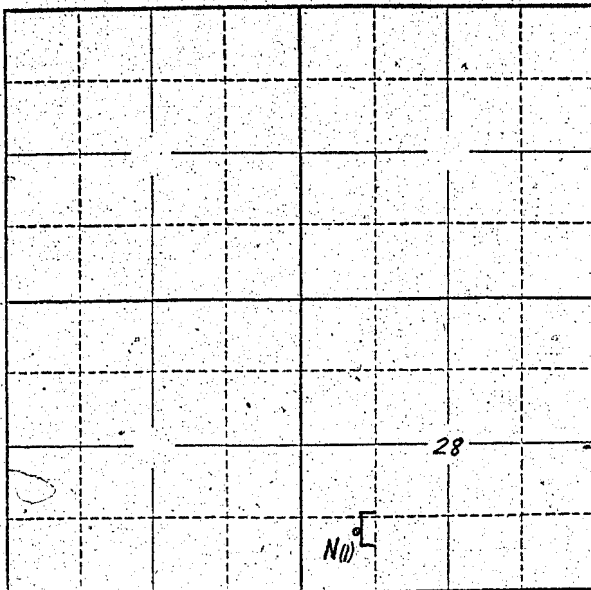

Locate well and acreage of irrigated land on plat.  
Scale: 2" = 1 Mile

STATE OF OREGON

County of .....

} ss.

I, ....., being first duly sworn, do hereby certify that I have read the foregoing Registration Statement and that all of the items therein contained are true to the best of my knowledge and belief.

.....  
(Signature of Registrant)

Subscribed and sworn to before me this ..... day of ....., 19.....

My commission expires .....

.....  
(Notary Public)

(SEAL)

See Page GR-470 G for  
**CERTIFICATE OF REGISTRATION**

STATE OF OREGON

County of Marion

} ss.

~~This is to certify that the foregoing Registration Statement was received in the office of the State Engineer on the x-x-x day of x-x-x-x-x-x-x-x at x-x-x o'clock x-x-x and has been duly recorded in said office in Book No. x-x-x-x-x of Registration Statements on page x-x-x-x-x-x~~

~~Construction shall be completed by x-x-x-x-x-x-x-x and the water completely applied to beneficial use by x-x-x-x-x-x-x-x~~

Witness my hand this ..... day of ....., 19.....

.....  
(State Engineer)

By .....

.....  
(Deputy)

GR - 470 C

Registration Statement

REGISTRATION NO. GR-489  
CERTIFICATE NO. GR 470

OF CLAIMANT OF RIGHT TO APPROPRIATE GROUND WATER

(Under Chapter 708, Oregon Laws 1955.)

TO THE STATE ENGINEER OF OREGON:

I, B.E. STRATTON

of Route 2 Box 55 County of Marion

State of \_\_\_\_\_, do hereby make application for a certificate of registration as evidence of a right to appropriate ground water.

1. Source from which water is withdrawn is Pump Well #2  
(Flowing well, pump well, infiltration trench, or tunnel)

2. Location is: 7 Miles NW of Salem  
(Approximate distance and direction from nearest city or town)

and is more particularly described as follows:

(a) 2547.7 feet North and 436.9 feet East from SW corner of Sec 28  
(Give distance and bearing to corner of section or other legal subdivision)

being within NW 1/4 of SW 1/4 of Sec. 28, Twp. 6 S, Rge. 3 W  
(Smallest legal subdivision) (N. or S.) (E. or W.)

or (b) within limits of recorded platted property, town or city:

in Lot \_\_\_\_\_, Block \_\_\_\_\_ of \_\_\_\_\_  
(Name of plat or addition)

County of \_\_\_\_\_  
(If within city or town, give name)

3. Construction Work was begun on 4-1-45; was completed on 4-10-45  
(Date) (Date)

and the ground water claimed was first used for the purposes set out below on 5-15-45  
(Date)

since which time the water has been used continuously  
(Continuously or intermittently)

from 5-15-45 to \_\_\_\_\_  
(Date) (Date)

4. Quantity of water claimed and used is 350 gallons per minute; \_\_\_\_\_ acre feet per year.

5. Purpose or Purposes for which water is used

Irrigation  
(Domestic, irrigation, municipal, manufacturing, industrial, etc.)

6. Description of Well: Depth 44 feet. Type Drilled  
(Dug or drilled)

diameter 8 inches. Elevation of ground at well site \_\_\_\_\_ feet, mean sea level  
(As near as known)

Depth to water table 27 feet.

7. Capacity of Well: 350 g.p.m. with 17 feet drawdown.

\_\_\_\_\_ g.p.m. with \_\_\_\_\_ feet drawdown.

Date of test 6-1-45

If Flowing Well: Measured discharge \_\_\_\_\_ g.p.m. on \_\_\_\_\_  
(Date)

Shut-in pressure at ground surface \_\_\_\_\_ lbs. per sq. in. on \_\_\_\_\_  
(Date)


Water is controlled by \_\_\_\_\_  
(Cap, valve, etc.)

GR - 470 D





Township T 6 S Range R 3 W, W.M.  
North

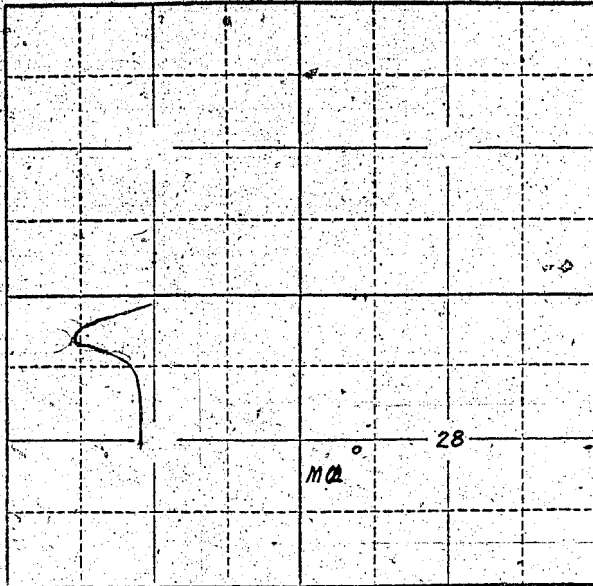

Locate well and acreage of irrigated land on plat:  
Scale: 2" = 1 Mile

STATE OF OREGON

County of \_\_\_\_\_

ss.

I, Byron E. Stratton, being first duly sworn, do hereby certify that I have read the foregoing Registration Statement and that all of the items therein contained are true to the best of my knowledge and belief.

Byron E. Stratton  
(Signature of Registrant)

Subscribed and sworn to before me this 14th day of May, 1957.

My commission expires Sept. 9, 1960

[Signature]  
(Notary Public)

(SEAL)

**CERTIFICATE OF REGISTRATION**

STATE OF OREGON

County of Marion

ss.

This is to certify that the foregoing Registration Statement was received in the office of the State Engineer on the 11th day of May, 1957, at 10:00 o'clock A. M. and has been duly recorded in said office in Book No. 3 of Registration Statements on page GR-170 C.

~~Construction shall be completed by \_\_\_\_\_ and the water completely applied for beneficial use by \_\_\_\_\_~~

Witness my hand this 26th day of June, 1957.

Lewis A. Stanley  
(State Engineer)

By \_\_\_\_\_  
(Deputy)

#1905

GR - 470 G