RECEIVED
MAY 9 1957
STATE ENGINEER
SALEM, OREGON

REGISTRATION NO. GR 490
CERTIFICATE NO. GR 471

Registration Statement

OF CLAIMANT OF RIGHT TO APPROPRIATE GROUND WATER

(Under Chapter 708, Oregon Laws 1955.)

TO THE STATE ENGINEER OF OREGON:

I, Alex Eisichen,

of Rt 1 Box 2 B Cornelius County of Washington

State of Oregon, do hereby make application for a certificate of registration as evidence of a right to appropriate ground water.

1. **Source** from which water is withdrawn is Well- pump
(Flowing well, pump well, infiltration trench, or tunnel)

2. **Location** is: One/half mile north of Cornelius, Oregon;
(Approximate distance and direction from nearest city or town)

and is more particularly described as follows:

(a), 2090 feet N. and 1955 feet W. ~~corner of~~ from SE corner of Section 33.
(Give distance and bearing to corner of section or other legal subdivision)

being within NW¼ of SE¼ of Sec. 33, Twp. 1 N (N. or S.), Rge. 3 W. W. M. (E. or W.)
(Smallest legal subdivision)

or ~~(b)~~ within limits of recorded platted property, town or city:

in Lot ....., Block ..... of .....
(Name of plat or addition)

..... County of .....
(If within city or town, give name)

3. **Construction Work** was begun on May, 1953 (Date); was completed on Aug, 1953 (Date)

and the ground water claimed was first used for the purposes set out below on Late summer, 1953 (Date),

since which time the water has been used Continuously
(Continuously or intermittently)

from Aug 1953 (Date) to Date (Date)

4. **Quantity** of water claimed and used is 40 gallons per minute; 26 acre feet per year.

5. **Purpose or Purposes** for which water is used Irrigation
(Domestic, irrigation, municipal, manufacturing, industrial, etc.)

6. **Description of Well:** Depth 50 feet. Type Drilled (Dug or drilled)

diameter 6 inches. Elevation of ground at well site 75 (As near as known) feet, mean sea level.

Depth to water table 14 feet.

7. **Capacity of Well:** 40 g.p.m. with 14 feet drawdown.

..... g.p.m. with ..... feet drawdown.

Date of test July 1953

If Flowing Well: Measured discharge ..... g.p.m. on ..... (Date)

Shut-in pressure at ground surface ..... lbs. per sq. in. on ..... (Date)

Water is controlled by .....
(Cap, valve, etc.)

8. **Casing:** (Give diameter, commercial specifications and depth below ground surface of each casing size.)

6 inch diameter from Top to Bottom feet

..... inch diameter from ..... to ..... feet

..... inch diameter from ..... to ..... feet

..... inch diameter from ..... to ..... feet

Describe and show depth of shoe, plug, adapter, liner or other details: .....

9. **Perforated Casings or Screens:**

Louvre 1¼ ft of casing [illegible]tted from ..... to .....
(Number per foot and size of perforations, or describe screen)

..... from ..... to .....

..... from ..... to .....

..... from ..... to .....

10. **Log of Well:** (Describe each stratum or formation clearly, indicate if water bearing, and give thickness and depth as indicated.)

MATERIAL	Thickness (Feet)	Depth to Bottom (Feet)
Top soil and clay	15	15
Quicksand	10	25
Blue clay	25	50
Gravel at bottom of well.		

If log of well is not available, give name and address of driller. .....

.....

11. **Infiltration Trench:** Covered or open .....

Dimensions: Length ..... ft. Minimum depth ..... ft. Maximum depth ..... ft.

Bottom width ..... ft. Discharge ..... g.p.m. Date of test .....

12. **Tunnel:** Type of lining .....

Dimensions: .....
(Length, course, and cross sectional size)

Position of water bearing stratum with reference to portal of tunnel .....

.....

Log of tunnel: (Preceding table for log of well may be used, if desired. Give footage from portal and character of materials, as pertinent.)

13. **Pumping Equipment:**

(a) Pump Berkley - 2 hp Electric (Make, type and size) Capacity 40 g.p.m.

(b) Motor .....
(Type and horsepower)

14. Location of area irrigated or to be irrigated, or place of use if for purposes other than irrigation.

Township North or South	Range E. or W. of Willamette Meridian	Section	Forty-acre Tract	Number Acres To Be Irrigated	Date of Reclamation
1N	3W	33	SE¼ of NW¼	8	Summer 1953
1N	3W	33	SW¼ of NE¼	8	" "
1N	3W	33	NE¼ of SW¼	16	" "
1N	3W	33	NW¼ of SE¼	21	" "
				53 AC.	

15. If the ground water supply is supplemental to an existing water supply, identification of any application for a permit, permit, certificate or adjudicated right to appropriate water made or held by the registrant.

.....

.....

Township 1N Range 3W, W.M.

North

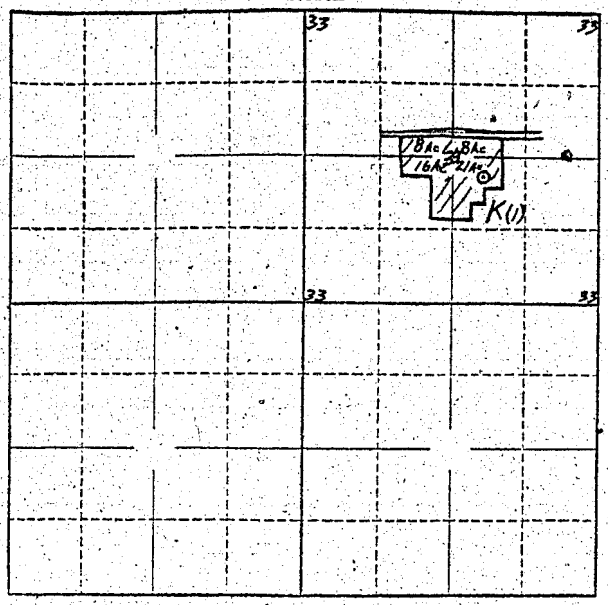

Locate well and acreage of irrigated land on plat.

Scale: 2" = 1 Mile

STATE OF OREGON
County of Washington } ss.

I, Alex Eischen, being first duly sworn, do hereby certify that I have read the foregoing Registration Statement and that all of the items therein contained are true to the best of my knowledge and belief.

x Alex Eischen
(Signature of Registrant)

Subscribed and sworn to before me this 3 day of May, 1957

My commission expires NOTARY PUBLIC FOR OREGON
My Commission Expires July 30, 1958

Joffel L. Crone
(Notary Public)

(SEAL)

NOTARY PUBLIC FOR OREGON
My Commission Expires July 30, 1958

CERTIFICATE OF REGISTRATION

STATE OF OREGON
County of Marion } ss.

This is to certify that the foregoing Registration Statement was received in the office of the State Engineer on the 17th day of May, 1957, at 9:30 o'clock A. M. and has been duly recorded in said office in Book No. 3 of Registration Statements on page GR-471 C

~~Construction shall be completed by x-x-x-