

GR-50  
GR-366

RECEIVED  
JUL 20 1955  
STATE ENGINEER  
OF OREGON

### Registration Statement

OF CLAIMANT OF RIGHT TO APPROPRIATE GROUND WATER,  
(Under Chapter 703, Oregon Laws 1955.)

TO THE STATE ENGINEER OF OREGON:

I, Garry P. H. Paulsen  
of Clatsop County of Marion  
State of Oregon, do hereby make application for a certificate of registration as evidence  
of a right to appropriate ground water.

- 1. Source from which water is withdrawn is Pump Well  
(Flowing well, pump well, infiltration trench, or tunnel)
- 2. Location is: 3/4 mile West of Aurora  
(Approximate distance and direction from nearest city or town)

and is more particularly described as follows:

(a) Approx. 1250' W. and 150' S. from Sec. 11-12-13-14  
(Give distance and bearing to corner of section or other legal subdivision)  
being within NE 1/4 of the NE 1/4 of Sec. 14, Twp. 4S, Rge. 1W  
(Smallest legal subdivision) (N. or S.) (E. or W.)

or (b) within limits of recorded platted property, town or city:  
in Lot \_\_\_\_\_ Block \_\_\_\_\_ of \_\_\_\_\_  
(Name of plat or addition)  
County of Marion  
(If within city or town, give name)

3. Construction Work was begun on 3-1950; was completed on July 13-1950  
and the ground water claimed was first used for the purposes set out below on Right Away  
since which time the water has been used Every summer season  
(Continuously or intermittently)

4. Quantity of water claimed and used is 32 298 gallons per minute; 9 gal acre  
feet per year.

5. Purpose or Purposes for which water is used Irrigation  
(Domestic, irrigation, municipal, manufacturing, industrial, etc.)

6. Description of Well: Depth 11.8 feet. Type Drilled  
(Dug or drilled)  
diameter 10 inches. Elevation of ground at well site: 145 feet, mean sea level.  
(As near as known)  
Depth to water table 25 feet.

7. Capacity of Well: 600 g.p.m. with 90 feet drawdown.  
\_\_\_\_\_ g.p.m. with \_\_\_\_\_ feet drawdown.

Date of test July 13-1950

If Flowing Well: Measured discharge \_\_\_\_\_ g.p.m. on \_\_\_\_\_  
(Date)

Shut-in pressure at ground surface \_\_\_\_\_ lbs. per sq. in. on \_\_\_\_\_  
(Date)

Water is controlled by \_\_\_\_\_  
(Cap, valve, etc.)

8. Casing: (Give diameter, commercial specifications and depth below ground surface of each casing size.)

10 inch diameter ..... from 0 to 102 feet  
 inch diameter ..... from ..... to ..... feet  
 inch diameter ..... from ..... to ..... feet  
 inch diameter ..... from ..... to ..... feet

Describe and show depth of shoe, plug, adapter, liner or other details: *None*

9. Perforated Casings or Screens:

*16 - 1/4 by 3* from *70'* to *80'*  
(Number per foot and size of perforations, or describe screen)  
*16 - 1/4 by 3* from *85'* to *100'*  
 from ..... to .....  
 from ..... to .....

10. Log of Well: (Describe each stratum or formation clearly, indicate if water bearing, and give thickness and depth as indicated.)

MATERIAL	Thickness (Feet)	Depth to Bottom (Feet)
Surface	0-3	
Yellow Clay	3-21	
Sandy Clay Water	21-26	
Yellow Clay	26-58	
<del>Black</del> Blue Clay, <del>hard</del>	58-61	
Black "	61-70	
Light Grey sand & broken gravel	70-73	
<del>Dark</del> Light Grey clay	73-98	
<del>Dark</del> clay Blue	98-106	
Grey clay	106-110	
Light Small Gravel	110-118	
Well perforated 140 Holes	78	98
" " 10 "	60	61

If log of well is not available, give name and address of driller. ....

11. Infiltration Trench: Covered or open .....

Dimensions: Length ..... ft. Minimum depth ..... ft. Maximum depth ..... ft.

Bottom width ..... ft. Discharge ..... g.p.m. Date of test .....

12. Tunnel: Type of lining .....

Dimensions: .....  
(Length, course, and cross sectional size)

Position of water bearing stratum with reference to portal of tunnel .....

Log of tunnel: (Preceding table for log of well may be used, if desired. Give footage from portal and character of materials, as pertinent.)

13. Pumping Equipment:

(a) Pump *Becker, Turbine* Capacity *350* g.p.m.  
(Make, type and size)


(b) Motor *2.0 Horsepower Turbine Electric*  
(Type and horsepower)

14. Location of area irrigated or to be irrigated, or place of use if for purposes other than irrigation.

Township North or South	Range E. or W. of Williams Meridian	Section	Forty-acre Tract	Number Acres To Be Irrigated	Date of Reclamation
45	1W	11	SE 1/4	85.6	
			1A NE 1/4	33.4	
74	R1	9	11	20	
4	R1W	5	11	41.1	
				120.0	
45	1W	11	NW 1/4 of SE 1/4	10	1950
"	"	"	NE 1/4 of SE 1/4	10	1950
"	"	"	SW 1/4 of SE 1/4	30	1950
"	"	"	SE 1/4 of SE 1/4	25	1950
45	1W	14	NW 1/4 of NE 1/4	15	1950
"	"	"	NE 1/4 of NE 1/4	20	4. A earlier 16A 1954
"	"	"	SW 1/4 of NE 1/4	4	1950
"	"	"	SE 1/4 of NE 1/4	6	1950
				Total 120	

15. If the ground water supply is supplemental to an existing water supply, identification of any application for a permit, permit, certificate or adjudicated right to appropriate water made or held by the registrant.

Township 45 Range 1 W. W.M.  
North

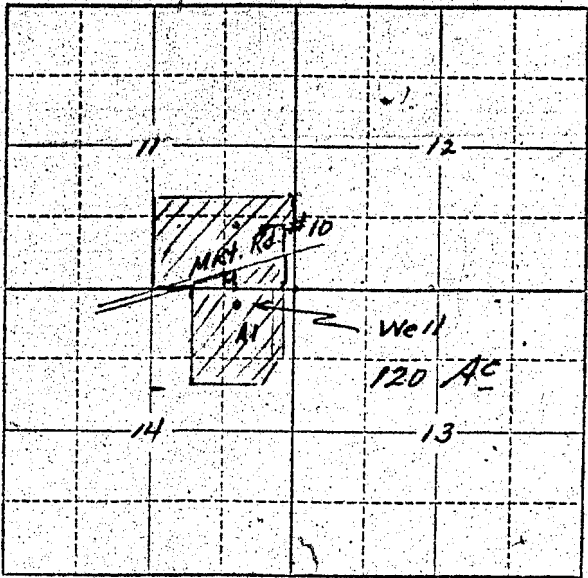

Locate well and acreage of irrigated land on plat.  
Scale: 2" = 1 Mile

STATE OF OREGON }  
County of Marion } ss.

I, \_\_\_\_\_, being first duly sworn, do hereby certify that I have read the foregoing Registration Statement and that all of the items therein contained are true to the best of my knowledge and belief.

George Parsley  
(Signature of Registrant)

Subscribed and sworn to before me this 11 day of November, 1955

My commission expires July 30, 1955 D. H. Mills  
(Notary Public)

(SEAL)

**CERTIFICATE OF REGISTRATION**

STATE OF OREGON }  
County of Marion } ss.

This is to certify that the foregoing Registration Statement was received in the office of the State Engineer on the 14 day of December, 1955, at nine o'clock A.M. and has been duly recorded in said office in Book No. 3 of Registration Statements on page QR-366 C

~~Construction work is completed by \_\_\_\_\_ and the water is applied to \_\_\_\_\_~~  
~~inspired by \_\_\_\_\_~~

Witness my hand this 30th day of April, 1957

Luella A. Stanley  
(State Engineer)

#26.50

By \_\_\_\_\_  
(Deputy)