

Registration Statement

OF CLAIMANT OF RIGHT TO APPROPRIATE GROUND WATER

(Under Chapter 708, Oregon Laws 1955.)

TO THE STATE ENGINEER OF OREGON:

I, Cecil E. Statzer

of Springfield County of Lane

State of Oregon, do hereby make application for a certificate of registration as evidence of a right to appropriate ground water.

1. Source from which water is withdrawn is Pump well
(Flowing well, pump well, infiltration trench, or tunnel)

2. Location is: 10 miles East of Springfield
(Approximate distance and direction from nearest city or town)

and is more particularly described as follows:

(a) North 42° 59' West 1750.8 feet to the Northwest corner of Section 29
(Give distance and bearing to corner of section or other legal subdivision)

being within Southeast quarter section of Sec. 29, Twp. 17 South, Rge. 1 West
(Smallest legal subdivision) (N. or S.) (E. or W.)

or (b) within limits of recorded platted property, town or city:

in Lot _____, Block _____ of _____
(Name of plat or addition)
County of _____
(If within city or town, give name)

3. Construction Work was begun on August 1950; was completed on August 1950
(Date) (Date)

and the ground water claimed was first used for the purposes set out below on August 1950
(Date)

since which time the water has been used intermittently
(Continuously or Intermittently)

from August 1950 to present
(Date) (Date)

4. Quantity of water claimed and used is 20 gallons per minute; 2.76 acre feet per year.

5. Purpose or Purposes for which water is used irrigation

(Domestic, irrigation, municipal, manufacturing, industrial, etc.)

6. Description of Well: Depth 17 feet. Type drilled
(Dug or drilled)

diameter 2 inches. Elevation of ground at well site 560 feet, mean sea level.
(As near as known)

Depth to water table 8 feet.

7. Capacity of Well: _____ g.p.m. with _____ feet drawdown.


_____ g.p.m. with _____ feet drawdown.

Date of test No tests made

If Flowing Well: Measured discharge _____ g.p.m. on _____
(Date)

Shut-in pressure at ground surface _____ lbs. per sq. in. on _____
(Date)

Water is controlled by _____
(Cap, valve, etc.)

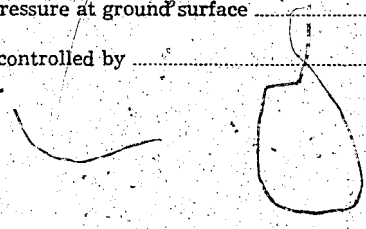

8. Casing: (Give diameter, commercial specifications and depth below ground surface of each casing size.)

two inch diameter G. I. from 0 to 17 feet
 inch diameter from to feet
 inch diameter from to feet
 inch diameter from to feet

Describe and show depth of shoe, plug, adapter, liner or other details:

9. Perforated Casings or Screens:

Bottom of pipe slotted Approximately 10 slots per foot from 15 to 17 feet
(Number per foot and size of perforations, or describe screen)

from to
 from to
 from to

10. Log of Well: (Describe each stratum or formation clearly, indicate if water bearing, and give thickness and depth as indicated.)

MATERIAL	Thickness (Feet)	Depth to Bottom (Feet)
Log not available		

If log of well is not available, give name and address of driller Miller Jensen Company

2880 Elmira Road, Eugene, Oregon

11. Infiltration Trench: Covered or open

Dimensions: Length ft. Minimum depth ft. Maximum depth ft.

Bottom width ft. Discharge g.p.m. Date of test

12. Tunnel: Type of lining

Dimensions:
(Length, course, and cross sectional size)

Position of water bearing stratum with reference to portal of tunnel

Log of tunnel: (Preceding table for log of well may be used, if desired. Give footage from portal and character of materials, as pertinent.)

13. Pumping Equipment:

(a) Pump Capacity 20 g.p.m.
(Make, type and size)


(b) Motor G. E. 220 volts 3 ph. 1½ H.P.
(Type and horsepower)

14. Location of area irrigated or to be irrigated, or place of use if for purposes other than irrigation.

Township North or South	Range E. or W. of Willamette Meridian	Section	Forty-acre Tract	Number Acres To Be Irrigated	Date of Reclamation
17 S.	1 W.	29	NW ¼ of S.E. Quarter	3.8	August 1951

15. If the ground water supply is supplemental to an existing water supply, identification of any application for a permit, permit, certificate or adjudicated right to appropriate water made or held by the registrant.

Township 17 S Range 1 W, W.M.
North

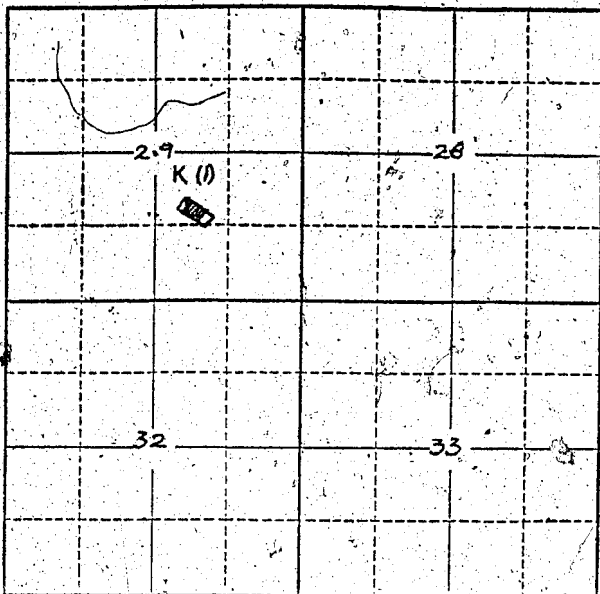

Locate well and acreage of irrigated land on plat.

Scale: 2" = 1 Mile

Acreage = 3.8

STATE OF OREGON

County of Lane } ss.

I, Cecil E. Statzer, being first duly sworn, do hereby certify that I have read the foregoing Registration Statement and that all of the items therein contained are true to the best of my knowledge and belief.

Cecil E. Statzer
(Signature of Registrant)

Subscribed and sworn to before me this 22nd day of April, 1957.

My commission expires _____

(Notary Public)

(SEAL)

My Commission Expires Aug. 25, 1959

CERTIFICATE OF REGISTRATION

STATE OF OREGON

County of Marion } ss.

This is to certify that the foregoing Registration Statement was received in the office of the State Engineer on the 27th day of May, 1957, at 8:00 o'clock A. M. and has been duly recorded in said office in Book No. 3 of Registration Statements on page GR-481 C.

~~For the water to be completed by _____ and the water completed, applied to _____ by _____~~

Witness my hand this 21th day of July, 1957

Laura A. Stanley
(State Engineer)

By _____

(Deputy)

\$15.00