RECEIVED
MAR 13 1957
STATE ENGINEER
SALEM, OREGON

REGISTRATION NO. GR-503
CERTIFICATE NO. 482

Registration Statement

OF CLAIMANT OF RIGHT TO APPROPRIATE GROUND WATER

(Under Chapter 708, Oregon Laws 1955.)

RECEIVED
MAY 28 1957
STATE ENGINEER
SALEM, OREGON

TO THE STATE ENGINEER OF OREGON:

I, MACK G. BENNETT & THEA G. BENNETT, of RT. 2, NEWBERG County of YAMHILL State of OREGON, do hereby make application for a certificate of registration as evidence of a right to appropriate ground water.

1. **Source** from which water is withdrawn is PUMP WELL (Flowing well, pump well, infiltration trench, or tunnel)
2. **Location is:** 2 miles NE NEWBERG (Approximate distance and direction from nearest city or town);

and is more particularly described as follows:

(a) 1070 ft. S.W. of the NE. corner of section 17 (Give distance and bearing to corner of section or other legal subdivision)

being within NE¼ of NE¼ (Smallest legal subdivision) of Sec. 17, Twp. 3 S (N. or S.), Rge. 2 W (E. or W.)

or (b) within limits of recorded platted property, town or city: .....

in Lot ....., Block ..... of ..... (Name of plat or addition)

..... (If within city or town, give name) County of .....

3. **Construction Work** was begun on Oct. 1950 (Date); was completed on Nov. 1950 (Date) and the ground water claimed was first used for the purposes set out below on JUNE, 1951 (Date), since which time the water has been used for summer pasture irrigation. (Continuously or intermittently) from June 1 (Date) to Oct. 1 (Date)
4. **Quantity** of water claimed and used is 25 gallons per minute; ..... acre feet per year.
5. **Purpose or Purposes** for which water is used [redacted] irrigation (Domestic, irrigation, municipal, manufacturing, industrial, etc.)
6. **Description of Well:** Depth 200½ feet. Type drilled (Dug or drilled) diameter 12 inches. Elevation of ground at well site [redacted] 240 (As near as known) feet, mean sea level. Depth to water table 45 feet.
7. **Capacity of Well:** 25 g.p.m. with 180 feet drawdown.

..... g.p.m. with ..... feet drawdown.

Date of test .....

If Flowing Well: Measured discharge ..... g.p.m. on ..... (Date)

Shut-in pressure at ground surface ..... lbs. per sq. in. on ..... (Date)

Water is controlled by ..... (Cap, valve, etc.)

8. **Casing:** (Give diameter, commercial specifications and depth below ground surface of each casing size.)

12 inch diameter from 0 to 194½ feet

inch diameter from to feet

inch diameter from to feet

inch diameter from to feet

Describe and show depth of shoe, plug, adapter, liner or other details:

Atlas steel drive shoe at 194½ ft.

9. **Perforated Casings or Screens:**

¼ inch wide, 1 ft. long on both sides from to
(Number per foot and size of perforations, or describe screen)

Cutting starts at 77 ft. and from to

ends at 194 ft. from to

from to

10. **Log of Well:** (Describe each stratum or formation clearly, indicate if water bearing, and give thickness and depth as indicated.)

MATERIAL	Thickness (Feet)	Depth to Bottom (Feet)
0 to 25 ft. clay		
25 to 135 " brown broken shale		
135 " 142 " broken blue basalt		
142 " 170 " broken shale hard		
170 " 172 " broken basalt		
172 " 187 " brown shale hard		
187 " 192 " broken blue basalt hard		
192 " 200 " brown broken shale very hard		
200 " basalt very hard		

If log of well is not available, give name and address of driller. John Meeker

11. **Infiltration Trench:** Covered or open .....

Dimensions: Length ..... ft. Minimum depth ..... ft. Maximum depth ..... ft.

Bottom width ..... ft. Discharge ..... g.p.m. Date of test .....

12. **Tunnel:** Type of lining .....

Dimensions: .....
(Length, course, and cross sectional size)

Position of water bearing stratum with reference to portal of tunnel .....

Log of tunnel: (Preceding table for log of well may be used, if desired. Give footage from portal and character of materials, as pertinent.)

13. **Pumping Equipment:**

(a) Pump Fairbanks Morse, "Little Chief" Capacity ..... g.p.m.
(Make, type and size)

(b) Motor 5 horsepower 3 phase
(Type and horsepower)

14. Location of area irrigated or to be irrigated, or place of use if for purposes other than irrigation.

Township North or South	Range E. or W. of Willamette Meridian	Section	Forty-acre Tract	Number Acres To Be Irrigated	Date of Reclamation
T 3 S	2 W	17	NE¼ of NE¼	10	June, 1957
		(and water in house + barn)			

15. If the ground water supply is supplemental to an existing water supply, identification of any application for a permit, permit, certificate or adjudicated right to appropriate water made or held by the registrant.

Township 3 S Range 2 W, W.M.

North

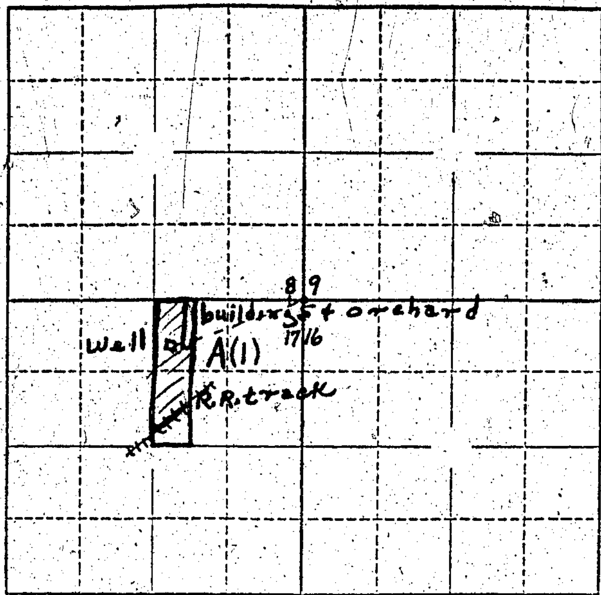

(irrigated land lies north of the R.R. track)

Locate well and acreage of irrigated land on plat.

Scale: 1/4" = 1 Mile

STATE OF OREGON }
County of Yamhill } ss.

I, Mack G. Bennett & Thea G. Bennett, being first duly sworn, do hereby certify that I have read the foregoing Registration Statement and that all of the items therein contained are true to the best of my knowledge and belief.

Mack G. Bennett
Thea G Bennett
(Signature of Registrant)

Subscribed and sworn to before me this 11th day of March, 1957

My commission expires November 30, 1959 — Frenelle Yackey (Notary Public)

(SEAL)

CERTIFICATE OF REGISTRATION

STATE OF OREGON }
County of Marion } ss.

This is to certify that the foregoing Registration Statement was received in the office of the State Engineer on the 28th day of May, 19 57, at 8:00 o'clock A. M. and has been duly recorded in said office in Book No. 3 of Registration Statements on page GR-482 C

~~Construction shall be completed by x-x-x-x-x-x-x-x-x, 19x-x, and the water completely applied to beneficial use by x-x-x-x-x-x-x-x-x, 19x-x-x-x~~

Witness my hand this 24th day of July, 19 57

Lewis A. Stanley
(State Engineer)

$15.00

By .... (Deputy)

GR - 482 C