

Registration Statement

OF CLAIMANT OF RIGHT TO APPROPRIATE GROUND WATER

TO THE STATE ENGINEER OF OREGON:

I, H. E. Conger

of Route 2, Box 403, Medford County of Jackson

State of Oregon, do hereby make application for a certificate of registration as evidence of a right to appropriate ground water.

1. Source from which water is withdrawn is infiltration trench (sump)
(Flowing well, pump well, infiltration trench, or tunnel)

2. Location is: approx. 5 miles west Northwest from Medford, Oregon
(Approximate distance and direction from nearest city or town)

and is more particularly described as follows:

(a) 1007 feet north and 65 feet West from the SE corner Sec. 16
(Give distance and bearing to corner of section or other legal subdivision)

being within SE SW 4 of Sec. 16, Twp. 37 S., Rge. 2 W.
(Smallest legal subdivision) (N. or S.) (E. or W.)

or (b) within limits of recorded platted property, town or city:

in Lot _____ Block _____ of _____
(Name of plat or addition)

County of _____
(If within city or town, give name)

3. Construction Work was begun on April 1949; was completed on April 1949
(Date) (Date)

and the ground water claimed was first used for the purposes set out below on April 1949
(Date)

since which time the water has been used continuously
(Continuously or intermittently)

from April 1949 to date
(Date) (Date)

4. Quantity of water claimed and used is 250 gallons per minute; 180 acre feet per year.

5. Purpose or Purposes for which water is used irrigation

(Domestic, irrigation, municipal, manufacturing, industrial, etc.)

See Item 61 Description of Well: Depth 6.0 feet. Type dug
(Dug or drilled)

diameter 50" x 350" inches. Elevation of ground at well site 1380 feet, mean sea level.
(As near as known)

Depth to water table 4.2 feet.

7. Capacity of Well: _____ g.p.m. with _____ feet drawdown.

_____ g.p.m. with _____ feet drawdown.


Date of test _____

If Flowing Well: Measured discharge _____ g.p.m. on _____
(Date)

Shut-in pressure at ground surface _____ lbs. per sq. in. on _____
(Date)

Water is controlled by _____
(Cap, valve, etc.)

Township 27 S. Range 2 W., W.M.

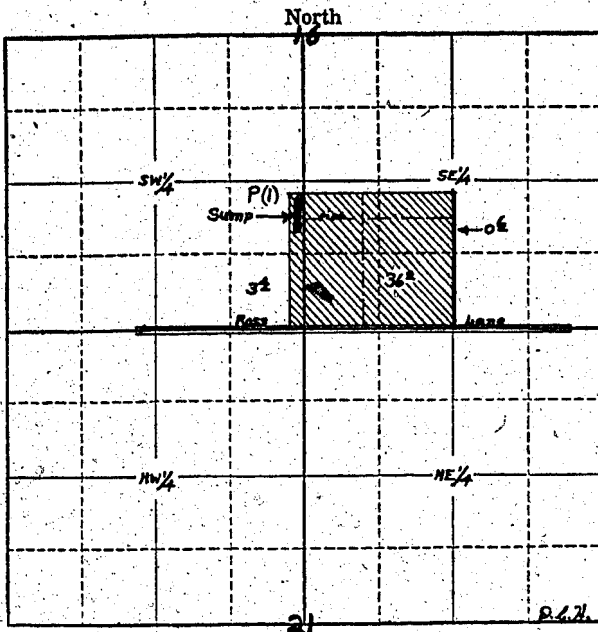

Locate well and acreage of irrigated land on plat.
Scale: 1" = 1 Mile

STATE OF OREGON

County of Jackson

ss.

I, H. E. Conger, being first duly sworn, do hereby certify that I have read the foregoing Registration Statement and that all of the items therein contained are true to the best of my knowledge and belief.

H. E. Conger
(Signature of Registrant)

Subscribed and sworn to before me this 27th day of May, 1957.

My commission expires August 25, 1958.

J. G. [Signature]
(Notary Public)

(SEAL)

CERTIFICATE OF REGISTRATION

STATE OF OREGON

County of Marion

ss.

This is to certify that the foregoing Registration Statement was received in the office of the State Engineer on the 29th day of May, 1957 at 8:00 o'clock A.M. and has been duly recorded in said office in Book No. 3 of Registration Statements on page GR-483 C.

Witness my hand this 21th day of July, 1957.

Lewis A. Stanley
(State Engineer)

By _____ (Deputy)