RECEIVED
APR 29 1957
STATE ENGINEER
SALEM, OREGON

RECEIVED
JUN 3 1957
STATE ENGINEER
SALEM, OREGON

REGISTRATION NO. G-R-526

Registration Statement CERTIFICATE NO. GR 485

OF CLAIMANT OF RIGHT TO APPROPRIATE GROUND WATER

(Under Chapter 708, Oregon Laws 1955.)

TO THE STATE ENGINEER OF OREGON:

I, Wayne Peirce,

of 1900 N.W. 272nd Ave., Hillsboro County of Washington

State of Oregon, do hereby make application for a certificate of registration as evidence of a right to appropriate ground water.

1. **Source** from which water is withdrawn is Pump Well (Flowing well, pump well, infiltration trench, or tunnel)

2. **Location is:** 1 Mile East of Hillsboro on 272nd Ave. (Approximate distance and direction from nearest city or town);

and is more particularly described as follows:

(a) From the SE corner John S. Griffin DLC a distance of 1650' South 17°15' East (Give distance and bearing to corner of section or other legal subdivision)

being within SW¼ SE¼ (Smallest legal subdivision) of Sec. 29, Twp. 1 N (N. or S.), Rge. 2 W (E. or W.)

or (b) within limits of recorded platted property, town or city: of Hillsboro

in Lot 13 & 14, Block ..... of Hillsboro Acres (Name of plat or addition)

Hillsboro (If within city or town, give name) County of Washington

3. **Construction Work** was begun on September 1 47 (Date); was completed on September 1 47 (Date)

and the ground water claimed was first used for the purposes set out below on May 1949 (Date),

since which time the water has been used continuously during summer - May - Oct. (Continuously or intermittently)

from May 1949 (Date) to Present Day (Date)

4. **Quantity** of water claimed and used is 60 gallons per minute; 20 acre feet per year.

5. **Purpose or Purposes** for which water is used Irrigation (Domestic, irrigation, municipal, manufacturing, industrial, etc.)

6. **Description of Well:** Depth 50 feet. Type Dug & Drilled (Dug or drilled)

diameter 6" inches. Elevation of ground at well site ~~[illegible]~~ 197 (As near as known) feet, mean sea level.

Depth to water table 12 feet.

7. **Capacity of Well:** 60 g.p.m. with 20 feet drawdown.

..... g.p.m. with ..... feet drawdown.

Date of test 1949

If Flowing Well: Measured discharge ..... g.p.m. on ..... (Date)

Shut-in pressure at ground surface ..... lbs. per sq. in. on ..... (Date)

Water is controlled by ..... (Cap, valve, etc.)

8. **Casing:** (Give diameter, commercial specifications and depth below ground surface of each casing size.)

6 inch diameter Steel Wall Casing from 0 to 50 feet

..... inch diameter ..... from ..... to ..... feet

..... inch diameter ..... from ..... to ..... feet

..... inch diameter ..... from ..... to ..... feet

Describe and show depth of shoe, plug, adapter, liner or other details: None

9. **Perforated Casings or Screens:**

NONE from ..... to .....
(Number per foot and size of perforations, or describe screen)

..... from ..... to .....

..... from ..... to .....

..... from ..... to .....

10. **Log of Well:** (Describe each stratum or formation clearly, indicate if water bearing, and give thickness and depth as indicated.)

MATERIAL	Thickness (Feet)	Depth to Bottom (Feet)
Topsoil	2'	2'
Clay	18	20
Quicksand	15	35
Blue Clay	15	50
Small Gravel	UNK	UNK

GR - 485 A

If log of well is not available, give name and address of driller. .....

.....

11. **Infiltration Trench:** Covered or open N/A

Dimensions: Length ..... ft. Minimum depth ..... ft. Maximum depth ..... ft.

Bottom width ..... ft. Discharge ..... g.p.m. Date of test .....

12. **Tunnel:** Type of lining N/A

Dimensions: .....
(Length, course, and cross sectional size)

Position of water bearing stratum with reference to portal of tunnel .....

.....

Log of tunnel: (Preceding table for log of well may be used, if desired. Give footage from portal and character of materials, as pertinent.)

13. **Pumping Equipment:**

(a) Pump Wist Centrifugal 1 ½" (Make, type and size) Capacity 70 gal. g.p.m.

(b) Motor 1 ½ H.P. Single Phase Electric (Type and horsepower)

14. Location of area irrigated or to be irrigated, or place of use if for purposes other than irrigation.

Township North or South	Range E. or W. of Willamette Meridian	Section	Forty-acre Tract	Number Acres To Be Irrigated	Date of Reclamation
1 N	2 W	29	SE ¼ SE ¼	5	May 1949
1 N	2 W	29	SW ¼ SE ¼	5	May 1949
				10 AC	

15. If the ground water supply is supplemental to an existing water supply, identification of any application for a permit, permit, certificate or adjudicated right to appropriate water made or held by the registrant.

.....

.....

Township 1 N Range 2 W, W.M.

North

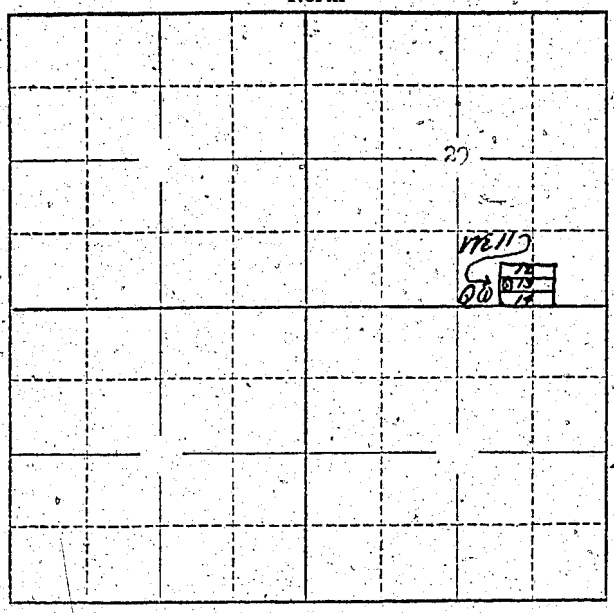

Locate well and acreage of irrigated land on plat.

Scale: 2" = 1 Mile

STATE OF OREGON
County of Washington } ss.

I, Wayne Peirce, being first duly sworn, do hereby certify that I have read the foregoing Registration Statement and that all of the items therein contained are true to the best of my knowledge and belief.

Wayne Peirce
(Signature of Registrant)

Subscribed and sworn to before me this 23 day of April, 1957

My commission expires Dec 7-1959 Clyde Grant
(Notary Public)

(SEAL)

CERTIFICATE OF REGISTRATION

STATE OF OREGON
County of Marion } ss.

This is to certify that the foregoing Registration Statement was received in the office of the State Engineer on the 3rd day of June, 1957, at 8:00 o'clock A. M. and has been duly recorded in said office in Book No. 3 of Registration Statements on page GR-485 C.

~~Construction shall be completed by X-X-X-X-X-X-X-X-X-19-X-X and the water completely applied to beneficial use by X-X-X-X-X-X-X-X-X-X-19-X-X~~

Witness my hand this 24th day of July, 1957

Lewis A. Stanley
(State Engineer)

$15.00

By
(Deputy)

- 485 C