

Registration Statement

OF CLAIMANT OF RIGHT TO APPROPRIATE GROUND WATER

(Under Chapter 708, Oregon Laws 1955.)

TO THE STATE ENGINEER OF OREGON:

I, Ward and Blanche Wallace
of Aumsville, Benton Co., Box 117 County of Union

State of Oregon, do hereby make application for a certificate of registration as evidence of a right to appropriate ground water.

1. Source from which water is withdrawn is Flowing Well
(Flowing well, pump well, infiltration trench or tunnel)

2. Location is: 4 miles S. W. of Staron
(Approximate distance and direction from nearest city or town)

and is more particularly described as follows:

(a) South 43° 13' East 21.67 chains from the North West Cor. of Sec. 30 T. 9 S. R. 17 W. E.
(Give distance and bearing to corner of section or other legal subdivision)

being within 1/4 of 34 of Sec. 30, Twp. 9 S, Rge. 17 W
(Smallest legal subdivision) (N. or S.) (E. or W.)

or (b) within limits of recorded platted property, town or city:

in Lot _____, Block _____ of _____
(Name of plat or addition)

County of _____
(If within city or town, give name)

3. Construction Work was begun on 1942; was completed on 1942
(Date) (Date)

and the ground water claimed was first used for the purposes set out below on 1942
(Date)

since which time the water has been used occasionally
(Continuously or Intermittently)

from May 25 to October 1
(Date) (Date)

4. Quantity of water claimed and used is 300 gallons per minute; 70 acre feet per year.

5. Purpose or Purposes for which water is used irrigation

(Domestic, irrigation, municipal, manufacturing, industrial, etc.)

6. Description of Well: Depth 26 feet. Type dug
(Dug or drilled)

diameter 10 inches. Elevation of ground at well site 300 feet, mean sea level.
(As near as known)

Depth to water table varies from 5' - 10' feet.

7. Capacity of Well: 300 g.p.m. with 10 feet drawdown.

_____ g.p.m. with _____ feet drawdown.

Date of test _____

If Flowing Well: Measured discharge _____ g.p.m. on _____
(Date)

Shut-in pressure at ground surface _____ lbs. per sq. in. on _____
(Date)

Water is controlled by _____
(Cap, valve, etc.)

8. Casing: (Give diameter, commercial specifications and depth below ground surface of each casing size.)

10 inch diameter from 00 to 25 feet
..... inch diameter from to feet
..... inch diameter from to feet
..... inch diameter from to feet

Describe and show depth of shoe, plug, adapter, liner or other details:

9. Perforated Casings or Screens:

do not know from to
(Number per foot and size of perforations, or describe screen)
..... from to
..... from to
..... from to

10. Log of Well: (Describe each stratum or formation clearly, indicate if water bearing, and give thickness and depth as indicated.)

MATERIAL	Thickness (Feet)	Depth to Bottom (Feet)
sandy soil	10'	10
river gravel	16	26'

If log of well is not available, give name and address of driller do not know

11. Infiltration Trench: Covered or open
Dimensions: Length ft. Minimum depth ft. Maximum depth ft.
Bottom width ft. Discharge g.p.m. Date of test

12. Tunnel: Type of lining
Dimensions:
(Length, course, and cross sectional size)
Position of water bearing stratum with reference to portal of tunnel

Log of tunnel: (Preceding table for log of well may be used, if desired. Give footage from portal and character of materials, as pertinent.)


13. Pumping Equipment:
(a) Pump Pacific Centrifugal Capacity 300 g.p.m.
(Make, type and size)
(b) Motor 15 H. P. Electric 3 phase
(Type and horsepower)

14. Location of area irrigated or to be irrigated, or place of use if for purposes other than irrigation.

Township North or South	Range E. or W. of Willamette Meridian	Section	Forty-acre Tract	Number Acres To Be Irrigated	Date of Reclamation
9 S	1 W	30		35	
"	"	"	NW ¹ / ₄ of NW ¹ / ₄	12.50	1942
"	"	"	SW ¹ / ₄ of NW ¹ / ₄	17.50	"
"	"	"	SE ¹ / ₄ of NW ¹ / ₄	5.00	"
				35.0 Total	

15. If the ground water supply is supplemental to an existing water supply, identification of any application for a permit, permit, certificate or adjudicated right to appropriate water made or held by the registrant.

Township 2 S Range 2 W, W.M.
North

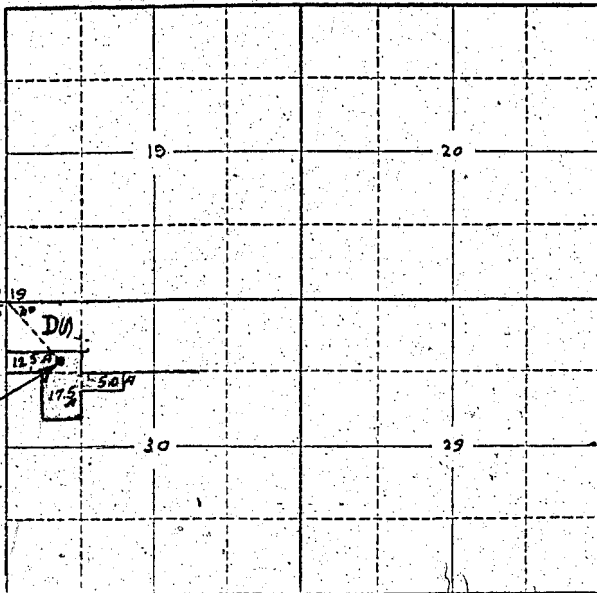

Locate well and acreage of irrigated land on plat.

Scale: 2" = 1 Mile

STATE OF OREGON

County of Marion

ss.

I, Fred Wallace & Blanche D. Wallace being first duly sworn, do hereby certify that I have read the foregoing Registration Statement and that all of the items therein contained are true to the best of my knowledge and belief.

Fred Wallace Blanche D. Wallace
(Signature of Registrant)

Subscribed and sworn to before me this 6 day of June, 1957.

My commission expires 8/21/58

Patricia H. Beale
(Notary Public)

(SEAL)

CERTIFICATE OF REGISTRATION

STATE OF OREGON

County of Marion

ss.

This is to certify that the foregoing Registration Statement was received in the office of the State Engineer on the 7th day of June, 1957, at 8:00 o'clock A. M. and has been duly recorded in said office in Book No. 3 of Registration Statements on page GR-488 C

~~Construction has been completed by X-X-X-X-X-X-X-X-X-X and the water completely applied to beneficial use by X-X-X-X-X-X-X-X-X-X~~

Witness my hand this 24th day of July, 1957.

15.75

Leuro A. Stanley
(State Engineer)

By _____
(Deputy)