

RECEIVED  
DEC 1 1955  
STATE ENGINEER  
SALEM, OREGON

REGISTRATION NO. GR-51  
CERTIFICATE NO. GR-43

# Registration Statement

OF CLAIMANT OF RIGHT TO APPROPRIATE GROUND WATER  
(Under Chapter 708, Oregon Laws 1955.)

TO THE STATE ENGINEER OF OREGON: #1

I, Sam Kennel  
of Rt. 1, Box 413, Albany County of Linn

State of Oregon, do hereby make application for a certificate of registration as evidence of a right to appropriate ground water.

1. Source from which water is withdrawn is pump well  
(Flowing well, pump well, infiltration trench, or tunnel)

2. Location is: 3 miles SE Albany, Oregon  
(Approximate distance and direction from nearest city or town)

and is more particularly described as follows:

(a) N. 14° E. 17 chains from the SE corner of the Edward N. White D.L.C. #18, T. 11 S., R. 3 W.W.M.  
(Give distance and bearing to corner of section or other legal subdivision)  
being within NE 1/4 of NW 1/4 of Sec. 15, Twp. 11 S., Rge. 3 W.  
(Smallest legal subdivision) (N. or S.) (E. or W.)

or (b) within limits of recorded platted property, town or city:

in Lot \_\_\_\_\_, Block \_\_\_\_\_ of \_\_\_\_\_  
(Name of plat or addition)

County of Linn  
(If within city or town, give name)

3. Construction Work was begun on Nov. 22, 1952; was completed on Dec. 5, 1952  
(Date) (Date)

and the ground water claimed was first used for the purposes set out below on May 10, 1953  
(Date)

since which time the water has been used continuously  
(Continuously or intermittently)

from May 10, 1953 to Sept. 15, 1955  
(Date) (Date)

4. Quantity of water claimed and used is 125 gallons per minute; 96 acre feet per year.

5. Purpose or Purposes for which water is used Irrigation

(Domestic, irrigation, municipal, manufacturing, industrial, etc.)

6. Description of Well: Depth 112 feet. Type drilled  
(Dug or drilled)

diameter 8 inches. Elevation of ground at well site 213 feet, mean sea level.  
(As near as known)

Depth to water table 18 feet.

7. Capacity of Well: 135 g.p.m. with 115 feet drawdown.

\_\_\_\_\_ g.p.m. with \_\_\_\_\_ feet drawdown.

Date of test Dec. 5, 1952

If Flowing Well: Measured discharge \_\_\_\_\_ g.p.m. on \_\_\_\_\_  
(Date)

Shut-in pressure at ground surface \_\_\_\_\_ lbs. per sq. in. on \_\_\_\_\_  
(Date)

Water is controlled by \_\_\_\_\_  
(Cap, valve, etc.)

8. Casing: (Give diameter, commercial specifications and depth below ground surface of each casing size.)

8 inch diameter steel casing from 0 to 132 feet  
 inch diameter from to feet  
 inch diameter from to feet  
 inch diameter from to feet

Describe and show depth of shoe, plug, adapter, liner or other details:

9. Perforated Casings or Screens:

3" slit perforations every foot from 75 to 110  
(Number per foot and size of perforations, or describe screen)  
 3" slit perforations every foot from 111 to 132  
 from to  
 from to

10. Log of Well: (Describe each stratum or formation clearly, indicate if water bearing, and give thickness and depth as indicated.)

MATERIAL	Thickness (Feet)	Depth to Bottom (Feet)
Light clay	0	14
Light gravel & clay	14	33
Light sand, gravel & clay	33	49
Dark clay	49	80
Dark sand and clay	80	95
Dark clay	95	123
Dark sand	123	130
Dark gravel	130	132
Dark clay and gravel	132	142

If log of well is not available, give name and address of driller. ....

11. Infiltration Trench: Covered or open .....

Dimensions: Length ..... ft. Minimum depth ..... ft. Maximum depth ..... ft.  
 Bottom width ..... ft. Discharge ..... g.p.m. Date of test .....

12. Tunnel: Type of lining .....

Dimensions: .....  
(Length, course, and cross sectional size)  
 Position of water bearing stratum with reference to portal of tunnel .....

Log of tunnel: (Preceding table for log of well may be used, if desired. Give footage from portal and character of materials, as pertinent.)

13. Pumping Equipment:

(a) Pump Peerless deep well ..... Capacity ..... 150 ..... g.p.m.  
(Make, type and size)  
 (b) Motor 10 H. P. electric motor .....  
(Type and horsepower)

14. Location of area irrigated or to be irrigated, or place of use if for purposes other than irrigation.

Township North or South	Range E. or W. of Willamette Meridian	Section	Forty-acre Tract	Number Acres To Be Irrigated	Date of Reclamation
11 S.	3 W.	15	NE $\frac{1}{4}$ of NW $\frac{1}{4}$	12.0	Prior to <del>1900</del> May 10, 1953
11 S.	3 W.	15	NW $\frac{1}{4}$ of NW $\frac{1}{4}$	4.0	"
11 S.	3 W.	15	SW $\frac{1}{4}$ of NW $\frac{1}{4}$	3.5	"
11 S.	3 W.	15	SE $\frac{1}{4}$ of NW $\frac{1}{4}$	28.0	"
11 S.	3 W.	15	SW $\frac{1}{4}$ of NE $\frac{1}{4}$	0.5	"
				48.0	


145-581

Beginning at the Southeast corner of the D.L.C. of C.P. Burkhardt and wife Not. # 695 Cl. #46 in T. 11 S., R 3 W. of the Will. Mer. in Linn County, Ore; thence West 16.62 chains to the Southwest corner of the South projection of said Claim; thence North 13.70 chains to the Northwest corner of the South projection of said Claim; thence West 21.93 chains to the Southwest corner of said Cl.; thence North 43.48 chains to a point 34.00 chains South of the Northwest corner of said Cl; thence N. 89°40' E. 38.54 chains parallel with the North line of said Claim; thence South along the East line of said Claim 57.47 chains to the place of beginning and containing 192.00 acres All in Linn County, Oregon Excepting therefrom land deeded to S.S. Kennel and wife Vol. #130, Page 415

143-136

Beginning at the Southeast corner of the D.L.C. of Edward N. White #694 and Cl. #48 in T. 11 S., R 3 W. and running thence North on the Eastern boundary line of said D.L.C. a distance of 26.12 chains to the center of Market Road 9; thence North 59°30' W. along the center of said Market Road 6.06 chains; thence South parallel with the Eastern boundary line of said Cl. a distance of 308 chains to a point due West of the centerline of the intersection of Market Road 9 in Linn County, Oregon at the East boundary line of said Cl.; thence West 13.71 chains to an iron pin; thence S.26.12 chains to an iron pin on the South boundary line of said Cl. #48 thence East along the South boundary line of said Cl. 18.90 chains to the place of beginning containing 50.16 acres, more or less.

Township 11 S Range 3 W, W.M.  
North

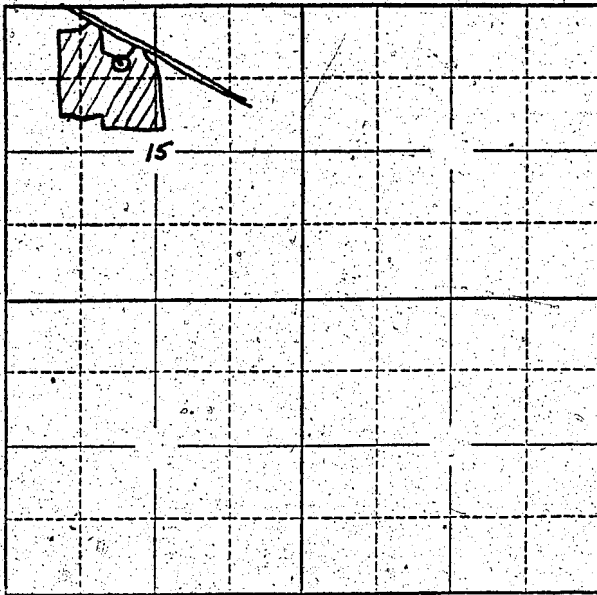

Locate well and acreage of irrigated land on plat.  
Scale: 2" = 1 Mile

STATE OF OREGON

County of Linn } ss.

I, Sam Kennel, being first duly sworn, do hereby certify that I have read the foregoing Registration Statement and that all of the items therein contained are true to the best of my knowledge and belief.

Sam Kennel  
(Signature of Registrant)

Subscribed and sworn to before me this 27th day of November, 1955.

My commission expires .....  
(SEAL) R. M. Russell, Clerk  
Ray H. Magat, Deputy  
(Notary Public)

**CERTIFICATE OF REGISTRATION**

STATE OF OREGON } ss.  
County of Marion

This is to certify that the foregoing Registration Statement was received in the office of the State Engineer on the 1st day of December, 1955, at 11:00 o'clock A. M. and has been duly recorded in said office in Book No. 1 of Registration Statements on page 43.

Construction shall be completed by 15 \_\_\_\_\_, 19\_\_\_\_, and the water 15 completely applied to beneficial use by \_\_\_\_\_, 19\_\_\_\_.

Witness my hand this 24th day of February, 1956.  
Lewis A. Stanley  
(State Engineer)

By \_\_\_\_\_  
(Deputy)