

Registration Statement

OF CLAIMANT OF RIGHT TO APPROPRIATE GROUND WATER

TO THE STATE ENGINEER OF OREGON:

I, Heyman-Campbell Farms

of Rt. 3, Bpx. 668, Albany County of Linn
(Mailing address)

State of Oregon, do hereby make application for a certificate of registration as evidence of a right to appropriate ground water.

1. Source from which water is withdrawn is gravel pit
(Flowing well, pump well, infiltration trench, or tunnel)

2. Location is: 2 miles west of Albany, Oregon
(Approximate distance and direction from nearest city or town)

and is more particularly described as follows:

(a) N. 76° W. 6.25 chains from the NE cor. DIC 57, T. 11 S, R. 1 W.
(Give distance and bearing to corner of section or other legal subdivision)

being within SE 1/4 of NW 1/4 of Sec. 11, Twp. 11 S, Rge. 1 W.
(Smallest legal subdivision) (N. or S.) (E. or W.)

or (b) within limits of recorded platted property, town or city:

in Lot _____, Block _____ of _____
(Name of plat or addition)

County of Linn
(If within city or town, give name)

3. Construction Work was begun on June 10, 1952; was completed on June 25, 1952
(Date) (Date)

and the ground water claimed was first used for the purposes set out below on June 30, 1952
(Date)

since which time the water has been used continuously
(Continuously or intermittently)

from June 30, 1952 to present time
(Date) (Date)

4. Quantity of water claimed and used is 400 gallons per minute; 107.75 acre feet per year.

5. Purpose or Purposes for which water is used Irrigation

(Domestic, irrigation, municipal, manufacturing, industrial, etc.)

6. Description of Well: Depth 26 feet. Type Dug
(Dug or drilled)

diameter 50 feet inches. Elevation of ground at well site 200 feet, mean sea level.
(As near as known)

Depth to water table 20 feet.

7. Capacity of Well: 400 g.p.m. with 1 feet drawdown.

_____ g.p.m. with _____ feet drawdown.


Date of test Not tested

If Flowing Well: Measured discharge _____ g.p.m. on _____
(Date)

Shut-in pressure at ground surface _____ lbs. per sq. in. on _____
(Date)

Water is controlled by _____
(Cap, valve, etc.)

Township 11 S Range 4 W, W.M.
North

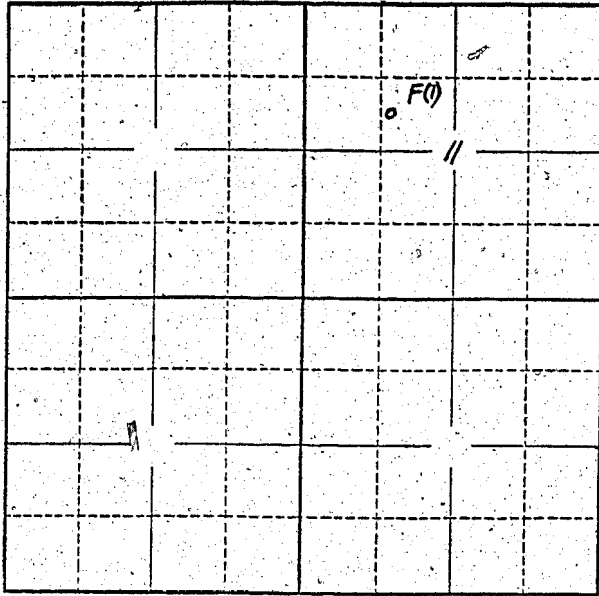

Locate well and acreage of irrigated land on plat.

Scale: 2" = 1 Mile

STATE OF OREGON

County of Linn } ss.

I, Lud Heyman, being first duly sworn, do hereby certify that I have read the foregoing Registration Statement and that all of the items therein contained are true to the best of my knowledge and belief.

Hayman-Campbell Farms
(Signature of Registrant)
By Lud Heyman

Subscribed and sworn to before me this 7th day of June, 1957.

My commission expires Sept 8, 1960

[Signature]
(Notary Public)

(SEAL)

CERTIFICATE OF REGISTRATION

STATE OF OREGON

County of Marion } ss.

This is to certify that the foregoing Registration Statement was received in the office of the State Engineer on the 17th day of June, 1957 at 10:30 o'clock A. M. and has been duly recorded in said office in Book No. 3 of Registration Statements on page GR-489C.

Witness my hand this 24th day of July, 1957.

7-10

Lewis A. Stanley
(State Engineer)

By _____
(Deputy)