

Registration Statement

OF CLAIMANT OF RIGHT TO APPROPRIATE GROUND WATER

(Under Chapter 708, Oregon Laws 1955.)

TO THE STATE ENGINEER OF OREGON:

I, W. E. and Betty Wallace

of Route 1, Box 117 Aumsville County of Marion

State of Oregon, do hereby make application for a certificate of registration as evidence of a right to appropriate ground water.

1. Source from which water is withdrawn is drill well
(Flowing well, pump well, infiltration trench, or tunnel)

2. Location is: 4 miles S. W. of Starbuck
(Approximate distance and direction from nearest city or town)

and is more particularly described as follows:

(a) S 73° 11 E 33.35 Rods from the N. W. corner Sec. 31 T. 9 S. R. 1 W. S. 11.
(Give distance and bearing to corner of section or other legal subdivision)

being within 1/4 of Sec. 30, Twp. 9 S., Rge. 2 W.
(Smallest legal subdivision) (N. or S.) (E. or W.)

or (b) within limits of recorded platted property, town or city:

in Lot _____, Block _____ of _____
(Name of plat or addition)

County of _____
(If within city or town, give name)

3. Construction Work was begun on 1948; was completed on 1948
(Date) (Date)

and the ground water claimed was first used for the purposes set out below on 1948
(Date)

since which time the water has been used continuously
(Continuously or Intermittently)

from 1948 to 1956
(Date) (Date)

4. Quantity of water claimed and used is 450 gallons per minute; 50 acre feet per year.

5. Purpose or Purposes for which water is used _____
(Domestic, irrigation, municipal, manufacturing, industrial, etc.)

6. Description of Well: Depth 19 feet. Type Drilled
(Dug or drilled)

diameter _____ inches. Elevation of ground at well site _____ feet, mean sea level.
(As near as known)

Depth to water table 5 to 10 feet.

7. Capacity of Well: _____ g.p.m. with 1.0 feet drawdown.
_____ g.p.m. with _____ feet drawdown.

Date of test May 1950

If Flowing Well: Measured discharge _____ g.p.m. on _____
(Date)

Shut-in pressure at ground surface _____ lbs. per sq. in. on _____
(Date)

Water is controlled by _____
(Check, valve, etc.)

If log of well is not available, give name and address of driller. H. A. Robinson, Secon, Oregon

11. Infiltration Trench: Covered or open

Dimensions: Length ft. Minimum depth ft. Maximum depth ft.

Bottom width ft. Discharge g.p.m. Date of test

12. Tunnel: Type of lining

Dimensions:
(Length, course, and cross sectional size)

Position of water bearing stratum with reference to portal of tunnel

Log of tunnel: (Preceding table for log of well may be used, if desired. Give footage from portal and character of materials, as pertinent.)

13. Pumping Equipment:

(a) Pump Fairbanks Morris Centrifugal 2 1/2 x 4 1/2 Capacity 450 g.p.m.
(Make, type and size)


(b) Motor 15 H. P. Electric 3ph.
(Type and horsepower)

14. Location of area irrigated or to be irrigated, or place of use if for purposes other than irrigation.

Township North or South	Range E. or W. of Willamette Meridian	Section	Forty-acre Tract	Number Acres To Be Irrigated	Date of Reclamation
9 S	1 W	30	NE 1/4 of NE 1/4	11.92	1943
9 S	1 W	30	NE 1/4 of NW 1/4	16.00	1940

15. If the ground water supply is supplemental to an existing water supply, identification of any application for a permit, permit, certificate or adjudicated right to appropriate water made or held by the registrant.

Township 9 S Range 2 W, W.M.
North

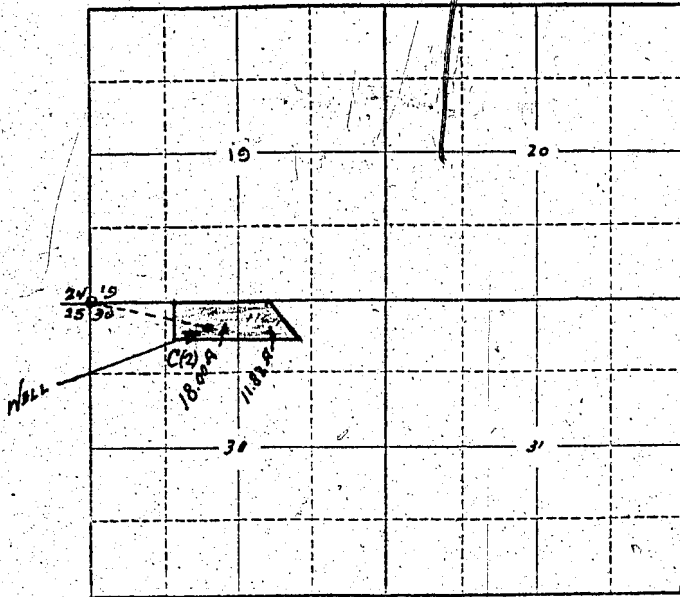

Locate well and acreage of irrigated land on plat.

Scale: 2" = 1 Mile

STATE OF OREGON

County of Marion } ss.

I, William E. Wallace, being first duly sworn, do hereby certify that I have read the foregoing Registration Statement and that all of the items therein contained are true to the best of my knowledge and belief.

William E. Wallace
(Signature of Registrant)

Subscribed and sworn to before me this 6 day of June, 1957.

My commission expires 8/21/58 Robert H. Beebe
(Notary Public)

(SEAL)

CERTIFICATE OF REGISTRATION

STATE OF OREGON } ss.
County of Marion

This is to certify that the foregoing Registration Statement was received in the office of the State Engineer on the 10th day of June, 1957, at 8:00 o'clock A.M. and has been duly recorded in said office in Book No. 3 of Registration Statements on page GR-492 C.

~~Construction shall be completed by X-X-X-X-X-X-X-X-X-X, and the water completely applied to the benefit of X-X-X-X-X-X-X-X-X-X.~~

Witness my hand this 24th day of July, 1957.
Lewis A. Stanley
(State Engineer)

By _____
(Deputy)