REGISTRATION NO. GR-565

CERTIFICATE NO. GR 493

Registration Statement

OF CLAIMANT OF RIGHT TO APPROPRIATE GROUND WATER

(Under Chapter 708, Oregon Laws 1955.)

TO THE STATE ENGINEER OF OREGON:

I, Oscar Heran 1165 Barns Ave,

of Salem County of Marion

State of Oregon, do hereby make application for a certificate of registration as evidence of a right to appropriate ground water.

1. **Source** from which water is withdrawn is Pump Well (Flowing well, pump well, infiltration trench, or tunnel)

2. **Location** is: 1/2 miles West of Talbot (Approximate distance and direction from nearest city or town);

and is more particularly described as follows:

(a) 395 ft. North 1216 ft. West center Sec. 25 (Give distance and bearing to corner of section or other legal subdivision)

being within S.E. 1/4 of N.W. 1/4 (Smallest legal subdivision) of Sec. 25, Twp. 9 S. (N. or S.), Rge. 4 W. (E. or W.)

or (b) within limits of recorded platted property, town or city:

in Lot ....., Block ..... of ..... (Name of plat or addition)

..... (If within city or town, give name) County of Marion

3. **Construction Work** was begun on May 1942 (Date); was completed on May 1942 (Date)

and the ground water claimed was first used for the purposes set out below on ..... (Date),

since which time the water has been used Continuously (Continuously or intermittently)

from 1942 (Date) to 1957 (Date)

4. **Quantity** of water claimed and used is 250 gallons per minute, 28/80 cu.ft. per sec. acre feet per year.

5. **Purpose or Purposes** for which water is used Irrigation

..... (Domestic, irrigation, municipal, manufacturing, industrial, etc.)

6. **Description of Well:** Depth 40 feet. Type drilled (Dug or drilled)

diameter 10 inches. Elevation of ground at well site 200. (estimate) (As near as known) feet, mean sea level.

Depth to water table 20 feet.

7. **Capacity of Well:** ..... g.p.m. with ..... feet drawdown.

..... g.p.m. with ..... feet drawdown.

Date of test .....

If Flowing Well: Measured discharge ..... g.p.m. on ..... (Date)

Shut-in pressure at ground surface ..... lbs. per sq. in. on ..... (Date)

Water is controlled by ..... (Cap, valve, etc.)

8. **Casing:** (Give diameter, commercial specifications and depth below ground surface of each casing size.)

..... inch diameter ..... from ..... to ..... feet

..... inch diameter ..... from ..... to ..... feet

..... inch diameter ..... from ..... to ..... feet

..... inch diameter ..... from ..... to ..... feet

Describe and show depth of shoe, plug, adapter, liner or other details: .....

.....

.....

9. **Perforated Casings or Screens:**

..... from ..... to .....
(Number per foot and size of perforations, or describe screen)

..... from ..... to .....

..... from ..... to .....

..... from ..... to .....

10. **Log of Well:** (Describe each stratum or formation clearly, indicate if water bearing, and give thickness and depth as indicated.)

MATERIAL	Thickness (Feet)	Depth to Bottom (Feet)
Not available		

If log of well is not available, give name and address of driller. unknown

11. **Infiltration Trench:** Covered or open .....

Dimensions: Length ..... ft. Minimum depth ..... ft. Maximum depth ..... ft.

Bottom width ..... ft. Discharge ..... g.p.m. Date of test .....

12. **Tunnel:** Type of lining .....

Dimensions: ..... (Length, course, and cross sectional size)

Position of water bearing stratum with reference to portal of tunnel .....

Log of tunnel: (Preceding table for log of well may be used, if desired. Give footage from portal and character of materials, as pertinent.)

13. **Pumping Equipment:**

(a) Pump F. Morse - Centrifugal (Make, type and size) Capacity ..... g.p.m.

(b) Motor 15 H. (Type and horsepower)

14. Location of area irrigated or to be irrigated, or place of use if for purposes other than irrigation.

Township North or South	Range E. or W. of Willamette Meridian	Section	Forty-acre Tract	Number Acres To Be Irrigated	Date of Reclamation
9 S.	4 W	25	S.E¼ N.W¼	24.80	May 1942
9 S.	4 W	25	S.W.¼ N.W¼	3.17	" "
				27.97 Ac	" "

15. If the ground water supply is supplemental to an existing water supply, identification of any application for a permit, permit, certificate or adjudicated right to appropriate water made or held by the registrant.

.....

.....

Township 9S Range 4W, W.M.

North

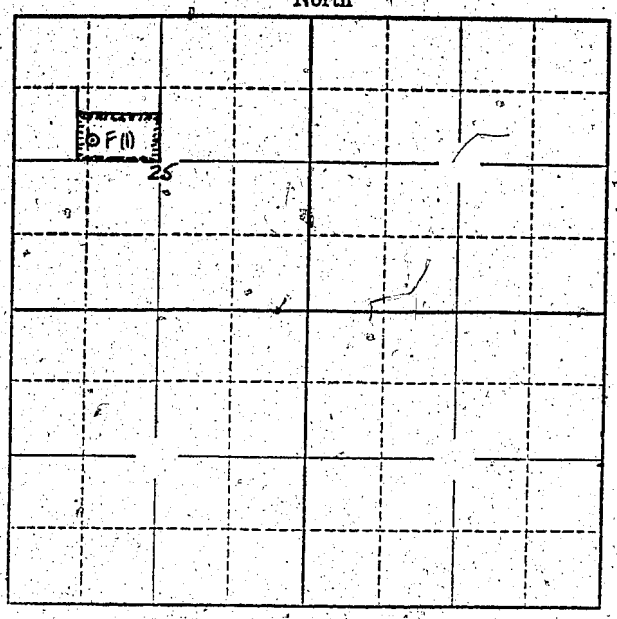

Locate well and acreage of irrigated land on plat.

Scale: 2" = 1 Mile

STATE OF OREGON
County of Marion } ss.

I, Oscar Hoven, being first duly sworn, do hereby certify that I have read the foregoing Registration Statement and that all of the items therein contained are true to the best of my knowledge and belief.

Oscar Hoven
(Signature of Registrant)

Subscribed and sworn to before me this 12th day of June, 19 57

My commission expires June 12th 1961

Wm. S. Bartholomew
(Notary Public)

(SEAL)

CERTIFICATE OF REGISTRATION

STATE OF OREGON
County of Marion } ss.

This is to certify that the foregoing Registration Statement was received in the office of the State Engineer on the 12th day of June, 19 57, at 10:00 o'clock A. M. and has been duly recorded in said office in Book No. 3 of Registration Statements on page GR-493 C

~~Construction shall be completed by x-x-x-x-x-x-x-x-x, 19xx, and the water completely applied to~~ beneficial use ~~by x-x-x-x-x-x-x-x-x, 19xx.~~

Witness my hand this 24th day of July, 19 57

Lewis A. Stanley
(State Engineer)

By
(Deputy)

GR-493 C