

# Registration Statement

## OF CLAIMANT OF RIGHT TO APPROPRIATE GROUND WATER

TO THE STATE ENGINEER OF OREGON:

I, George Stroda  
of Harrisburg County of Linn  
(Mailing address)

State of Oregon do hereby make application for a certificate of registration as evidence of a right to appropriate ground water.

1. Source from which water is withdrawn is Pump Well No. 1  
(Flowing well, pump well, infiltration trench, or tunnel)
2. Location is: 3 miles South of Harrisburg, Oregon  
(Approximate distance and direction from nearest city or town)

and is more particularly described as follows:

(a) S. 59° 50' W. 10 chains from NE corner of SE $\frac{1}{4}$  of S. 27, T. 15 S., R. 1 W.  
(Give distance and bearing to corner of section or other legal subdivision)  
being within NE $\frac{1}{4}$  of SE $\frac{1}{4}$  of Sec. 27, Twp. 15 S., Rge. 1 W.  
(Smallest legal subdivision) (N. or S.) (E. or W.)

or (b) within limits of recorded platted property, town or city:  
in Lot \_\_\_\_\_, Block \_\_\_\_\_ of \_\_\_\_\_  
(Name of plat or addition)  
County of Linn  
(If within city or town, give name)

3. Construction Work was begun on Jan. 15, 1952; was completed on Jan. 15, 1952  
(Date) (Date)  
and the ground water claimed was first used for the purposes set out below on April 20, 1952  
(Date)  
since which time the water has been used continuously  
(Continuously or Intermittently)  
from April 20, 1952 to present time  
(Date) (Date)

4. Quantity of water claimed and used is 250 gallons per minute; 13.0 acre  
feet per year.

5. Purpose or Purposes for which water is used Irrigation  
(Domestic, irrigation, municipal, manufacturing, industrial, etc.)

6. Description of Well: Depth 20 feet. Type Drilled  
(Dug or drilled)  
diameter 4 inches. Elevation of ground at well site 320 feet, mean sea level.  
(As near as known)  
Depth to water table 10 feet.

7. Capacity of Well: 500 g.p.m. with 1 feet drawdown.  
\_\_\_\_\_ g.p.m. with \_\_\_\_\_ feet drawdown.

Date of test Not tested - estimated

If Flowing Well: Measured discharge \_\_\_\_\_ g.p.m. on \_\_\_\_\_  
(Date)

Shut-in pressure at ground surface \_\_\_\_\_ lbs. per sq. in. on \_\_\_\_\_  
(Date)

Water is controlled by \_\_\_\_\_  
(Cap, valve, etc.)

8. Casing: (Give diameter, commercial specifications and depth below ground surface of each casing size.)

4 inch diameter steel casing from 0 to 20 feet  
 inch diameter from to feet  
 inch diameter from to feet  
 inch diameter from to feet

Describe and show depth of shoe, plug, adapter, liner or other details:

9. Perforated Casings or Screens:

slot perforations from 16 to 20  
 (Number per foot and size of perforations, or describe screen)  
 from to  
 from to  
 from to

10. Log of Well: (Describe each stratum or formation clearly, indicate if water bearing, and give thickness and depth as indicated.)

MATERIAL	Thickness (Feet)	Depth to Bottom (Feet)
Not available		

246-752.

beginning at the Southwest corner of David McCully's D.L.C. Lot. 2971 and claim No. 43, in T. 15 S., R. 4 W. of the Will. Mer. in Linn County, Oregon, thence East on the North boundary line of said Claim 54.84 chains to the East line of Section 15 in said T. and R., thence South on the East line of said Section and the East line of Section 22, 52.30 chains to the Southeast corner of the 3rd description set out in deed records of Vol. 157, page 505 in Linn County Deed records, thence West 32.61 chains to the center of the old county road, thence Northwesterly along the center of said old county road to a point S. 7° 30' E. 4.20 chains from the point of beginning, thence N. 7° 30' W. 4.20 chains to the place of beginning. EXCEPT 40.97 acres same being 22.94 chains East and West and 17.76 chains North and South in the Northeast corner of said land. Also Except the 3 feet leading to Linn County by deed recorded, Sept 27, Vol. 149 Linn County Deed records. Also, Beginning at the quarter section corner on the East side of section 27 in T. 15 S., R. 4 W. of the Will. Mer. in Linn County, Oregon; and running thence West 92 rods, thence South 40 rods, thence East 32 rods, thence South 40 rods, more or less, to the Northeast corner of land described in Book 133, page 10 of Linn County Deed records, thence West 16 chains, thence North to the Northeast corner of land described in Book 147, page 10 of Linn County Deed records, thence West to the Will. River, thence up the East bank of the Will. River to a point 12 chains West and 8 chains North of the Southeast corner of said Section; thence East to a point 21.85 chains West and 8 chains North from the Southeast corner of said Section 27, thence South 8 chains to the South line of said Section, thence East 25 rods, thence North 15 chains, thence East 15 chains, thence North 25 chains to the place of beginning. Also the North half of the South half of the Northwest quarter of section 29 in T. 15 S., R. 4 W. of the Will. Mer. in Linn County, Oregon, containing 40 acres, more or less. Also Except: Beginning at the quarter section corner on the East line of section 27 in said T. and R.; thence South to the center of Curtis Creek; thence Northward along the center of said creek to the East and West center lines of said section 27, thence West to the place of beginning.

If log of well is not available, give name and address of driller. George Stroda, Harrisburg, Ore.

11. Infiltration Trench: Covered or open .....

Dimensions: Length ..... ft. Minimum depth ..... ft. Maximum depth ..... ft.

Bottom width ..... ft. Discharge ..... g.p.m. Date of test .....

12. Tunnel: Type of lining .....

Dimensions: .....  
(Length, course, and cross sectional size)

Position of water bearing stratum with reference to portal of tunnel .....

Log of tunnel: (Preceding table for log of well may be used, if desired. Give footage from portal and character of materials, as pertinent.)

13. Pumping Equipment:

(a) Pump Berkeley 3" centrifugal Capacity 250 g.p.m.  
(Make, type and size)


(b) Motor 10 H. P. electric  
(Type and horsepower)

14. Location of area irrigated or to be irrigated, or place of use if for purposes other than irrigation.

Township North or South	Range E. or W. of Willamette Meridian	Section	Forty-acre Tract	Number Acres To Be Irrigated	Date of Reclamation
15 S	4 W.	27	NW $\frac{1}{4}$ of SE $\frac{1}{4}$	0.2	April 20, 1952
15 S	4 W.	27	NE $\frac{1}{4}$ of SE $\frac{1}{4}$	17.0	April 20, 1952
				17.2	

15. If the ground water supply is supplemental to an existing water supply, identification of any application for a permit, permit, certificate or adjudicated right to appropriate water made or held by the registrant.

Township 15 S Range 1 W. W.M.  
North

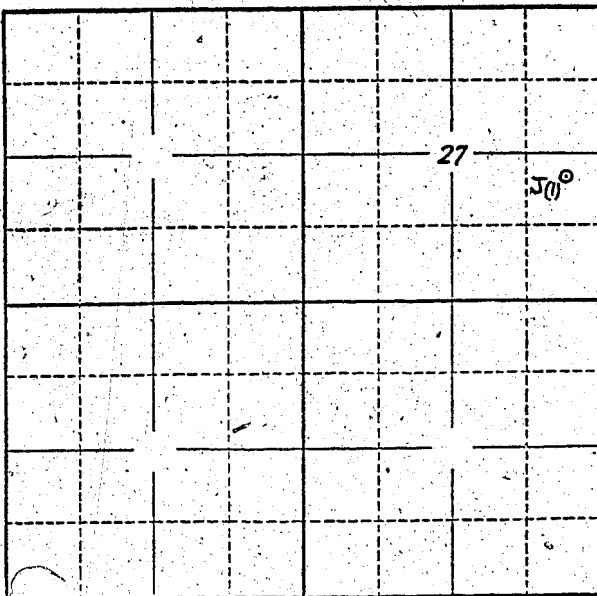

Locate well and acreage of irrigated land on plat.  
Scale: 2" = 1 Mile

STATE OF OREGON }  
County of Linn } ss.

I, George Stroda, being first duly sworn, do hereby certify that I have read the foregoing Registration Statement and that all of the items therein contained are true to the best of my knowledge and belief.

George Stroda  
(Signature of Registrant)

Subscribed and sworn to before me this 11th day of June, 1957.

My commission expires Oct 1, 1957  
Quinn K. Berlin  
(Notary Public)

(SEAL)

**CERTIFICATE OF REGISTRATION**

STATE OF OREGON }  
County of Marion } ss.

This is to certify that the foregoing Registration Statement was received in the office of the State Engineer on the 13th day of June, 1957, at 8:00 o'clock A. M. and has been duly recorded in said office in Book No. 3 of Registration Statements on page GR-494 C.

Witness my hand this 24th day of July, 1957.

Lewis A. Stanley  
(State Engineer)

By \_\_\_\_\_  
(Deputy)