

### Registration Statement

#### OF CLAIMANT OF RIGHT TO APPROPRIATE GROUND WATER

TO THE STATE ENGINEER OF OREGON:

I, Leo J. and Retta Lu Metcalf

of Rt. 3, Box 85 A, Seilo County of Linn  
(Mailing address)

State of Oregon, do hereby make application for a certificate of registration as evidence of a right to appropriate ground water.

1. Source from which water is withdrawn is Pump Well No. 1  
(Flowing well, pump well, infiltration trench, or tunnel)

2. Location is: 3 miles NW of Crabtree, Oregon  
(Approximate distance and direction from nearest city or town)

and is more particularly described as follows:

(a) S. 45° 45' W. 20.5 chains from NE corner of SE $\frac{1}{4}$  of S. 28, T. 10 S, R. 2 W.  
(Give distance and bearing to corner of section or other legal subdivision)  
being within NE $\frac{1}{4}$  of SE $\frac{1}{4}$  of Sec. 28, Twp. 10 S, Rge. 2 W  
(Smallest legal subdivision) (N. or S.) (E. or W.)

or (b) within limits of recorded platted property, town or city:

in Lot \_\_\_\_\_, Block \_\_\_\_\_ of \_\_\_\_\_  
(Name of plat or addition)

County of Linn  
(If within city or town, give name)

3. Construction Work was begun on May 15, 1947; was completed on May 17, 1947  
(Date) (Date)

and the ground water claimed was first used for the purposes set out below on June 15, 1947  
(Date)

since which time the water has been used continuously  
(Continuously or intermittently)

from June 15, 1947 to present time  
(Date) (Date)

4. Quantity of water claimed and used is 90 gallons per minute; 44 acre feet per year.

5. Purpose or Purposes for which water is used Irrigation

(Domestic, irrigation, municipal, manufacturing, industrial, etc.)

6. Description of Well; Depth 30 feet. Type Drilled  
(Dug or drilled)

diameter 12 inches. Elevation of ground at well site 225 feet, mean sea level.  
(As near as known)

Depth to water table 12 feet.

7. Capacity of Well: 90 g.p.m. with 12 feet drawdown.

\_\_\_\_\_ g.p.m. with \_\_\_\_\_ feet drawdown.

Date of test Not tested - estimated.

If Flowing Well: Measured discharge \_\_\_\_\_ g.p.m. on \_\_\_\_\_  
(Date)


Shut-in pressure at ground surface \_\_\_\_\_ lbs. per sq. in. on \_\_\_\_\_  
(Date)

Water is controlled by \_\_\_\_\_  
(Cap, valve, etc.)





Township 10 S Range 2 W. W.M.  
North

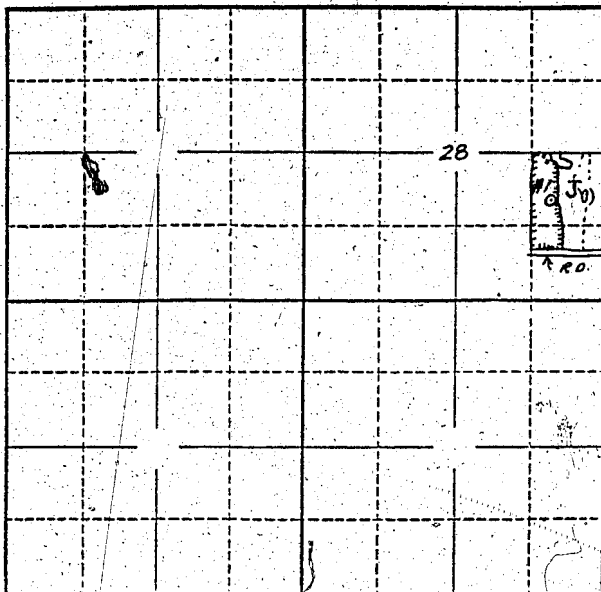

Locate well and acreage of irrigated land on plat.  
Scale: 2" = 1 Mile

STATE OF OREGON

County of Linn } ss.

I, Leo J. and Retta Lu Metcalf being first duly sworn, do hereby certify that I have read the foregoing Registration Statement and that all of the items therein contained are true to the best of my knowledge and belief.

Leo J. Metcalf  
Retta Lu Metcalf  
(Signature of Registrant)

Subscribed and sworn to before me this 14 day of June, 19 57

My commission expires 3/19/60

F. E. Druehler  
(Notary Public)

(SEAL)

**CERTIFICATE OF REGISTRATION**

STATE OF OREGON

County of Marion } ss.

This is to certify that the foregoing Registration Statement was received in the office of the State Engineer on the 18th day of June, 19 57, at 8:00 o'clock A. M. and has been duly recorded in said office in Book No. 3 of Registration Statements on page GR-502 C.

Witness my hand this 24th day of July, 19 57.

Lewis A. Stanley  
(State Engineer)

By \_\_\_\_\_ (Deputy)