

Registration Statement

OF CLAIMANT OF RIGHT TO APPROPRIATE GROUND WATER

TO THE STATE ENGINEER OF OREGON:

I, Stanley Sneed
of Box 73 Brooks County of Mayion
(Mailing address)

State of Oregon, do hereby make application for a certificate of registration as evidence of a right to appropriate ground water.

1. Source from which water is withdrawn is Pump Well
(Flowing well, pump well, infiltration trench, or tunnel)

2. Location is: 1 Mile North of Brooks
(Approximate distance and direction from nearest city or town)

and is more particularly described as follows:

(a) 800 ft. East and 500 ft. South from W 1/4 corner Section 9.
(Give distance and bearing to corner of section or other legal subdivision)

being within NW 1/4 of SW 1/4 of Sec. 9, Twp. 6S, Rge. 2W
(Smallest legal subdivision) (N. or S.) (E. or W.)

or (b) within limits of recorded platted property, town or city:

in Lot _____, Block _____ of _____
(Name of plat or addition)

County of _____
(If within city or town, give name)

3. Construction Work was begun on Aug. 3, 1954; was completed on Aug. 9, 1954
(Date) (Date)

and the ground water claimed was first used for the purposes set out below on Sept. 15, 1954
(Date)

since which time the water has been used Intermittently
(Continuously or Intermittently)

from Sept. 15, 1954 to Sept. 15, 1956
(Date) (Date)

4. Quantity of water claimed and used is 450 gallons per minute; _____ acre feet per year.

5. Purpose or Purposes for which water is used IRRIGATION

(Domestic, irrigation, municipal, manufacturing, industrial, etc.)

6. Description of Well: Depth 130 feet. Type Drilled
(Dug or drilled)

diameter 10 inches. Elevation of ground at well site _____ feet, mean sea level.
(As near as known)

Depth to water table 13 feet.

7. Capacity of Well: 573 g.p.m. with 36 feet drawdown.
Capacity of Pump Reached At 573 GPM
_____ g.p.m. with _____ feet drawdown.

Date of test Aug. 9, 1954

If Flowing Well: Measured discharge _____ g.p.m. on _____
(Date)

Shut-in pressure at ground surface _____ lbs. per sq. in. on _____
(Date)

Water is controlled by _____
(Cap, valve, etc.)

8. Casing: (Give diameter, commercial specifications and depth below ground surface of each casing size.)

1.0 inch diameter 32 lb. ga. CASING from 0 to 125 feet
 inch diameter from to feet
 inch diameter from to feet
 inch diameter from to feet

Describe and show depth of shoe, plug, adapter, liner or other details: Spring Steel 10"

9. Perforated Casings or Screens:

1.0 3/8 in. length 3" per ft. 8 ROWS from 88 ft. to 92 ft.
 (Number per foot and size of perforations, or describe screen)
 1.0 3/8 in. length 3" per ft. 25 ROWS from 103 ft. to 122 ft.
 TOTAL Perforations 330 from to
 SCREENS: NONE from to

10. Log of Well: (Describe each stratum or formation clearly, indicate if water bearing, and give thickness and depth as indicated.)

MATERIAL	Thickness (Feet)	Depth to Bottom (Feet)
Blue SHALE	5'	130'
Cemented Gravel	4'	125'
Water Gravel	2'	121'
Cemented Gravel Water BEARING	16'6"	119'
Blue CLAY	10'	102'6"
Cemented Gravel	6'	92'
Water Gravel	6"	86'
Cemented Gravel	1'6"	85'6"
Black FINE SAND	28'	84'
Blue Silt	24'	56'
Yellow Silt	30'	32'
Sub Soil	2'	2'

If log of well is not available, give name and address of driller. _____

11. Infiltration Trench: Covered or open

Dimensions: Length ft. Minimum depth ft. Maximum depth ft.

Bottom width ft. Discharge g.p.m. Date of test

12. Tunnel: Type of lining

Dimensions: _____
(Length, course, and cross sectional size)

Position of water bearing stratum with reference to portal of tunnel

Log of tunnel: (Preceding table for log of well may be used, if desired. Give footage from portal and character of materials, as pertinent.)

13. Pumping Equipment:

(a) Pump *Jacuzzi Turbine 8 stage* Capacity *500* g.p.m.


(b) Motor V.H.S. NON-Reverse 1750 RPM 3PH. 220V. 60 cpl.
(Type and horsepower)

14. Location of area irrigated or to be irrigated, or place of use if for purposes other than irrigation.

[illegible]

15. If the ground water supply is supplemental to an existing water supply, identification of any application for a permit, permit, certificate or adjudicated right to appropriate water made or held by the registrant.

Township 65 Range 2W, W.M.
North

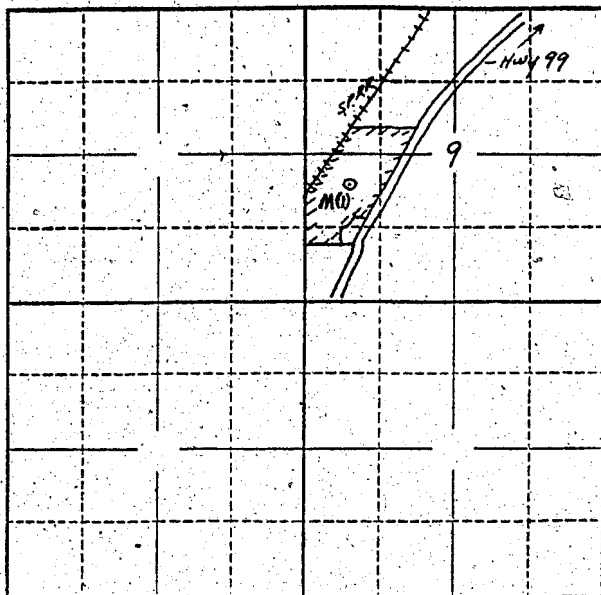

Locate well and acreage of irrigated land on plat.

Scale: 2" = 1 Mile

STATE OF OREGON

County of Marion

I, Stanley Sneed, being first duly sworn, do hereby certify that I have read the foregoing Registration Statement and that all of the items therein contained are true to the best of my knowledge and belief.

Stanley Sneed
(Signature of Registrant)

Subscribed and sworn to before me this 24th day of June, 1957.

My commission expires June 12th 1961

Wm. S. Bartholomew
(Notary Public)

(SEAL)

CERTIFICATE OF REGISTRATION

STATE OF OREGON

County of Marion

ss.

This is to certify that the foregoing Registration Statement was received in the office of the State Engineer on the 24th day of June, 1957, at 9:30 o'clock A.M. and has been duly recorded in said office in Book No. 3 of Registration Statements on page GR-506 C.

Witness my hand this 24th day of July, 1957.

Lewis A. Stanley
(State Engineer)

By

(Deputy)

GR 506 C