

Registration Statement

OF CLAIMANT OF RIGHT TO APPROPRIATE GROUND WATER

TO THE STATE ENGINEER OF OREGON:

I, Jacob Jager Jr
of Junction City County of Lane
(Mailing address)

State of Oregon, do hereby make application for a certificate of registration as evidence of a right to appropriate ground water.

1. Source from which water is withdrawn is Pump well
(Flowing well, pump well, infiltration trench, or tunnel)

2. Location is: 3.5 miles S.E. Junction City on Hayes Lane
(Approximate distance and direction from nearest city or town)

and is more particularly described as follows:

(a) about 446 ft East 294 ft South of 1/4 Sec. 10
(Give distance and bearing to corner of section of other legal subdivision)

being within N.W. 1/4 of the S.W. 1/4 of Sec. 10, Twp. 16, Rge. 4 W.
(Smallest legal subdivision) (N. or S.) (E. or W.)

or (b) within limits of recorded platted property, town or city:

in Lot _____, Block _____ of _____
(Name of plat or addition)

County of Lane
(If within city or town, give name)

3. Construction Work was begun on July 1948, was completed on July 1948
(Date) (Date)

and the ground water claimed was first used for the purposes set out below on Aug 1948
(Date)

since which time the water has been used intermittently
(Continuously or intermittently)

from Aug 1948 to Oct 1956
(Date) (Date)

4. Quantity of water claimed and used is 400 gallons per minute; 6 acre feet per year.

5. Purpose or Purposes for which water is used irrigation
(Domestic, irrigation, municipal, manufacturing, industrial, etc.)

6. Description of Well: Depth 21 feet. Type Pump well
(Dug or drilled)

diameter 4 inches. Elevation of ground at well site about 335 feet, mean sea level.
(As near as known)

Depth to water table about 7 feet.

7. Capacity of Well: 400 g.p.m. with not known feet drawdown.

_____ g.p.m. with _____ feet drawdown.


Date of test _____

If Flowing Well: Measured discharge _____ g.p.m. on _____
(Date)

Shut-in pressure at ground surface _____ lbs. per sq. in. on _____
(Date)

Water is controlled by _____
(Cap, valve, etc.)

Township 16 S Range 4 W, W.M.
North

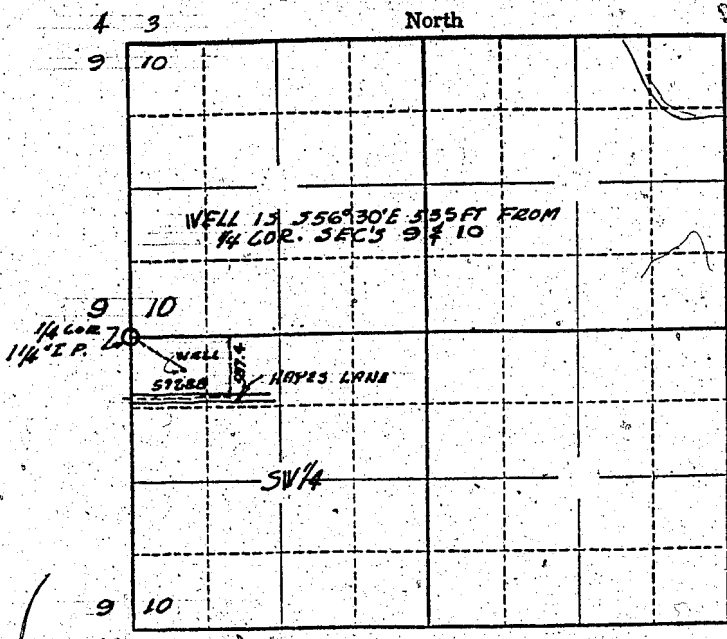

16 15 Locate well and acreage of irrigated land on plat.
Scale: ~~2 1/4~~ Mile
4 1/2

STATE OF OREGON }
County of Same } ss.

I, Jacob Jager Jr, being first duly sworn, do hereby certify that I have read the foregoing Registration Statement and that all of the items therein contained are true to the best of my knowledge and belief.

Jacob Jager Jr
(Signature of Registrant)

Subscribed and sworn to before me this 24th day of June, 1957

My commission expires March 13, 1961
Ernest M. Lane
(Notary Public)

(SEAL)

CERTIFICATE OF REGISTRATION

STATE OF OREGON }
County of Marion } ss.

This is to certify that the foregoing Registration Statement was received in the office of the State Engineer on the 25th day of June, 1957, at 8:00 o'clock A. M. and has been duly recorded in said office in Book No. 3 of Registration Statements on page GR-507 C.

Witness my hand this 24th day of July, 1957

Lewis A. Stanley
(State Engineer)

\$15.00

By _____ (Deputy)

GR - 502C