

RECEIVED
SEP 10 1956

STATE ENGINEER
SALEM, OREGON

Registration Statement

REGISTRATION NO. GR-520
CERTIFICATE NO. GR-574

OF CLAIMANT OF RIGHT TO APPROPRIATE GROUND WATER

(Under Chapter 703, Oregon Laws 1955.)

TO THE STATE ENGINEER OF OREGON:

I, George Zimmerman Rt. 3, Box 202
of Hillsboro County of Washington

State of Oregon, do hereby make application for a certificate of registration as evidence of a right to appropriate ground water.

1. Source from which water is withdrawn is pump well
(Flowing well, pump well, infiltration trench, or tunnel)

2. Location is: 2 miles north of Hillsboro
(Approximate distance and direction from nearest city or town)

and is more particularly described as follows:

(a) Jelly Donation Land Claim APPROX. 3300 feet south and 620 feet west of NE corner 24
* (Give distance and bearing to corner of section or other legal subdivision)

being within SE 1/4 of Sec. 24, Twp. 1 N, Rge. 3 W
(Smallest legal subdivision) (N. or S.) (E. or W.)

or (b) within limits of recorded platted property, town or city:

in Lot _____, Block _____ of _____
(Name of plat or addition)
County of Washington
(If within city or town, give name)

3. Construction Work was begun on June 1953; was completed on July 12, 1953
(Date) (Date)

and the ground water claimed was first used for the purposes set out below on July 12, 1953
(Date)

since which time the water has been used continuously
(Continuously or Intermittently)

from May to November of each year.
(Date) (Date)

4. Quantity of water claimed and used is 20 gallons per minute; 1 1/4 acre feet per year.

5. Purpose or Purposes for which water is used irrigation

(Domestic, irrigation, municipal, manufacturing, industrial, etc.)

6. Description of Well: Depth 60 feet. Type Drilled - Gravel Packed
(Dug or drilled)

diameter 6 inches. Elevation of ground at well site 200' 175' feet, mean sea level.
(As near as known)

Depth to water table 25 feet.

7. Capacity of Well: 20 g.p.m. with 15 feet drawdown.

_____ g.p.m. with _____ feet drawdown.


Date of test July 1953 & Aug. 1954

If Flowing Well: Measured discharge _____ g.p.m. on _____
(Date)

Shut-in pressure at ground surface _____ lbs. per sq. in. on _____
(Date)

Water is controlled by _____
(Cap, valve, etc.)

Township 1 N Range 3 W, W.M. North

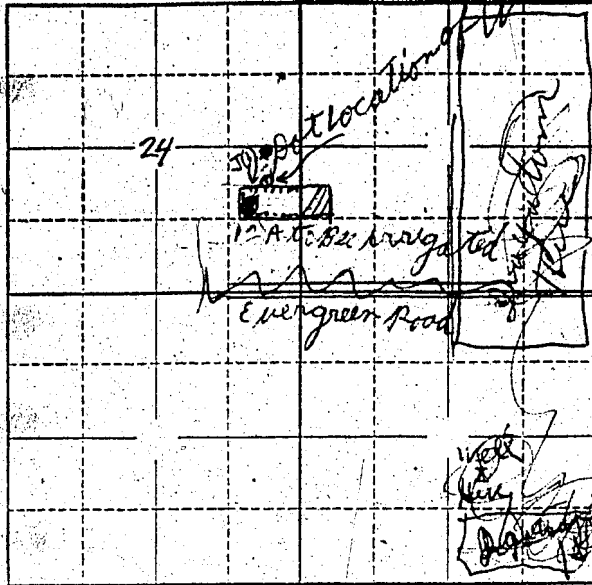

Locate well and acreage of irrigated land on plat,

Scale: 2" = 1 Mile

STATE OF OREGON

County of Washington

ss.

I, Geo. Zimmerman, being first duly sworn, do hereby certify that I have read the foregoing Registration Statement and that all of the items therein contained are true to the best of my knowledge and belief.

Geo. Zimmerman
(Signature of Registrant)

Subscribed and sworn to before me this 6th day of Sept, 1956

My commission expires 9-6-58

Walter Hinkle
(Notary Public)

(SEAL)

CERTIFICATE OF REGISTRATION

STATE OF OREGON

County of Marion

ss.

This is to certify that the foregoing Registration Statement was received in the office of the State Engineer on the 26th day of June, 1957, at 8:00 o'clock A. M. and has been duly recorded in said office in Book No. 4 of Registration Statements on page GR-574 C

~~Construction shall be completed by 10-1-58 and the water completely applied to beneficial use by 10-1-58~~

Witness my hand this 16th day of October, 1957

Lewis A. Stanley
(State Engineer)

15.00

By _____ (Deputy)

GR-574 C