

Registration Statement

OF CLAIMANT OF RIGHT TO APPROPRIATE GROUND WATER

TO THE STATE ENGINEER OF OREGON:

I, Hiram A. and Sadie Gregson
of Rt. 2, Box 242, Lebanon County of Linn
(Mailing address)

State of Oregon, do hereby make application for a certificate of registration as evidence of a right to appropriate ground water.

1. Source from which water is withdrawn is Pump Well No. 2
(Flowing well, pump well, infiltration trench, or tunnel)

2. Location is: 5 miles north of Lebanon, Oregon
(Approximate distance and direction from nearest city or town);

and is more particularly described as follows:

(a) N. 68° E. 35.5 chains from SW corner of SE $\frac{1}{4}$ of S. 23, T. 11 S; R. 2 W.
(Give distance and bearing to corner of section or other legal subdivision)

being within SE $\frac{1}{4}$ of SE $\frac{1}{4}$ of Sec. 23, Twp. 11 S., Rge. 2 W.
(Smallest legal subdivision) (N. or S.) (E. or W.)

or (b) within limits of recorded platted property, town or city:

in Lot, Block of (Name of plat or addition)

County of Linn
(If within city or town, give name)

3. Construction Work was begun on October 10, 1954 (Date) was completed on October 12, 1954 (Date)

and the ground water claimed was first used for the purposes set out below on July 2, 1955 (Date)

since which time the water has been used continuously (Continuously or intermittently)

from July 2, 1955 (Date) to present time (Date)

4. Quantity of water claimed and used is 200 gallons per minute 29.5 acre feet per year.

5. Purpose or Purposes for which water is used Irrigation

(Domestic, irrigation, municipal, manufacturing, industrial, etc.)

6. Description of Well: Depth 24 feet. Type Drilled
(Dug or drilled)

diameter 10 inches. Elevation of ground at well site 300 feet, mean sea level.
(As near as known)

Depth to water table 12 feet.

7. Capacity of Well: 250 g.p.m. with 1 feet drawdown.
g.p.m. with feet drawdown.

Date of test Not tested - estimated

If Flowing Well: Measured discharge g.p.m. on (Date)

Shut-in pressure at ground surface lbs. per sq. in. on (Date)

Water is controlled by (Cap, valve, etc.)

8. Casing: (Give diameter, commercial specifications and depth below ground surface of each casing size.)

10 inch diameter steel casing from 0 to 24 feet
inch diameter from to feet
inch diameter from to feet
inch diameter from to feet

Describe and show depth of shoe, plug, adapter, liner or other details:
.....

9. Perforated Casings or Screens:

Slot perforations from 18 to 24
(Number per foot and size of perforations, or describe screen)


from to
from to
from to
from to

10. Log of Well: (Describe each stratum or formation clearly, indicate if water bearing, and give thickness and depth as indicated.)

MATERIAL	Thickness (Feet)	Depth to Bottom (Feet)
Not available		

GR. R - 509 A

Township 11 S Range 2 W., W.M.
North

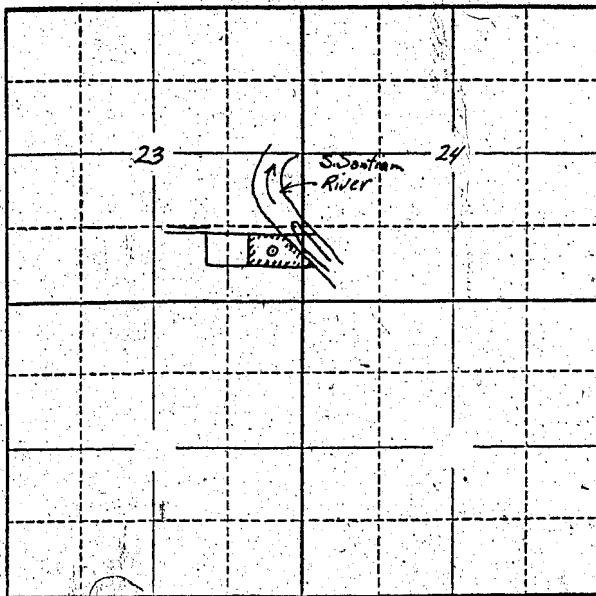

Locate well and acreage of irrigated land on plat.

Scale: 2" — 1 Mile

STATE OF OREGON

County of Linn } ss.

I, Hiram A. and Sadie Gregson, being first duly sworn, do hereby certify that I have read the foregoing Registration Statement and that all of the items therein contained are true to the best of my knowledge and belief.

Hiram A. Gregson
Sadie Gregson

(Signature of Registrant)

(Notary Public)

Subscribed and sworn to before me this 6th day of June, 1957.

My commission expires July 13, 1958

Alta Wilson

(SEAL)

CERTIFICATE OF REGISTRATION

STATE OF OREGON

County of Marion

} ss.

This is to certify that the foregoing Registration Statement was received in the office of the State Engineer on the 27th day of June, 1957, at 8:00 o'clock A.M. and has been duly recorded in said office in Book No. 3 of Registration Statements on page GR-509 C.

Witness my hand this 21st day of July, 1957.

Lewis A. Stanley

(State Engineer)

By

(Deputy)

GR - 509 C