Registration No. GR 535

Certificate No. GR- 616

Registration Statement

OF CLAIMANT OF RIGHT TO APPROPRIATE GROUND WATER

TO THE STATE ENGINEER OF OREGON:

I, Delbridge Holcomb

of Box 650 R1 (Mailing address) County of Lane

State of Ore, do hereby make application for a certificate of registration as evidence of a right to appropriate ground water.

1. **Source** from which water is withdrawn is Pump well (Flowing well, pump well, infiltration trench, or tunnel)

2. **Location** is: S ½ Mile S. W. Eugene (Approximate distance and direction from nearest city or town);

and is more particularly described as follows:

(a) 613 ft North and 1188 ft west from the S 1/4 corner of section 9 (Give distance and bearing to corner of section or other legal subdivision)

being within SE1/4 of the SW1/4 (Smallest legal subdivision) of Sec. 9, Twp. 17 S (N. or S.), Rge. 4 W (E. or W.)

or (b) within limits of recorded platted property, town or city:

in Lot ____, Block ____ of ____ (Name of plat or addition)

____ (If within city or town, give name) County of ____

3. **Construction Work** was begun on May 1955 (Date); was completed on May 22 55 (Date) and the ground water claimed was first used for the purposes set out below on May 23 1955 (Date), since which time the water has been used On Term Monthly (Continuously or intermittently) from May (Date) to Oct. (Date)

4. **Quantity** of water claimed and used is 120 gallons per minute; ~~[illegible]~~ acre feet per year.

5. **Purpose or Purposes** for which water is used Irrigation (Domestic, irrigation, municipal, manufacturing, industrial, etc.)

6. **Description of Well:** Depth 85 feet. Type drilled (Dug or drilled) diameter 6 inches. Elevation of ground at well site ~~[illegible]~~ 373 (As near as known) feet, mean sea level. Depth to water table 24 feet.

7. **Capacity of Well:** 110 g.p.m. with 16 feet drawdown.

____ g.p.m. with ____ feet drawdown.

Date of test May 21 55

If Flowing Well: Measured discharge ____ g.p.m. on ____ (Date)

Shut-in pressure at ground surface ____ lbs. per sq. in. on ____ (Date)

Water is controlled by ____ (Cap, valve, etc.)

4M—4-57

8. **Casing:** (Give diameter, commercial specifications and depth below ground surface of each casing size.)

6 inch diameter from Gp to 40 feet

..... inch diameter ..... from ..... to ..... feet

..... inch diameter ..... from ..... to ..... feet

..... inch diameter ..... from ..... to ..... feet

Describe and show depth of shoe, plug, adapter, liner or other details: .....

9. **Perforated Casings or Screens:**

..... from ..... to .....
(Number per foot and size of perforations, or describe screen)

..... from ..... to .....

..... from ..... to .....

..... from ..... to .....

10. **Log of Well:** (Describe each stratum or formation clearly, indicate if water bearing, and give thickness and depth as indicated.)

MATERIAL	Thickness (Feet)	Depth to Bottom (Feet)

GR-616 A

If log of well is not available, give name and address of driller. .....

Elvin F Deng old McKenzie Hy Springfield

11. **Infiltration Trench:** Covered or open .....

Dimensions: Length ..... ft. Minimum depth ..... ft. Maximum depth ..... ft.

Bottom width ..... ft. Discharge ..... g.p.m. Date of test .....

12. **Tunnel:** Type of lining .....

Dimensions: ..... (Length, course, and cross sectional size)

Position of water bearing stratum with reference to portal of tunnel .....

Log of tunnel: (Preceding table for log of well may be used, if desired. Give footage from portal and character of materials, as pertinent.)

* 13. **Pumping Equipment:**

(a) Pump Fairbanks Morse Pomona Turbine Capacity 120 g.p.m.
(Make, type and size)

(b) Motor Fairbanks Morse 5 horse power
(Type and horsepower)

14. Location of area irrigated or to be irrigated, or place of use if for purposes other than irrigation.

Township North or South	Range E. or W. of Willamette Meridian	Section	Forty-acre Tract	Number Acres To Be Irrigated	Date of Reclamation
17S	4W	9	SW1/4 SW1/4	9 ±	May 23, 1955
"	"	"	SE1/4 SW1/4	19 ±	" " "
				28 AC	

15. If the ground water supply is supplemental to an existing water supply, identification of any application for a permit, permit, certificate or adjudicated right to appropriate water made or held by the registrant.

.....

.....

Township 17 S Range 4W, W.M.

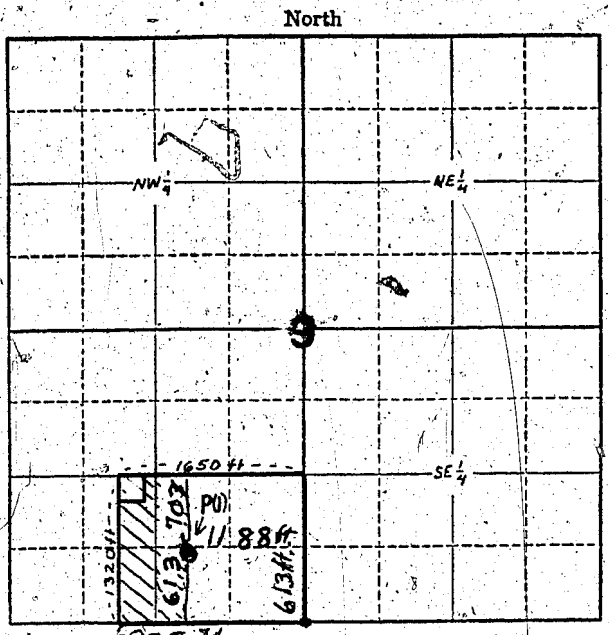

Locate well and acreage of irrigated land on plat.

Scale: 2" = 1 Mile

STATE OF OREGON
County of LANE } ss.

I, Deldridge Holcomb, being first duly sworn, do hereby certify that I have read the foregoing Registration Statement and that all of the items therein contained are true to the best of my knowledge and belief.

Deldridge Holcomb
(Signature of Registrant)

Subscribed and sworn to before me this 27th day of June, 1957.

My commission expires December 11th, 1958 Drew C. Davis
(Notary Public)

(SEAL)

CERTIFICATE OF REGISTRATION

STATE OF OREGON
County of Marion } ss.

This is to certify that the foregoing Registration Statement was received in the office of the State Engineer on the 1st day of July, 19 57, at 8:00 o'clock A. M. and has been duly recorded in said office in Book No. 4 of Registration Statements on page GR-616 C.

Witness my hand this 27th day of November, 19 57.

LEWIS A. STANLEY
(State Engineer)

By Max W. Rogers
(Deputy)

#15.00

GR - 616 C