

Registration Statement

OF CLAIMANT OF RIGHT TO APPROPRIATE GROUND WATER

TO THE STATE ENGINEER OF OREGON:

I, Clara C. Kizer

of 1805 Kenworthy Road, Albany County of Linn

(Mailing address)

State of Oregon, do hereby make application for a certificate of registration as evidence of a right to appropriate ground water.

1. Source from which water is withdrawn is Flowing well #1
(Flowing well, pump well, infiltration trench, or tunnel)

2. Location is: 6 1/2 miles NE of Albany, Oregon
(Approximate distance and direction from nearest city or town)

and is more particularly described as follows:

(a) N. 76° 13' W. 24.50 chains from SE corner of SW 1/4 of S. 11, T. 1 S, R. 1 W.
(Give distance and bearing to corner of section or other legal subdivision)

being within SW 1/4 of SW 1/4 of Sec. 11, Twp. 10 S, Rge. 3 W
(Smallest legal subdivision) (N. or S.) (E. or W.)

or (b) within limits of recorded platted property, town or city:

in Lot _____, Block _____ of _____
(Name of plat or addition)

County of Linn
(If within city or town, give name)

3. Construction Work was begun on June 15, 1955; was completed on June 17, 1955
(Date) (Date)

and the ground water claimed was first used for the purposes set out below on July 1, 1955
(Date)

since which time the water has been used continuously
(Continuously or intermittently)

from July 1, 1955 to present time
(Date) (Date)

4. Quantity of water claimed and used is 125 gallons per minute; 65.0 acre feet per year.

5. Purpose or Purposes for which water is used Irrigation

(Domestic, irrigation, municipal, manufacturing, industrial, etc.)

6. Description of Well: Depth 23 feet. Type Drilled
(Dug or drilled)

diameter 8 inches. Elevation of ground at well site 215 feet, mean sea level.
(As near as known)

Depth to water table 10 feet.

7. Capacity of Well: 250 g.p.m. with 10 feet drawdown.

 g.p.m. with feet drawdown.

Date of test Not Tested - Estimated

If Flowing Well: Measured discharge g.p.m. on (Date)

Shut-in pressure at ground surface lbs. per sq. in. on (Date)

Water is controlled by
(Cap, valve, etc.)

8. Casing: (Give diameter, commercial specifications and depth below ground surface of each casing size.)

8 inch diameter steel casing from 0 to 22 feet
 inch diameter from to feet
 inch diameter from to feet
 inch diameter from to feet

Describe and show depth of shoe, plug, adapter, liner or other details:

9. Perforated Casings or Screens:

Slot perforations from 16 to 22
(Number per foot and size of perforations, or describe screen)
 from to
 from to
 from to

10. Log of Well: (Describe each stratum or formation clearly, indicate if water bearing, and give thickness and depth as indicated.)

MATERIAL	Thickness (Feet)	Depth to Bottom (Feet)
Not available		

CLAUS THIESSEN ESTATE

Northwest Tract

Beginning at a 1/2" X 42" Iron bolt which is South 3.789 chains and West 39.457 chains from the Southeast corner of the Jacob L. Miller E.L.G. No. 61, in T.10 S., R.3 W. of the Will. Mer. in Linn County, Oregon; and running thence N.20° 41 1/2' W. 5.822 chains to a 1/2" Iron pipe, thence S.72° 30' W. 21.281 chains to a point in the center of a County Road from which point a 1/2" Iron pipe bears N.72° 30' E. 30.0 feet, thence N.20° 41 1/2' W. 8.099 chains along the center of said road to the Southerly right of way line of the Southern Pacific Railroad, thence N.65° 50' E. along said railroad line 23.620 chains to a 1/2" Iron bolt, thence S.42° 44' E. 18.431 chains to a 1/2" Iron pipe, thence S.72° 21' W. 9.270 chains to the place of beginning, containing 29.46 acres.

If log of well is not available, give name and address of driller. Bill Hamilton Well Drilling Co.

836 E. 3rd Avenue, Albany, Oregon

11. Infiltration Trench: Covered or open

Dimensions: Length ft. Minimum depth ft. Maximum depth ft.

Bottom width ft. Discharge g.p.m. Date of test

12. Tunnel: Type of lining

Dimensions:
(Length, course, and cross sectional size)

Position of water bearing stratum with reference to portal of tunnel

Log of tunnel: (Preceding table for log of well may be used, if desired. Give footage from portal and character of materials, as pertinent.)

13. Pumping Equipment:

(a) Pump 2" centrifugal Capacity 250 g.p.m.
(Make, type and size)


(b) Motor 15 H. P. electric
(Type and horsepower)

14. Location of area irrigated or to be irrigated, or place of use if for purposes other than irrigation.

Township North or South	Range E. or W. of Willamette Meridian	Section	Forty-acre Tract	Number Acres To Be Irrigated	Date of Reclamation
10 S	3 W	10	SE $\frac{1}{4}$ of SE $\frac{1}{4}$	6.8	July 1, 1955
10 S	3 W	11	SW $\frac{1}{4}$ of SW $\frac{1}{4}$	16.0	" "
10 S	3 W	14	NW $\frac{1}{4}$ of NW $\frac{1}{4}$	25	" "
10 S	3 W	15	NE $\frac{1}{4}$ of NE $\frac{1}{4}$	2.5	" "
				25.55	

15. If the ground water supply is supplemental to an existing water supply, identification of any application for a permit, permit, certificate or adjudicated right to appropriate water made or held by the registrant.

Township 10 S Range 3 W, W.M.
North

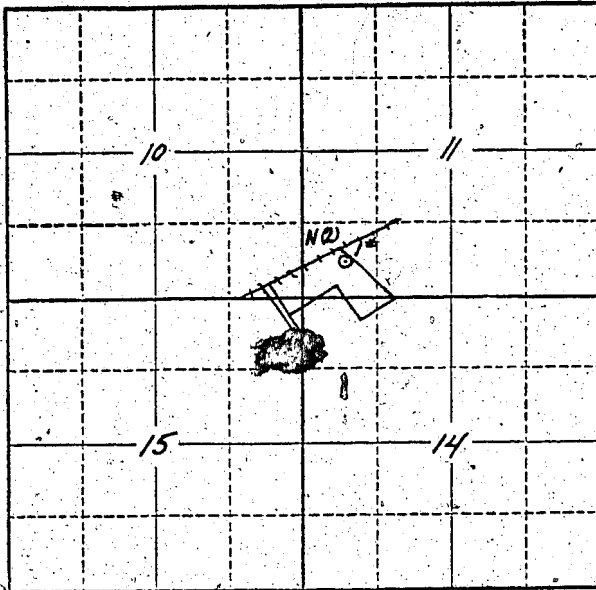

Locate well and acreage of irrigated land on plat.
Scale: 2" = 1 Mile

STATE OF OREGON

County of Linn } ss.

I, Clara C. Kizer, being first duly sworn, do hereby certify that I have read the foregoing Registration Statement and that all of the items therein contained are true to the best of my knowledge and belief.

Clara C. Kizer
(Signature of Registrant)

Subscribed and sworn to before me this July 1, 1957 day of July, 1957

My commission expires

W. H. Russell
(Notary Public)
Clara Magart
Deputy

(SEAL)

CERTIFICATE OF REGISTRATION

STATE OF OREGON

County of Marion } ss.

This is to certify that the foregoing Registration Statement was received in the office of the State Engineer on the 2nd day of July, 1957 at 8:00 o'clock A.M. and has been duly recorded in said office in Book No. 3 of Registration Statements on page GR-537 C.

Witness my hand this 13th day of September, 1957

Lewis A. Stanley
(State Engineer)

\$15.00

By _____ (Deputy)

GR - 537 C