

RECEIVED
MAY 24 1955
STATE ENGINEER
SALMON, OREGON

REGISTRATION NO. GR-37
CERTIFICATE NO. GR-46

Registration Statement

OF CLAIMANT OF RIGHT TO APPROPRIATE GROUND WATER

(Under Chapter 708, Oregon Laws 1955.)

TO THE STATE ENGINEER OF OREGON:

I, ELMER E. NUTTER
of PTL, WARREN County of Columbia

State of Oregon, do hereby make application for a certificate of registration as evidence of a right to appropriate ground water.

1. Source from which water is withdrawn is Pump Well
(Figuring well, pump well, infiltration trench, or tunnel)

2. Location is: 2 miles west Warren, Ore. on Church Road
(Approximate distance and direction from nearest city or town)

and is more particularly described as follows:

(a) 2 miles west Warren on Church Road
(Give distance and bearing to corner of section or other legal subdivision)

being within SW 1/4 NW 1/4 of Sec. 24, Twp. 4 N, Rge. 2 W. W. M.
(Smallest legal subdivision) (N. or S.) (E. or W.)

or (b) within limits of recorded platted property, town or city:

in Lot _____, Block _____ of _____
(Name of plat or addition)

(If within city or town, give name) _____ County of _____

3. Construction Work was begun on April 14th 1953, was completed on April 28 - 1953
(Date) (Date)

and the ground water claimed was first used for the purposes set out below on June - 1953
(Date)

since which time the water has been used Every Summer
(Continuously or intermittently)

from May to October
(Date) (Date)

4. Quantity of water claimed and used is 70 gallons per minute; _____ acre feet per year.

5. Purpose or Purposes for which water is used Irrigation

(Domestic, irrigation, municipal, manufacturing, industrial, etc.)

6. Description of Well: Depth 150 feet. Type Drilled
(Dug or drilled)

diameter 8 inches. Elevation of ground at well site 200 feet, mean sea level.
(As near as known)

Depth to water table 70 feet.

7. Capacity of Well: 70 g.p.m. with 75' feet drawdown.
75' g.p.m. with _____ feet drawdown.

Date of test April 20th 1953

If Flowing Well: Measured discharge _____ g.p.m. on _____ (Date)

Shut-in pressure at ground surface _____ lbs. per sq. in. on _____ (Date)

Water is controlled by _____ (Cap, valve, etc.)

8. Casing: (Give diameter, commercial specifications and depth below ground surface of each casing size.)

8 inch diameter from 0 to 150 feet
inch diameter from to feet
inch diameter from to feet
inch diameter from to feet

Describe and show depth of shoe, plug, adapter, liner or other details:
.....
.....

9. Perforated Casings or Screens:

~~None from to
(Number per foot and size of perforations, or describe screen)
from to
from to
from to~~

10. Log of Well: (Describe each stratum or formation clearly, indicate if water bearing, and give thickness and depth as indicated.)

MATERIAL	Thickness (Feet)	Depth to Bottom (Feet)
Not Available		

If log of well is not available, give name and address of driller: *Guy Luttrell*

St. Helens, Oregon

11. Infiltration Trench: Covered or open

Dimensions: Length ft. Minimum depth ft. Maximum depth ft.

Bottom width ft. Discharge g.p.m. Date of test

12. Tunnel: Type of lining

Dimensions:
(Length, course, and cross sectional size)

Position of water bearing stratum with reference to portal of tunnel

Log of tunnel: (Preceding table for log of well may be used, if desired. Give footage from portal and character of materials, as pertinent.)

13. Pumping Equipment:

(a) Pump *10 H.P. Deming Turbine* Capacity *100* g.p.m.
(Make, type and size)


(b) Motor *10 H.P. Deming*
(Type and horsepower)

14. Location of area irrigated or to be irrigated, or place of use if for purposes other than irrigation.

Township North or South	Range E. or W. of Willamette Meridian	Section	Forty-acre Tract	Number Acres To Be Irrigated	Date of Reclamation
<i>4 North</i>	<i>T. 11 N.</i>	<i>24</i>	<i>SW 1/4 of NW 1/4</i>	<i>20 acres</i>	<i>June 1953</i>

15. If the ground water supply is supplemental to an existing water supply, identification of any application for a permit, permit, certificate or adjudicated right to appropriate water made or held by the registrant.

Township 7 Range 24 N W.M.
North

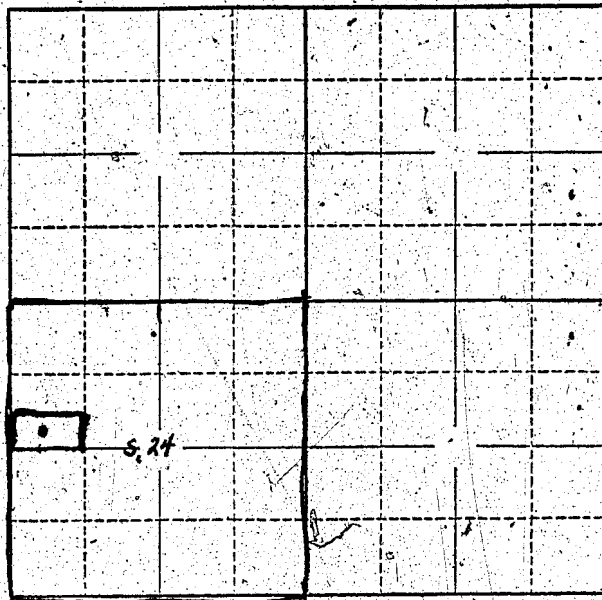

Locate well and acreage of irrigated land on plat.
Scale: 2" = 1 Mile

STATE OF OREGON

County of Marion

} ss.

I, Elery E. Nutter being first duly sworn, do hereby certify that I have read the foregoing Registration Statement and that all of the items therein contained are true to the best of my knowledge and belief.

Elery E. Nutter
(Signature of Registrant)

Subscribed and sworn to before me this 28th day of November, 19 55.

My commission expires 11/12/59

Charles Nelson
(Notary Public)

(SEAL)

CERTIFICATE OF REGISTRATION

STATE OF OREGON

County of Marion

} ss.

This is to certify that the foregoing Registration Statement was received in the office of the State Engineer on the 29th day of November, 19 55, at 8:00 o'clock A. M. and has been duly recorded in said office in Book No. 1 of Registration Statements on page 46

Construction shall be completed by _____, 19____, and the water completely applied to beneficial use by _____, 19____.

Witness my hand this 24th day of February, 19 56.

Lewis A. Stanley
(State Engineer)

By _____

(Deputy)