

Registration Statement

OF CLAIMANT OF RIGHT TO APPROPRIATE GROUND WATER

TO THE STATE ENGINEER OF OREGON:

I, Loren D. Croucher
of Route 1, Box 377-C, Medford County of Jackson
(Mailing address)
State of Oregon, do hereby make application for a certificate of registration as evidence of a right to appropriate ground water.

1. Source from which water is withdrawn is Infiltration trench
(Flowing well, pump well, infiltration trench, or tunnel)

2. Location is: 5 miles Southwest from Medford, Oregon
(Approximate distance and direction from nearest city or town)

and is more particularly described as follows:

(a) 150' S. and 340' E. from NW corner DIC No. 48
(Give distance and bearing to corner of section or other legal subdivision)

being within N₂ NW₄ SEC of Sec. 30, Twp. 38 S., Rge. 2 W.
(Smallest legal subdivision) (N. or S.) (E. or W.)

or (b) within limits of recorded platted property, town or city:

in Lot _____, Block _____ of _____
(Name of plat or addition)

County of _____
(If within city or town, give name)

3. Construction Work was begun on August 1954; was completed on August 1954
(Date) (Date)

and the ground water claimed was first used for the purposes set out below on April 1955
(Date)

since which time the water has been used continuously
(Continuously or intermittently)

from April 1955 to Date
(Date) (Date)

4. Quantity of water claimed and used is 36 gallons per minute; 9.0 acre feet per year.

5. Purpose or Purposes for which water is used irrigation

(Domestic, irrigation, municipal, manufacturing, industrial, etc.)

See Item 116. Description of Well: Depth 13 feet. Type dug
(Dug or drilled)

diameter 40' x 8' inches. Elevation of ground at well site 176.0 feet, mean sea level.
(As near as known)

Depth to water table 4.0 feet.

7. Capacity of Well: _____ g.p.m. with _____ feet drawdown.

_____ g.p.m. with _____ feet drawdown.


Date of test none

If Flowing Well: Measured discharge _____ g.p.m. on _____
(Date)

Shut-in pressure at ground surface _____ lbs. per sq. in. on _____
(Date)

Water is controlled by _____
(Cap, valve, etc.)

Township 38 S. Range 2 W., W.M.
North

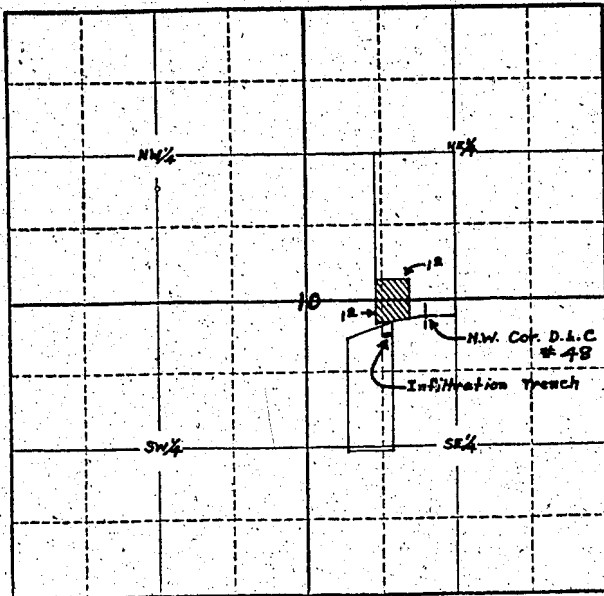

Locate well and acreage of irrigated land on plat.
Scale: 4" = 1 Mile

STATE OF OREGON

County of Jackson } ss.

I, Allen D. Croucher, being first duly sworn, do hereby certify that I have read the foregoing Registration Statement and that all of the items therein contained are true to the best of my knowledge and belief.

Allen D. Croucher
(Signature of Registrant)

Subscribed and sworn to before me this 1st day of July, 1957

My commission expires Nov. 23-1960

Ray Paul Reed
(Notary Public) for Oregon

(SEAL)

CERTIFICATE OF REGISTRATION

STATE OF OREGON

County of Marion } ss.

This is to certify that the foregoing Registration Statement was received in the office of the State Engineer on the 8th day of July, 1957, at 8:00 o'clock A.M. and has been duly recorded in said office in Book No. 3 of Registration Statements on page GR-516 C

Witness my hand this 21st day of July, 1957.

Lewis A. Stanley
(State Engineer)

By _____ (Deputy)