

Registration Statement

OF CLAIMANT OF RIGHT TO APPROPRIATE GROUND WATER

(Under Chapter 708, Oregon Laws 1955.)

TO THE STATE ENGINEER OF OREGON:

I, Cecil Watt
of Rt 1 Box 53 Breakings County of Curry
State of Oregon do hereby make application for a certificate of registration as evidence
of a right to appropriate ground water.

1. Source from which water is withdrawn is Pump well
(Flowing well, pump well, infiltration trench, or tunnel)

2. Location is: 3 mi S of Breakings Oreg
(Approximate distance and direction from nearest city or town)

and is more particularly described as follows:

(a) 717 ft S 6 405 ft E of NW Cor Sec 15
(Give distance and bearing to corner of section or other legal subdivision)

being within NW 1/4 NW 1/4 of Sec. 15, Twp. 41S, Rge. 13W W 1/4
(Smallest legal subdivision) (N. or S.) (E. or W.)

or (b) within limits of recorded platted property, town or city:

in Lot _____, Block _____ of does not apply
(Name of plat or addition)

County of _____
(If within city or town, give name)

3. Construction Work was begun on May 1948; was completed on May 1948
(Date) (Date)

and the ground water claimed was first used for the purposes set out below on June 1948
(Date)

since which time the water has been used continuously - in seasons
(Continuously or intermittently)

from June 1948 to June 1957 (present time)
(Date) (Date)

4. Quantity of water claimed and used is 100 gallons per minute; 24 acre
feet per year.

5. Purpose or Purposes for which water is used irrigation

(Domestic, irrigation, municipal, manufacturing, industrial, etc.)

6. Description of Well: Depth 44 feet. Type drilled
(Dug or drilled)

diameter 12 inches. Elevation of ground at well site 120 feet, mean sea level.
(As near as known)

Depth to water table 30 feet.

7. Capacity of Well: 100 g.p.m. with 10 feet drawdown.

_____ g.p.m. with _____ feet drawdown.

Test 1948 observed by pumping

g.p.m. on does not apply
Date _____

pressure at ground surface _____ lbs. per sq. in. on _____
(Date)

water is controlled by _____
(Cap, valve, etc.)

8. Casing: (Give diameter, commercial specifications and depth below ground surface of each casing size.)

12 inch diameter from 0 to 44 feet
 inch diameter from to feet
 inch diameter from to feet
 inch diameter from to feet

Describe and show depth of shoe, plug, adapter, liner or other details: none

9. Perforated Casings or Screens:

11 1/2" slots 6 per foot from 25 to 44
 (Number per foot and size of perforations, or describe screen)
 from to
 from to
 from to

10. Log of Well: (Describe each stratum or formation clearly, indicate if water bearing, and give thickness and depth as indicated.)

MATERIAL	Thickness (Feet)	Depth to Bottom (Feet)
Silty clay, gravel interspersed	10	10
yellow clay	20	30
mixed gravel & sand	14	44

If log of well is not available, give name and address of driller.

11. Infiltration Trench: ^{Does not apply} Covered or open

Dimensions: Length _____ ft. Minimum depth _____ ft. Maximum depth _____ ft.

Bottom width _____ ft. Discharge _____ g.p.m. Date of test _____

12. Tunnel: Type of lining Does not apply

Dimensions: _____
(Length, course, and cross sectional size)

Position of water bearing stratum with reference to portal of tunnel

Log of tunnel: (Preceding table for log of well may be used, if desired. Give footage from portal and character of materials, as pertinent.)

13. Pumping Equipment:

(a) Pump Percuss turbine Capacity 100 g.p.m.
(Make, type and size)

(b) Motor Electric - 5 hp
(Type and horsepower)


14. Location of area irrigated or to be irrigated, or place of use if for purposes other than irrigation.

Township North or South	Range E. or W. of Willamette Meridian	Section	Forty-acre Tract	Number Acres To Be Irrigated	Date of Reclamation
415	13 N.	10	SW 1/4 SW 1/4	5	1890 apply
415	13 N.	15	NW 1/4 NW 1/4	14	1890
415	13 N.	16	NE 1/4 NE 1/4	3	1890

15. If the ground water supply is supplemental to an existing water supply, identification of any application for a permit, permit, certificate or adjudicated right to appropriate water made or held by the registrant.

NONE

Township 41 S Range 13 W W.M.
North

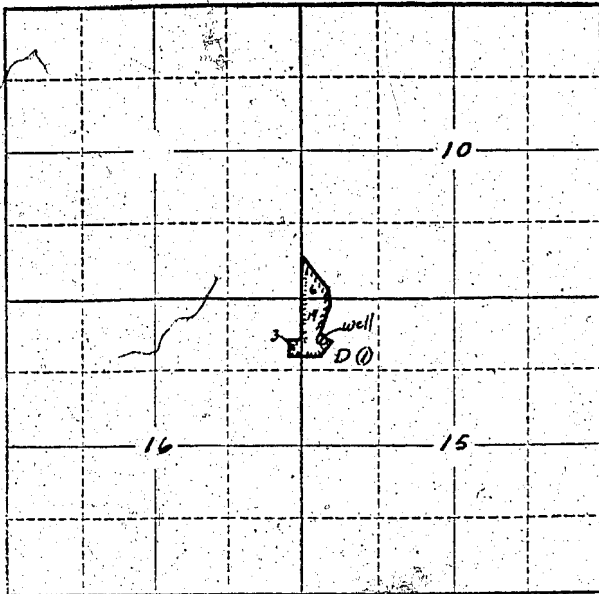

Locate well and acreage of irrigated land on plat.

Scale: 2" = 1 Mile

STATE OF OREGON

County of CURRY } ss.

I, C. P. WATT, being first duly sworn, do hereby certify that I have read the foregoing Registration Statement and that all of the items therein contained are true to the best of my knowledge and belief.

C. P. Watt
(Signature of Registrant)

Subscribed and sworn to before me this 20th day of June, 19 57.

My commission expires NOTARY PUBLIC FOR OREGON
My Commission Expires April 19, 1960

(SEAL)

CERTIFICATE OF REGISTRATION

STATE OF OREGON } ss.
County of Marion

This is to certify that the foregoing Registration Statement was received in the office of the State Engineer on the 9th day of July, 19 57 at 8:00 o'clock A.M. and has been duly recorded in said office in Book No. 3 of Registration Statements on page GR-517 C.

~~Construction shall be completed by X-X-X-X-X-X-X-X-X-X-X-X-X-X and the water completely applied to the field by X-X-X-X-X-X-X-X-X-X-X-X-X-X~~

Witness my hand this 24th day of July, 19 57.

Lewis A. Stanley
(State Engineer)

By _____ (Deputy)

GR - 517 C