

# Registration Statement

## OF CLAIMANT OF RIGHT TO APPROPRIATE GROUND WATER

TO THE STATE ENGINEER OF OREGON:

I, B. J. Dusebery and Dorothy M. Dusebery  
of Rt 4 Box 225 Salem, County of Marion  
(Mailing address)

State of Oregon, do hereby make application for a certificate of registration as evidence of a right to appropriate ground water.

- 1. Source from which water is withdrawn is pumped well  
(Flowing well, pump well, infiltration trench, or tunnel)
- 2. Location is: 5 miles south of Salem  
(Approximate distance and direction from nearest city or town)

and is more particularly described as follows:

(a) 2023 feet N and 532 feet E of S.W. Corner of Sec 15  
(Give distance and bearing to corner of section or other legal subdivision)  
being within NW 1/4 SW 1/4 of Sec. 15, Twp. 8 S, Rge. 3 W  
(Smallest legal subdivision) (N. or S.) (E. or W.)

or (b) within limits of recorded platted property, town or city: \_\_\_\_\_

in Lot \_\_\_\_\_, Block \_\_\_\_\_ of \_\_\_\_\_  
(Name of plat or addition)

County of \_\_\_\_\_  
(If within city or town, give name)

3. Construction Work was begun on July 1954; was completed on July 1954  
(Date) (Date)  
and the ground water claimed was first used for the purposes set out below on July 1954  
(Date)  
since which time the water has been used Continuously  
(Continuously or intermittently)

from July 1954 to September  
(Date) (Date)

4. Quantity of water claimed and used is 17 gallons per minute; 10 acre feet per year.

5. Purpose or Purposes for which water is used Irrigation  
(Domestic, irrigation, municipal, manufacturing, industrial, etc.)

6. Description of Well: Depth 99 feet. Type Drilled  
(Dug or drilled)  
diameter 6 inches. Elevation of ground at well site 550 feet, mean sea level.  
(As near as known)  
Depth to water table 50 feet. in July 1954

7. Capacity of Well: 18 g.p.m. with 32 feet drawdown.  
\_\_\_\_\_ g.p.m. with \_\_\_\_\_ feet drawdown.

Date of test July 1954

If Flowing Well: Measured discharge \_\_\_\_\_ g.p.m. on \_\_\_\_\_  
(Date)


Shut-in pressure at ground surface \_\_\_\_\_ lbs. per sq. in. on \_\_\_\_\_  
(Date)

Water is controlled by \_\_\_\_\_  
(Cap, valve, etc.)





Township 8S Range 3W, W.M.  
North

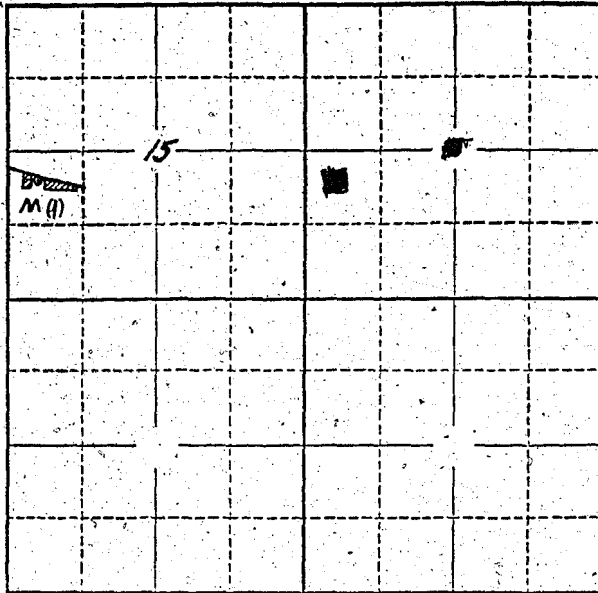

Locate well and acreage of irrigated land on plat.

Scale: 2" = 1 Mile

STATE OF OREGON

County of Marion } ss.

I, R. J. Rosenberg, being first duly sworn, do hereby certify that I have read the foregoing Registration Statement and that all of the items therein contained are true to the best of my knowledge and belief.

R. J. Rosenberg  
(Signature of Registrant)

Subscribed and sworn to before me this 9th day of July, 1957.

My commission expires September 2, 1961 M. S. Lewis  
(Notary Public)

(SEAL)

**CERTIFICATE OF REGISTRATION**

STATE OF OREGON }  
County of Marion } ss.

This is to certify that the foregoing Registration Statement was received in the office of the State Engineer on the 9th day of July, 1957, at 11:00 o'clock A.M. and has been duly recorded in said office in Book No. 3 of Registration Statements on page GR-519 C.

Witness my hand this 24th day of July, 1957.

\$15.00

Lewis A. Stanley  
(State Engineer)

By \_\_\_\_\_ (Deputy)

GR-519C