

Registration Statement

OF CLAIMANT OF RIGHT TO APPROPRIATE GROUND WATER

TO THE STATE ENGINEER OF OREGON:

I, Gilbert Sneed - 6448 Norway Rd. Dallas 30, Texas
of 2520 Blossom Drive Salem County of Marion
(Mailing address)

State of Oregon, do hereby make application for a certificate of registration as evidence of a right to appropriate ground water.

1. Source from which water is withdrawn is Pump Well
(Flowing well, pump well, infiltration trench, or tunnel)

2. Location is: 5 miles North of Salem
(Approximate distance and direction from nearest city or town)

and is more particularly described as follows:

(a) 549.62 feet N. and 97.68 feet East of Center Sec. 1
(Give distance and bearing to corner of section or other legal subdivision)
being within S.W.N.E. Quarter of Sec. 1, Twp. 7 S, Rge. 5 W
(Smallest legal subdivision) (N. or S.) (E. or W.)

or (b) within limits of recorded platted property, town or city:

in Lot _____, Block _____ of _____
(Name of plat or addition)

County of _____
(If within city or town, give name)

3. Construction Work was begun on 1/6/47; was completed on 1/10/47
(Date) (Date)

and the ground water claimed was first used for the purposes set out below on 4/47
(Date)

since which time the water has been used Continuously
(Continuously or intermittently)

from 4/47 to July 1957
(Date) (Date)

4. Quantity of water claimed and used is 200 gallons per minute; _____ acre feet per year.

5. Purpose or Purposes for which water is used Irrigation

(Domestic, irrigation, municipal, manufacturing, industrial, etc.)

6. Description of Well: Depth 103 feet. Type Drilled
(Dug or drilled)

diameter 8 inches. Elevation of ground at well site 160 feet, mean sea level.
(As near as known)

Depth to water table 28 feet.

7. Capacity of Well: 200 g.p.m. with 2 feet drawdown.

_____ g.p.m. with _____ feet drawdown.

Date of test 1/47

If Flowing Well: Measured discharge _____ g.p.m. on _____
(Date)

Shut-in pressure at ground surface _____ lbs. per sq. in. on _____
(Date)

Water is controlled by _____
(Cap, valve, etc.)

8. Casing: (Give diameter, commercial specifications and depth below ground surface of each casing size.)

8 inch diameter I.D. Steel from 0 to 103 feet
 inch diameter from to feet
 inch diameter from to feet
 inch diameter from to feet

Describe and show depth of shoe, plug, adapter, liner or other details:

9. Perforated Casings or Screens:

160 (Number per foot and size of perforations, or describe screen) from 62 to 68
 150 from 82 to 100
 from to
 from to



10. Log of Well: (Describe each stratum or formation clearly, indicate if water bearing, and give thickness and depth as indicated.)

MATERIAL	Thickness (Feet)	Depth to Bottom (Feet)
Top soil	0	3
Clay	3	29
Silt blue	29	39
Blue Clay	39	46
Gravel Cemented	46	52
Water, sand, gravel	52	54
Gravel cemented	54	62
Water gravel	62	103

If log of well is not available, give name and address of driller.....

11. Infiltration Trench: Covered or open

Dimensions: Length ft. Minimum depth ft. Maximum depth ft.

Bottom width ft. Discharge g.p.m. Date of test

12. Tunnel: Type of lining

Dimensions:
(Length, course, and cross sectional size)

Position of water bearing stratum with reference to portal of tunnel

Log of tunnel: (Preceding table for log of well may be used, if desired. Give footage from portal and character of materials, as pertinent.)

13. Pumping Equipment:

(a) Pump Jacuzzi Jet Capacity 400 g.p.m.
(Make, type and size)


(b) Motor 15 Elec. H.P. Motor
(Type and horsepower)

14. Location of area irrigated or to be irrigated, or place of use if for purposes other than irrigation.

Township North or South	Range E. or W. of Willamette Meridian	Section	Forty-acre Tract	Number Acres to Be Irrigated	Date of Reclamation
7 S	3 W	1	S.W. E.E	3 1/2	4/1947
7 S	3 W	1	N.W.S.E	3 1/2	" "
				<u>7 1/2 Acres</u>	" "
		Total		7 1/2	

15. If the ground water supply is supplemental to an existing water supply, identification of any application for a permit, permit, certificate or adjudicated right to appropriate water made or held by the registrant.

Township 7.5 Range 3W W.M.
North

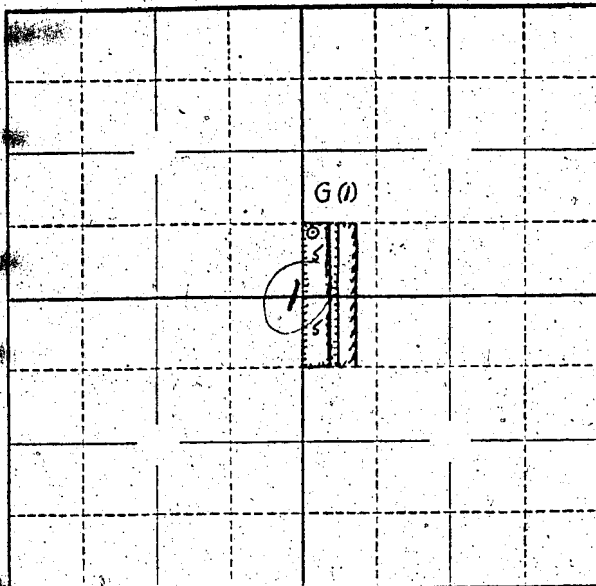

Locate well and acreage of irrigated land on plat.

Scale: $\frac{2''}{4} = 1$ Mile

STATE OF OREGON

County of Marion } ss.

I, Gilbert Sneed, being first duly sworn, do hereby certify that I have read the foregoing Registration Statement and that all of the items therein contained are true to the best of my knowledge and belief.

Gilbert Sneed
(Signature of Registrant)

Subscribed and sworn to before me this 10th day of July, 1957

My commission expires June 12, 1961

Wm. S. Bartholomew
(Notary Public)

(SEAL)

CERTIFICATE OF REGISTRATION

STATE OF OREGON

County of Marion } ss.

This is to certify that the foregoing Registration Statement was received in the office of the State Engineer on the 10th day of July, 1957, at 10:30 o'clock A. M. and has been duly recorded in said office in Book No. 3 of Registration Statements on page GR-520 C

Witness my hand this 21th day of July, 1957.

Lewis A. Stanley
(State Engineer)

By _____
(Deputy)

GR 520 C