

# Registration Statement

## OF CLAIMANT OF RIGHT TO APPROPRIATE GROUND WATER

### TO THE STATE ENGINEER OF OREGON:

I, Daniel O. Potter, City Recorder, City of Eugene, Lane County, Oregon  
of Eugene (Mailing address) County of Lane

State of Oregon, do hereby make application for a certificate of registration as evidence of a right to appropriate ground water.

1. Source from which water is withdrawn is pump well # 2  
(Flowing well, pump well, infiltration trench, or tunnel)

2. Location is: two miles North of present Eugene City Limits & approximately 2000 feet East of River Road, a State secondary highway  
(Give distance and direction from nearest city or town)  
and is more particularly described as follows:

(a) 881.28' N. and 2251.12' E. of the 1/4 Sec. Cor. btn. Secs. 13 & 14 T. 17 S., R. 4 W., Willamette Meridian  
(Give distance and bearing to corner of section or other legal subdivision)  
being within SE 1/4 of NW 1/4 of Sec. 13, Twp. 17 S., Rge. 4 W.  
(Smallest legal subdivision) (N. or S.) (E. or W.)

or (b) within limits of recorded platted property, town or city:  
in Lot \_\_\_\_\_, Block \_\_\_\_\_ of \_\_\_\_\_  
(Name of plat or addition)

County of \_\_\_\_\_  
(If within city or town, give name)

3. Construction Work was begun on September, 1952; was completed on September, 1953  
(Date) (Date)  
and the ground water claimed was first used for the purposes set out below on March, 1954  
(Date)

since which time the water has been used continuously  
(Continuously or intermittently)  
from March 1954 to Sept. 1956  
(Date) (Date)

4. Quantity of water claimed and used is 435 gallons per minute; \_\_\_\_\_ acre feet per year.

5. Purpose or Purposes for which water is used Municipal - Sewage Disposal Plant

6. Description of Well: Depth 26 feet. Type Drilled  
(Dug or drilled)  
diameter 2 1/2 inches. Elevation of ground at well site 327.75 feet, mean sea level.  
(As near as known)  
Depth to water table 10 - 11 feet.

7. Capacity of Well: \_\_\_\_\_ g.p.m. with \_\_\_\_\_ feet drawdown.  
Unlimited with present pumps - No appreciable drawdown  
\_\_\_\_\_ g.p.m. with \_\_\_\_\_ feet drawdown.

Date of test During construction of plant - 9000 gpm to drain excavation

If Flowing Well: Measured discharge \_\_\_\_\_ g.p.m. on \_\_\_\_\_  
(Date)


Shut-in pressure at ground surface \_\_\_\_\_ lbs. per sq. in. on \_\_\_\_\_  
(Date)

Water is controlled by \_\_\_\_\_  
(Cap, valve, etc.)





Township 17 S Range 4 W, W.M.  
North

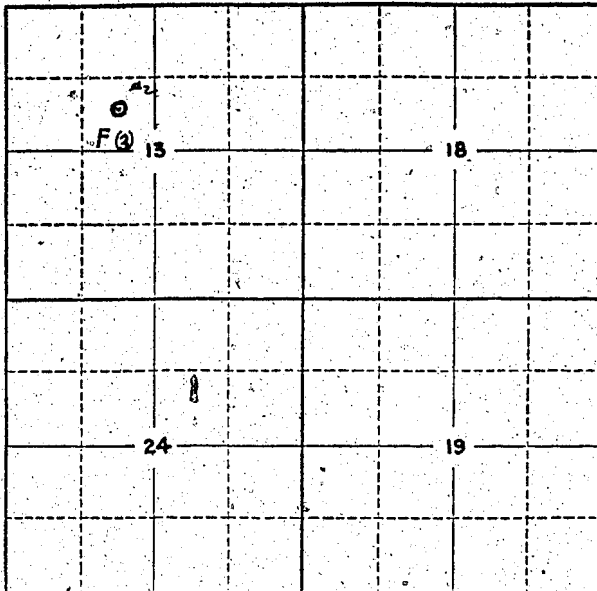

Locate well and acreage of irrigated land on plat.

Scale: 2" = 1 Mile

STATE OF OREGON

County of Lane } ss.

Daniel O. Potter, City Recorder

I, City of Eugene, Lane Co., Oregon, being first duly sworn, do hereby certify that I have read the foregoing Registration Statement and that all of the items therein contained are true to the best of my knowledge and belief.

*Daniel O. Potter*  
Daniel O. Potter, City Recorder, City of Eugene

Subscribed and sworn to before me this 2<sup>nd</sup> day of July, 1957

My commission expires Nov. 21, 1957

*Frank G. Gendry*  
(Notary Public)

(SEAL)

CERTIFICATE OF REGISTRATION

STATE OF OREGON } ss.  
County of Marion

This is to certify that the foregoing Registration Statement was received in the office of the State Engineer on the 11th day of July, 1957 at 8:00 o'clock A. M. and has been duly recorded in said office in Book No. 3 of Registration Statements on page GR-522 C

Witness my hand this 24th day of July, 1957

*Frank A. Standley*  
(State Engineer)

By \_\_\_\_\_ (Deputy)