

Registration Statement

OF CLAIMANT OF RIGHT TO APPROPRIATE GROUND WATER

TO THE STATE ENGINEER OF OREGON:

I, Paul Pierce
of 5615 N. River Road, Salem, County of Marion
State of Oregon, do hereby make application for a certificate of registration as evidence of a right to appropriate ground water.

1. Source from which water is withdrawn is Pump well
(Flowing well, pump well, infiltration trench, or tunnel)

2. Location is: 4 miles north of Salem
(Approximate distance and direction from nearest city or town)

and is more particularly described as follows:

(a) 1/2 mi. north, 1000 ft. west of SE corner of section 34
(Give distance and bearing to corner of section or other legal subdivision)
being within SW 1/4 of NE 1/4 of Sec. 34, Twp. 6 S, Rge. 3 W
(Smallest legal subdivision) (N. or S.) (E. or W.)

or (b) within limits of recorded platted property, town or city: _____

in Lot? _____, Block _____ of _____
(Name of plat or addition)

County of _____
(If within city or town, give name)

3. Construction Work was begun on unknown 1940; was completed on unknown
(Date) (Date)

and the ground water claimed was first used for the purposes set out below on 1940
(Date)

since which time the water has been used intermittently
(Continuously or Intermittently)

from about 1940 to 1953
(Date) (Date)

4. Quantity of water claimed and used is 125 gallons per minute; _____ acre feet per year.

5. Purpose or Purposes for which water is used: irrigation

(Domestic, irrigation, municipal, manufacturing, industrial, etc.)

6. Description of Well: Depth 33 feet. Type drilled
(Dug or drilled)

diameter 12 inches. Elevation of ground at well site 150 feet, mean sea level.
(As near as known)

Depth to water table _____ feet. 100 ft. distance to water level in pipe

7. Capacity of Well: 115 g.p.m. with 13 feet drawdown. pit
_____ g.p.m. with _____ feet drawdown.

Date of test: 1953


If Flowing Well: Measured discharge _____ g.p.m. on _____
(Date)

Shut-in pressure at ground surface _____ lbs. per sq. in. on _____
(Date)

Water is controlled by _____
(Cap, valve, etc.)

Township 6 S Range 3 W W.M.

Section 34 North

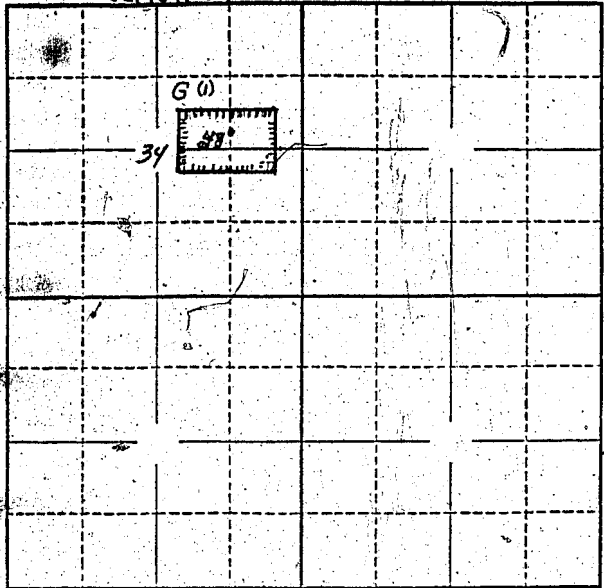

Locate well and acreage of irrigated land on plat.

Scale: 2" = 1 Mile

STATE OF OREGON

County of Marion } ss.

I, Paul Pierce, being first duly sworn, do hereby certify that I have read the foregoing Registration Statement and that all of the items therein contained are true to the best of my knowledge and belief.

Paul Pierce
(Signature of Registrant)

Subscribed and sworn to before me this 15th day of July, 1957.

My commission expires June 12, 1961

Wm. S. Bartholomew
(Notary Public)

(SEAL)

CERTIFICATE OF REGISTRATION

STATE OF OREGON

County of Marion } ss.

This is to certify that the foregoing Registration Statement was received in the office of the State Engineer on the 15th day of July, 1957, at 10:30 o'clock A. M. and has been duly recorded in said office in Book No. 3 of Registration Statements on page GR-523 C.

Witness my hand this 13th day of September, 1957.

Leura A. Stank
(State Engineer)

By _____ (Deputy)

#17.20